



WAN	
CIRCUIT ID	KXIP 200502
IP ADDRESS	10.227.151.1

"PLATFORM 1 HP ISDN"
020-8941-0361
"PLATFORM 2 HP ISDN"
020-8941-7688


All Equipment tags to be prefixed with "HMP-"

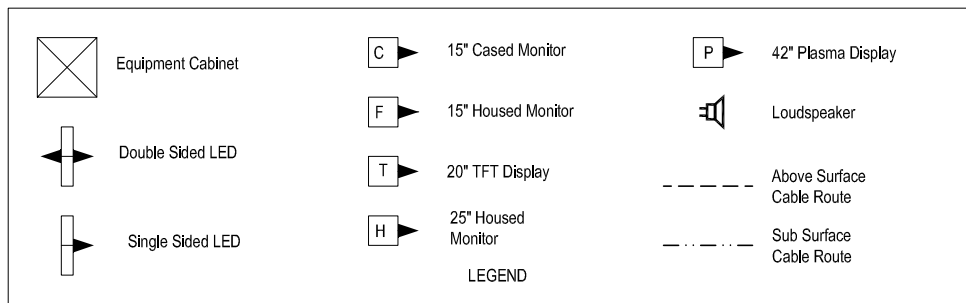

Equipment	Dist Board	
PT1-SSPI-001	GP1 DB1 CCT22	10A
PT1-SSPI-002	GP1 DB1 CCT22	10A
WR-HIDU-001	GP1 DB1 CCT21	10A
PT2-DSPI-003	GP1 DB1 CCT16	10A
CIS RACK	DB CCT5	15A

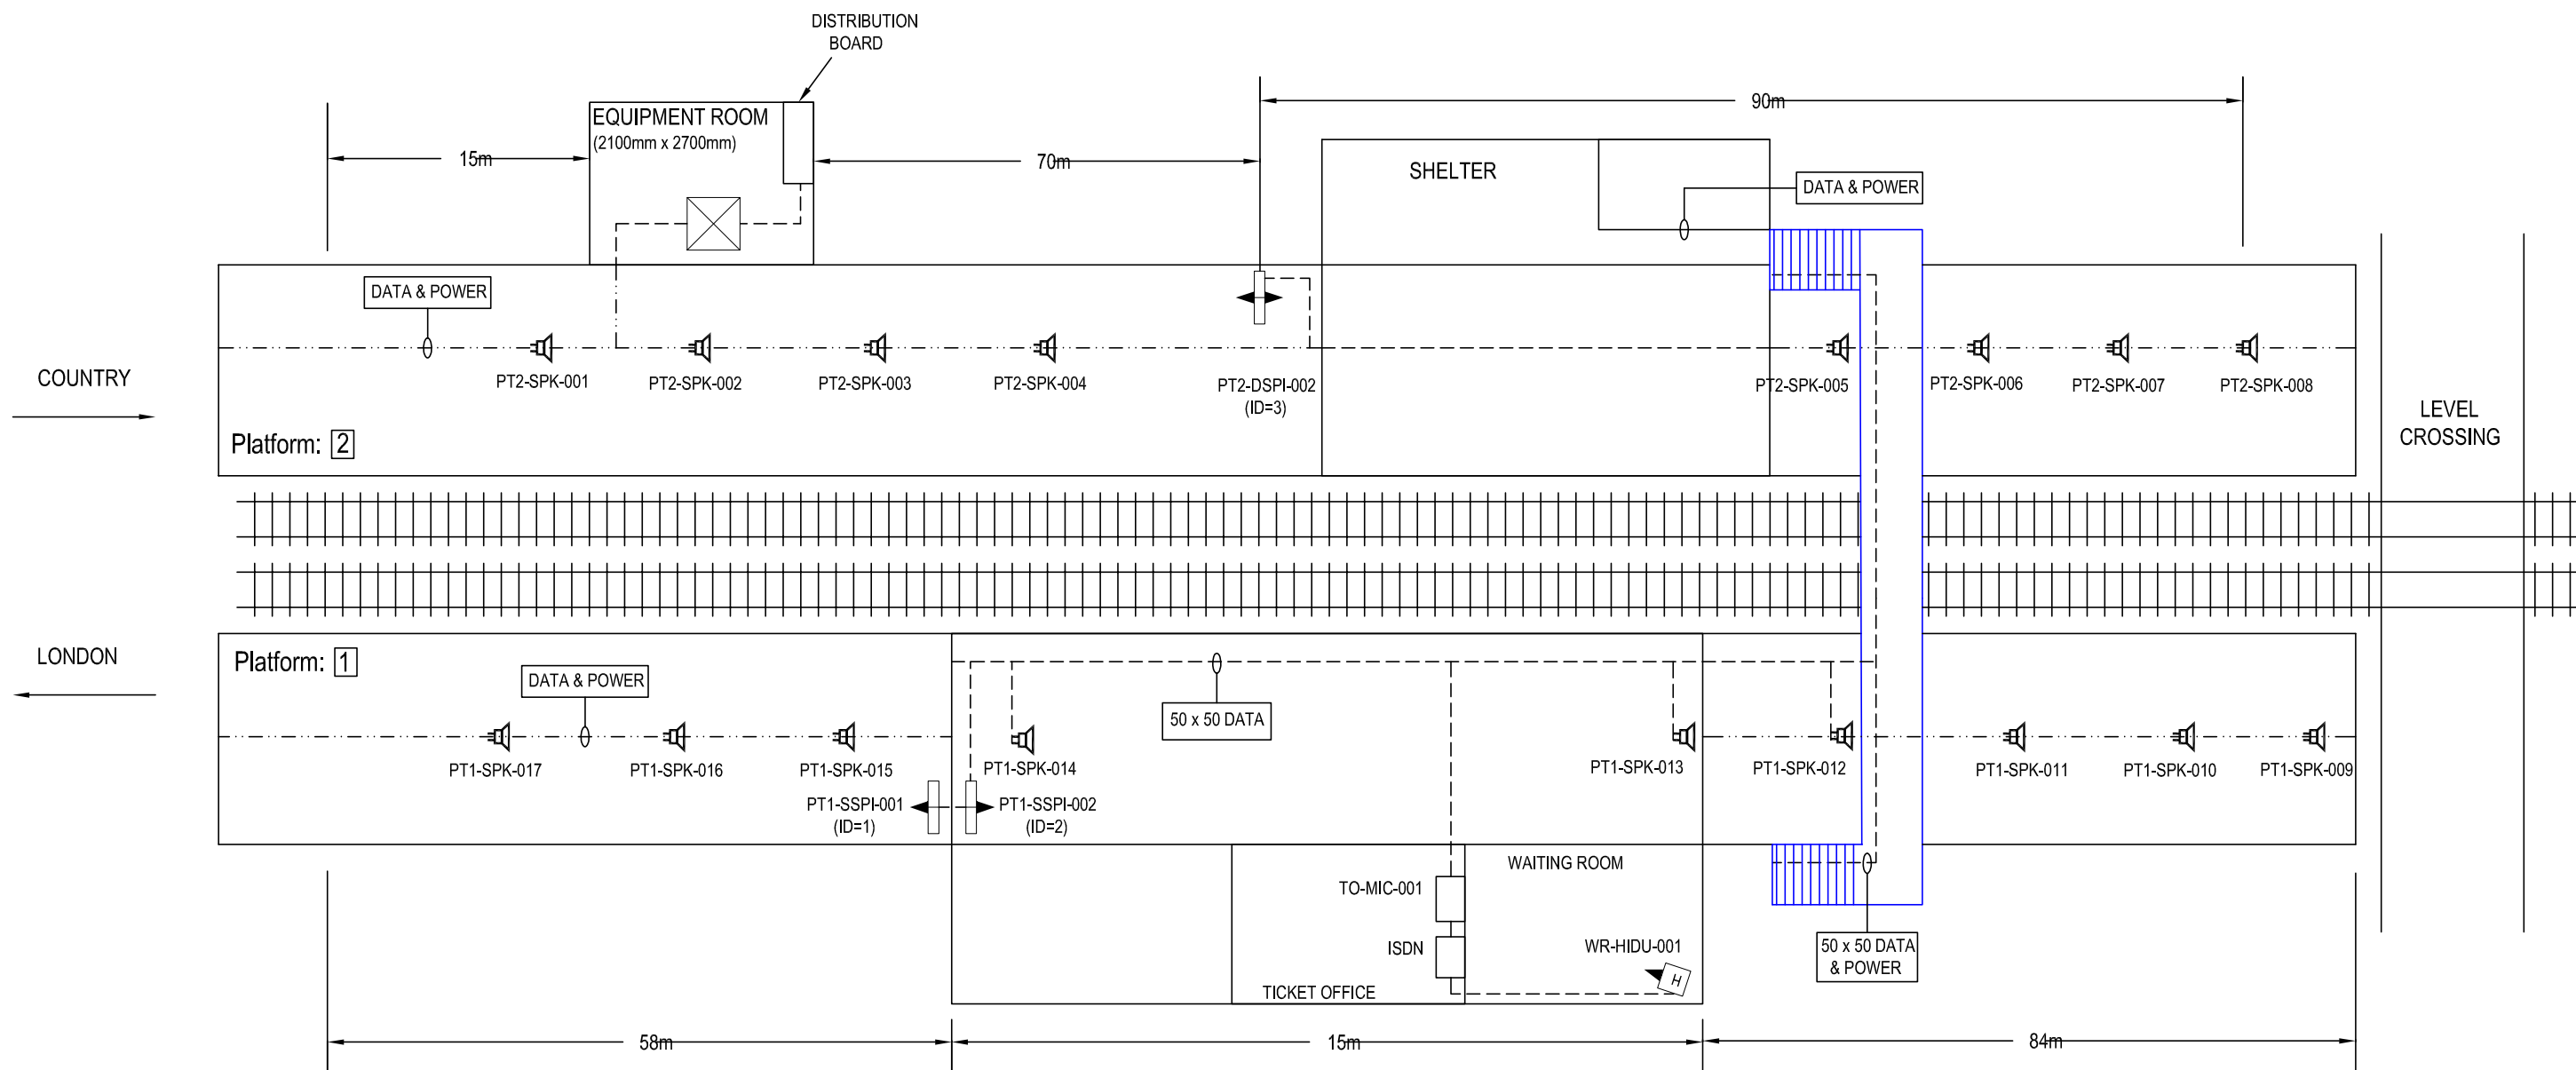

IF IN DOUBT ASK!

MATERIAL	CONSTRUCTION	NAME	SIGNATURE	DATE	 AMEY DATEL Project Offices 1st Floor, Platform 2/3 Eastleigh Station Southampton Road Eastleigh Hants SO50 9FL	SITE/PROJECT			
		DRAWN BY		21-05-2002		SOUTH WEST TRAINS CIS PROJECT			
FINISH	CONSTRUCTION	CHECKED BY			COPYRIGHT © AMEY Rail All rights reserved. Neither this drawing or any of the information it contains may be copied or communicated to third parties without the written permission of the copyright holder	TITLE			
		APPD BY				HAMPTON STATION AS BUILT			
		APPD BY				SCALE	DRG No.	ISSUE	SHEET
		CAD Ref:				NTS	SM803-75560	B	1 of 1
CONTRACTOR'S Ref:									