


SM803-75589


| | |
|------------|--------------|
| WAN | |
| CIRCUIT ID | KXIP 200491 |
| IP ADDRESS | 10.227.153.1 |

| |
|----------------------|
| "PLATFORM 1 HP ISDN" |
| 0208-9439808 |
| "PLATFORM 2 HP ISDN" |
| 0208-9439855 |

All Equipment tags to be prefixed with "HMW-"

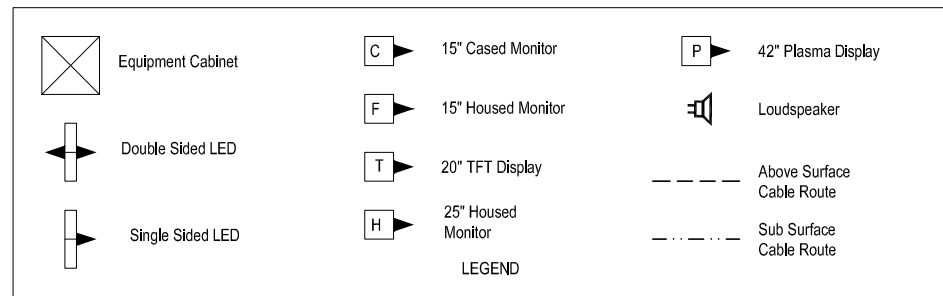

| Equipment | Dist Board | |
|--------------|-------------|-----|
| CIS RACK | DBCIS1 CCT1 | 16A |
| PT1-DSPI-001 | DBCIS1 CCT2 | 16A |
| PT2-DSPI-002 | DBCIS1 CCT3 | 16A |

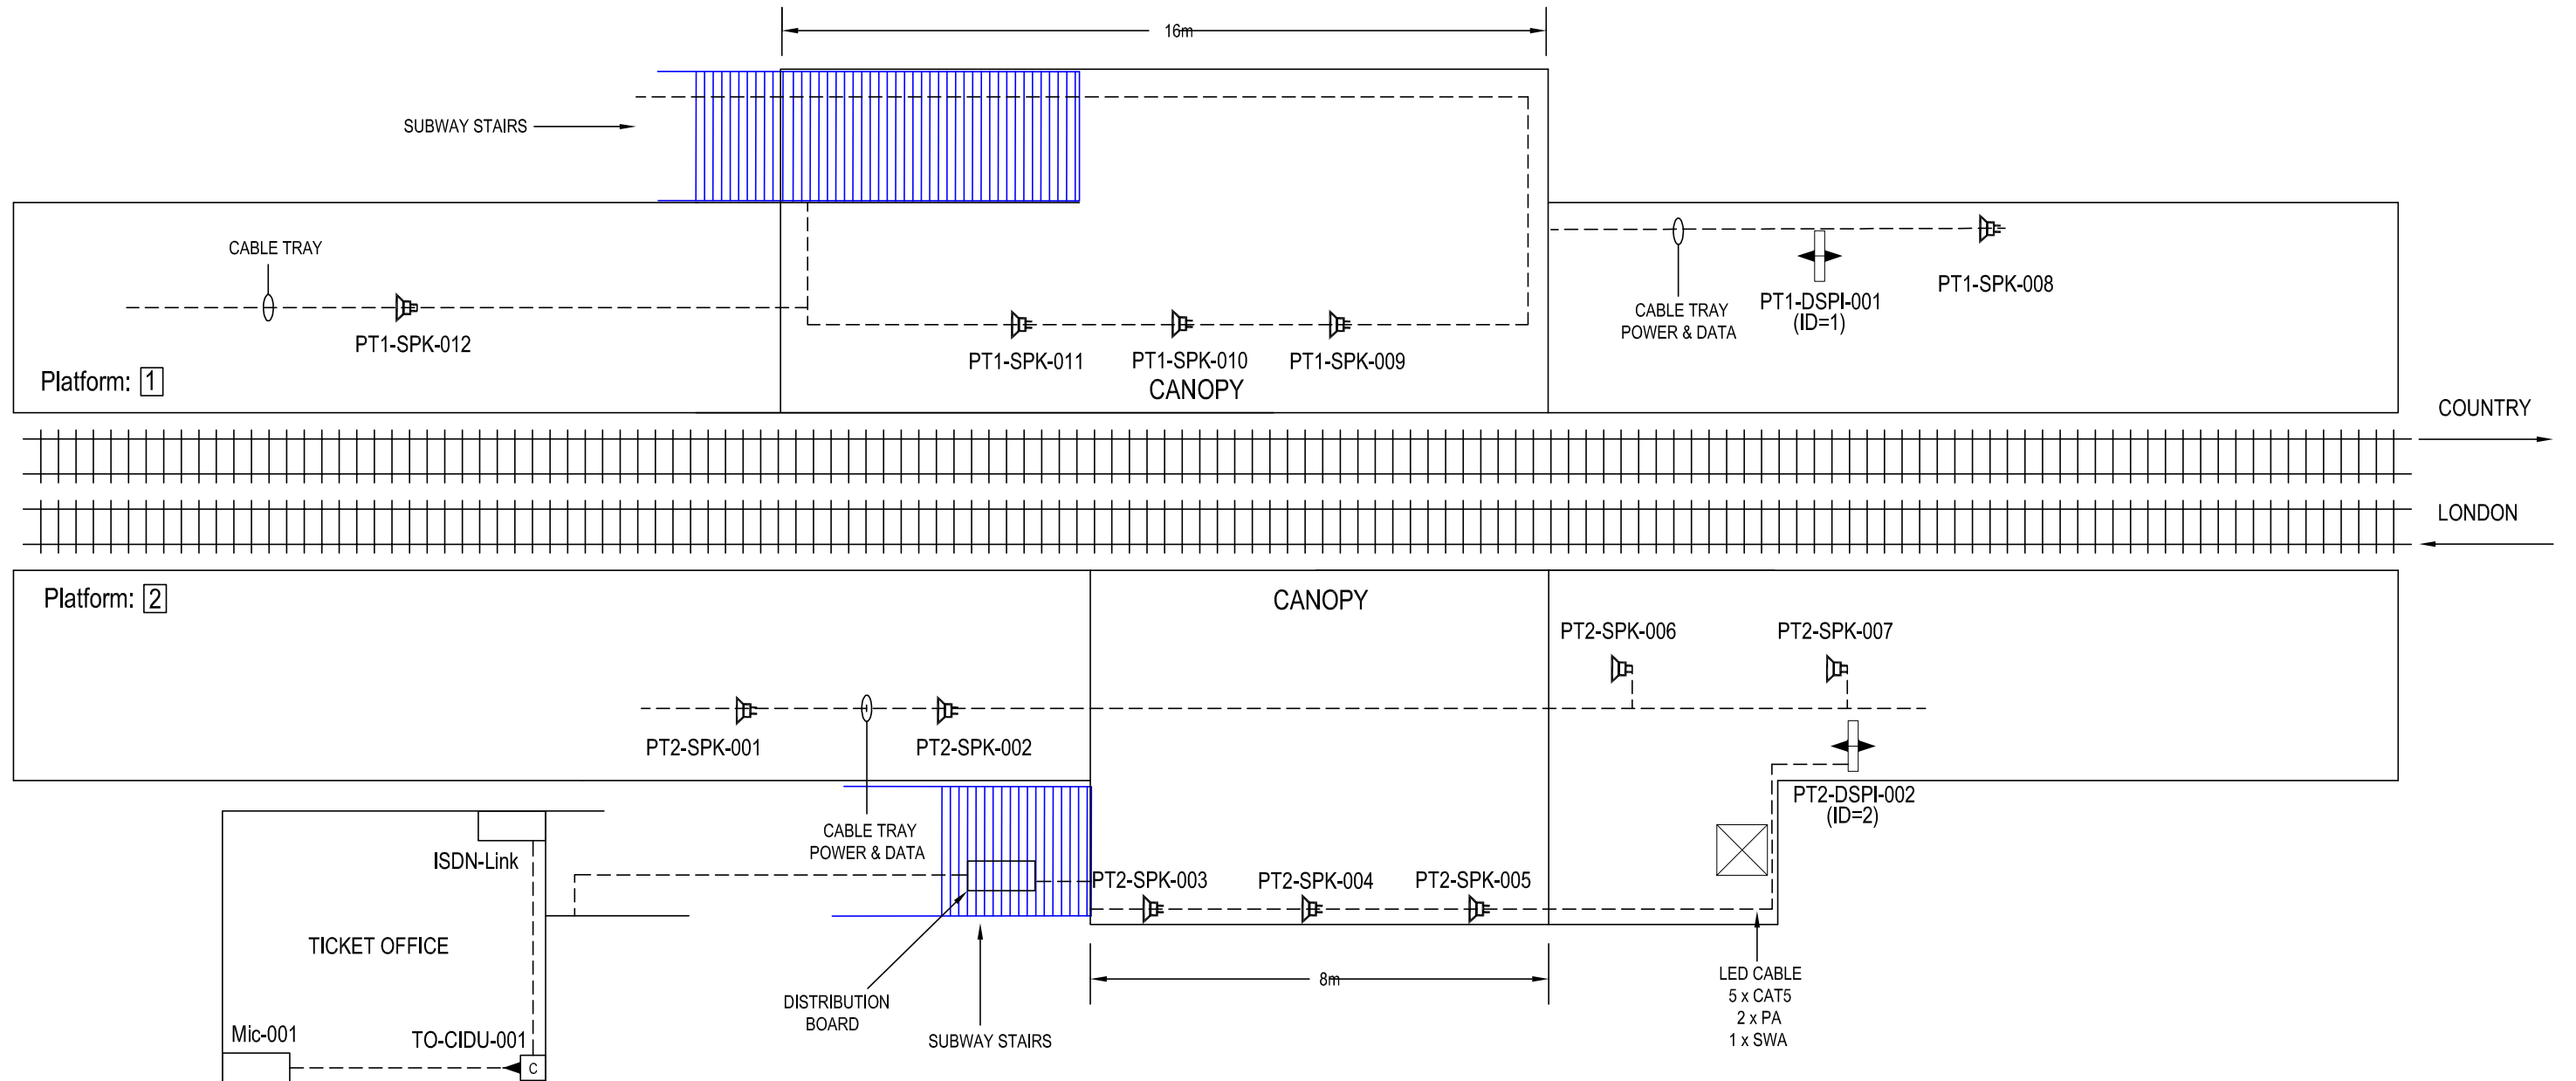

IF IN DOUBT ASK!

| MATERIAL | CONSTRUCTION | <table border="1"> <tr> <th>NAME</th> <th>SIGNATURE</th> <th>DATE</th> </tr> <tr> <td>D GADDU</td> <td>D GADDU</td> <td>09-04-2002</td> </tr> <tr> <td>T WONG</td> <td>T WONG</td> <td>01-07-2002</td> </tr> <tr> <td>A SMITH</td> <td></td> <td></td> </tr> <tr> <td></td> <td></td> <td></td> </tr> </table> | | | NAME | SIGNATURE | DATE | D GADDU | D GADDU | 09-04-2002 | T WONG | T WONG | 01-07-2002 | A SMITH | | | | | | <p>AMEY DATEL Project Offices 1st Floor, Platform 2/3 Eastleigh Station Southampton Road Eastleigh Hants SO50 9FL</p> | SITE/PROJECT | | SOUTH WEST TRAINS CIS PROJECT | |
|----------|-------------------|--|--|-------|---------|-----------------------|-------|---------|-------------|------------|--------|--------|------------|---------|--|--|--|--|--|---|--------------|--|-------------------------------|--|
| | | NAME | SIGNATURE | DATE | | | | | | | | | | | | | | | | | | | | |
| D GADDU | D GADDU | 09-04-2002 | | | | | | | | | | | | | | | | | | | | | | |
| T WONG | T WONG | 01-07-2002 | | | | | | | | | | | | | | | | | | | | | | |
| A SMITH | | | | | | | | | | | | | | | | | | | | | | | | |
| | | | | | | | | | | | | | | | | | | | | | | | | |
| FINISH | CAD Ref: | | <p>COPYRIGHT © AMEY Rail All rights reserved. Neither this drawing or any of the information it contains may be copied or communicated to third parties without the written permission of the copyright holder</p> | TITLE | | HAMPTON WICK AS BUILT | | | | | | | | | | | | | | | | | | |
| | CONTRACTOR'S Ref: | | | SCALE | DRG No. | ISSUE | SHEET | NTS | SM803-75589 | C | 1 of 1 | | | | | | | | | | | | | |