


DRG No. SM803-75523


WAN	
CIRCUIT ID	KXIP 200504
IP ADDRESS	10.22.162.31

"PLATFORM 1 HP ISDN"
01256-760646
"PLATFORM 2 HP ISDN"
01256-760655

All Equipment tags to be prefixed with "HOK-"

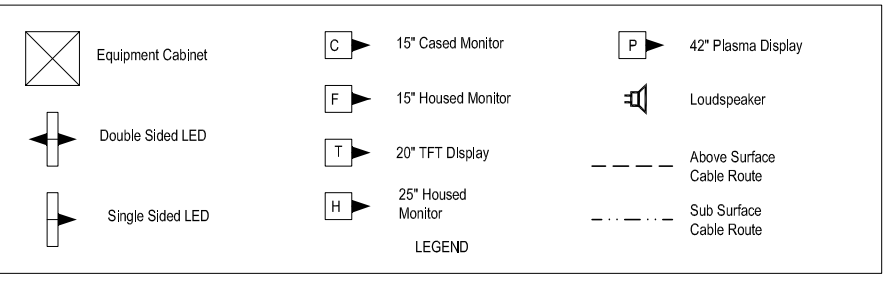


Equipment	Dist Board	
CIS RACK	9WAY C'TREE CCT2	C16
PT1-DSPI-001	GP 1	C8
PT2-DSPI-002	PT2 GP DB	C4
TO-CIDU-001	GP 1	C9
CP-HIDU-002	GP 1	C5

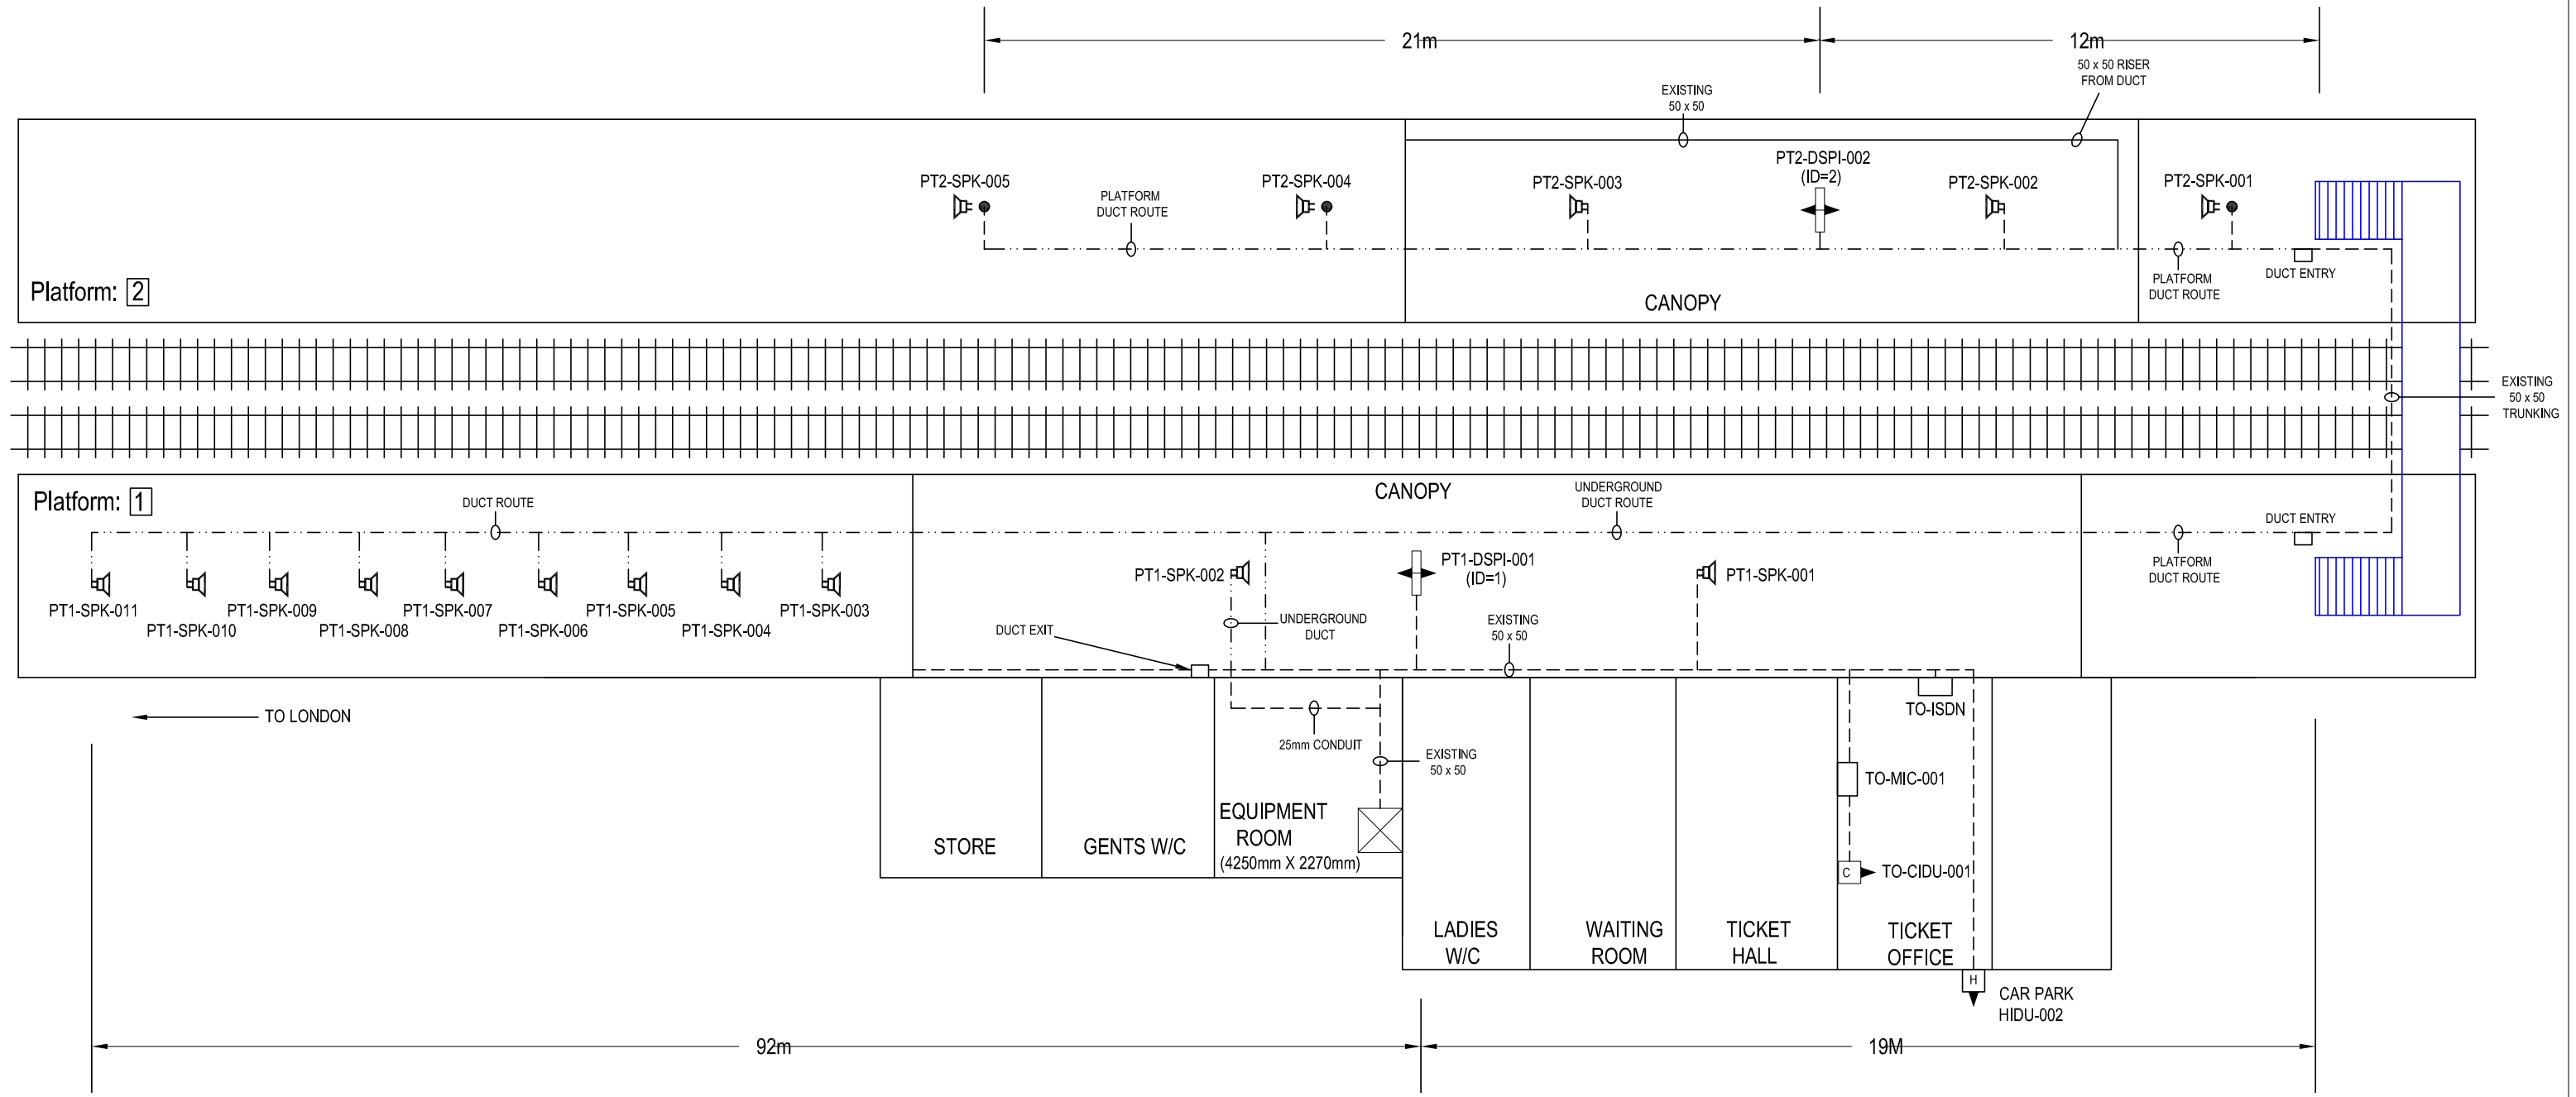

IF IN DOUBT ASK!

MATERIAL	CONSTRUCTION
FINISH	

NAME	SIGNATURE	DATE
DRAWN BY: D GADDU		10-05-2002
CHECKED BY: T WONG		
APPD BY: A SMITH		
APPD BY:		
CAD Ref:		
CONTRACTOR'S Ref:		



AMEY DATEL Project  
 Offices  
 1st Floor, Platform  
 2/3  
 Eastleigh Station  
 Southampton Road  
 Eastleigh  
 Hants  
 SO50 9FL

COPYRIGHT © AMEY Rail  
 All rights reserved. Neither this drawing or any of the information it contains may be copied or communicated to third parties without the written permission of the copyright holder

SITE/PROJECT		SOUTH WEST TRAINS CIS PROJECT	
TITLE		HOOK AS BUILT	
SCALE	DRG No.	ISSUE	SHEET
NTS	SM803-75523	B	1 of 1