



WAN	
CIRCUIT ID	KXIP200506
IP ADDRESS	10.227.164.1

"PLATFORM 1 HP ISDN"
020-8572-1203
"PLATFORM 2 HP ISDN"
020-8572-1203

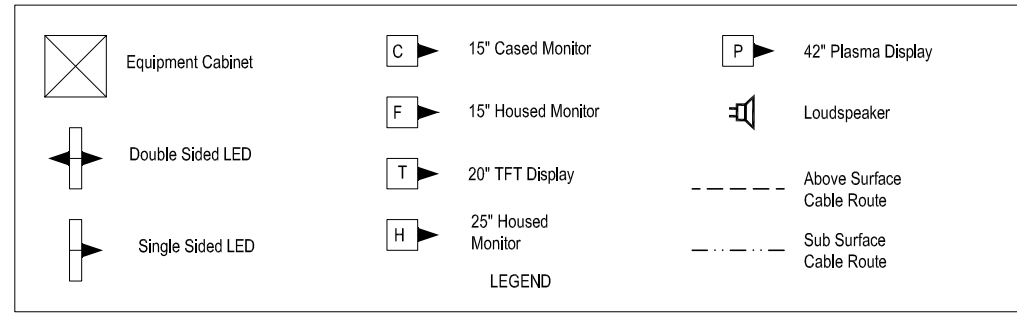

Equipment	Dist Board	
CIS RACK	S&T DB	R5
PT2-DSPI-002	GP 2	R4
OTHERS EXISTING		

All Equipment tags to be prefixed with "HOU-"

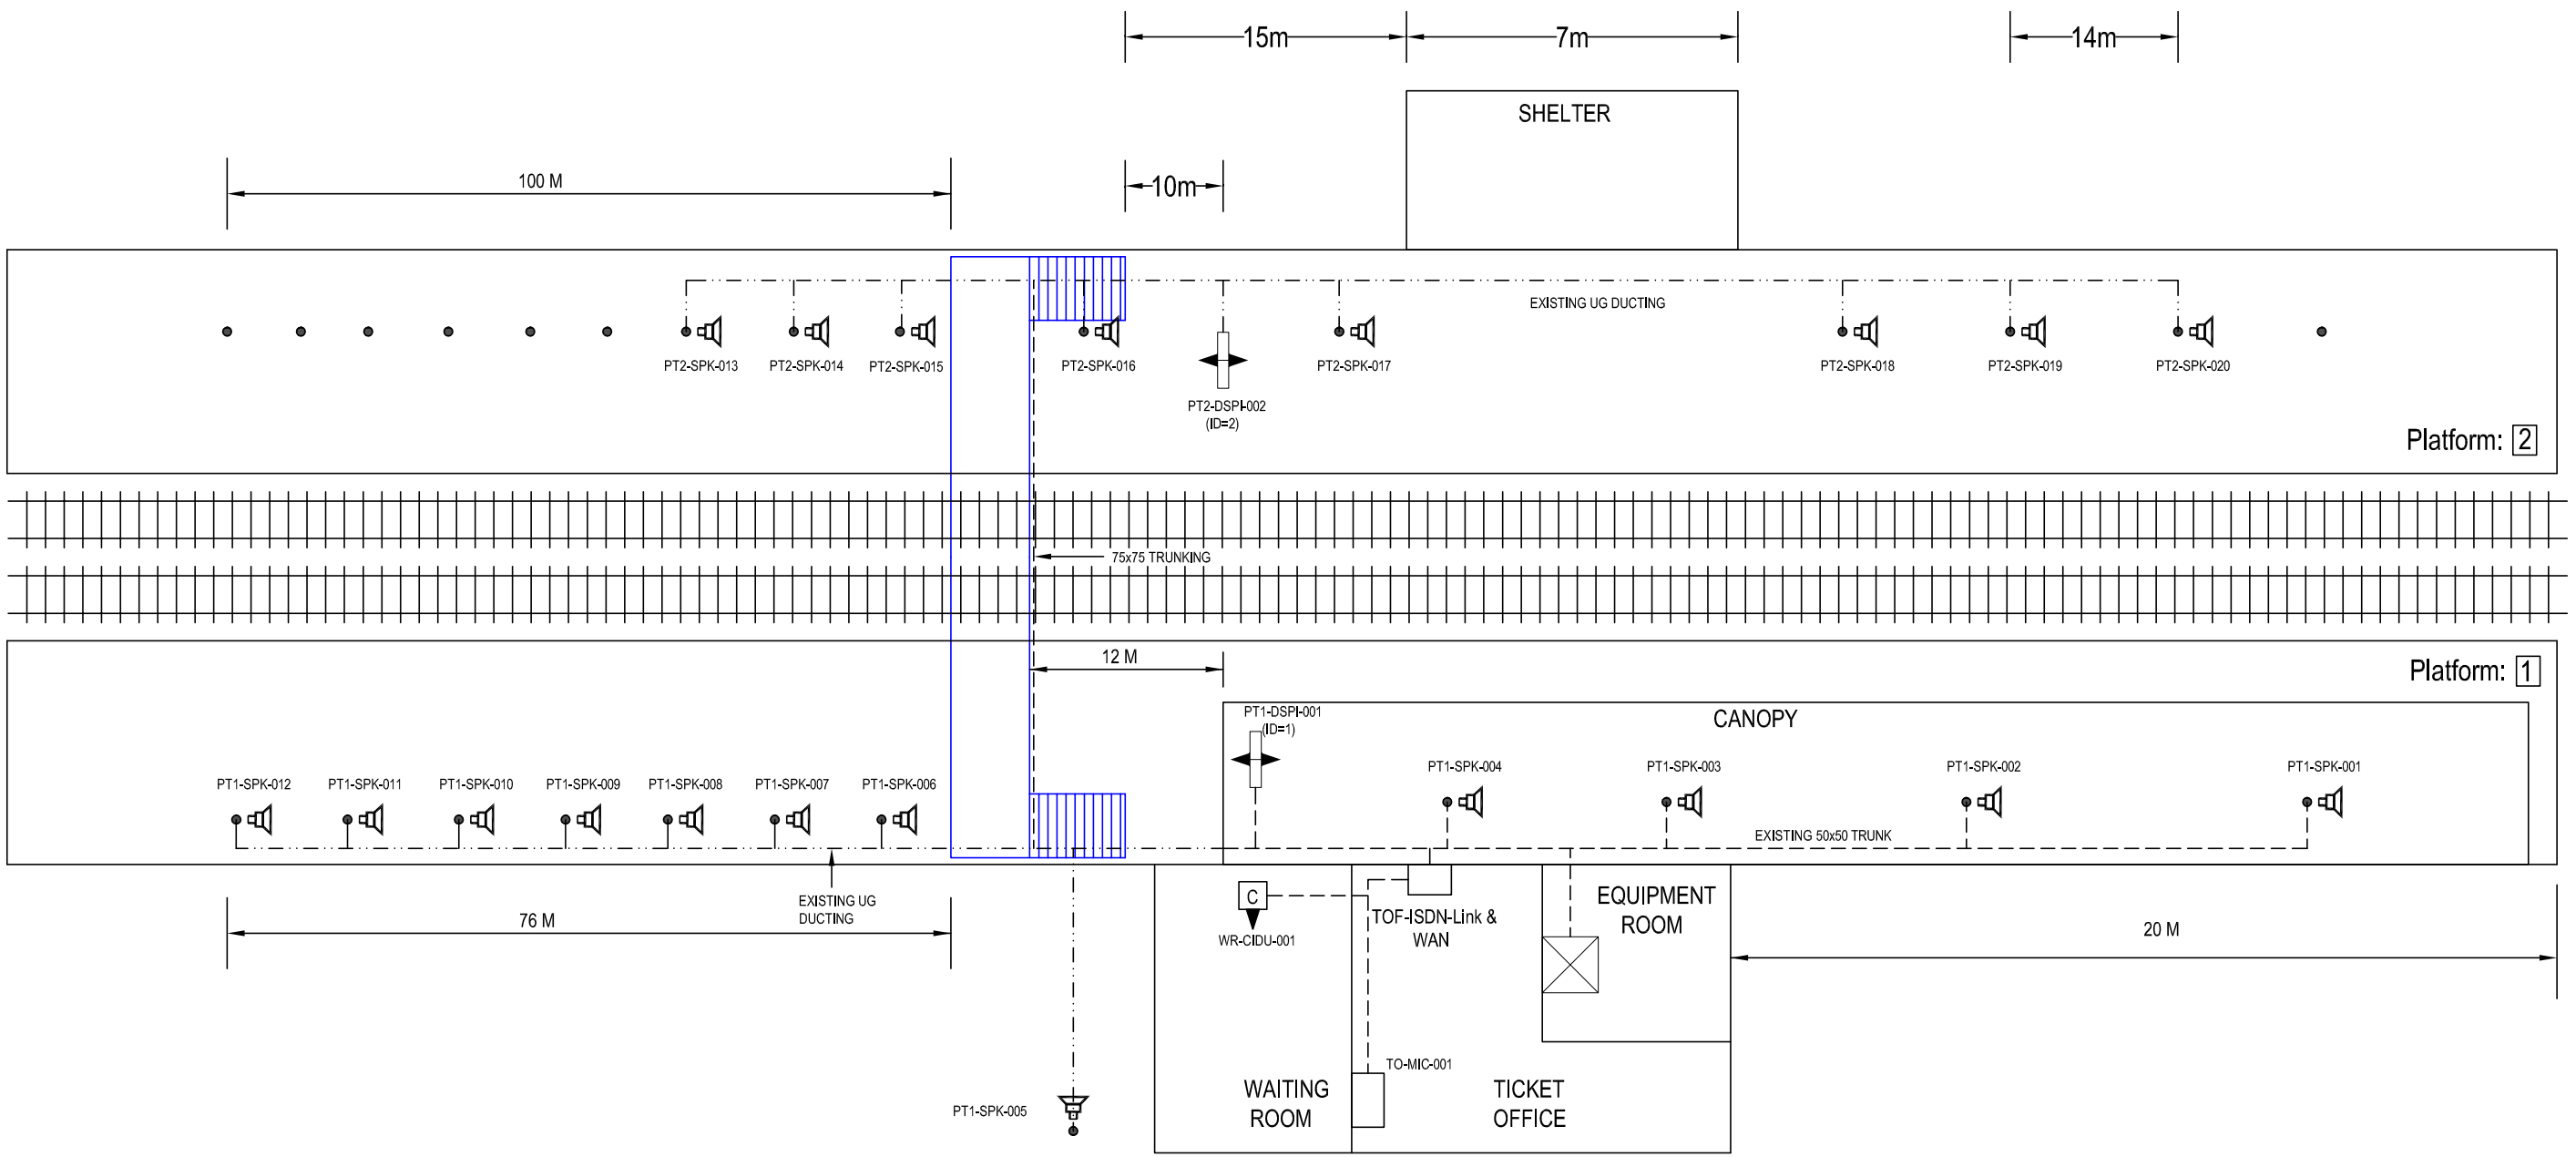

IF IN DOUBT ASK!

MATERIAL	CONSTRUCTION	NAME	SIGNATURE	DATE	<p>AMEY DATEL Project Offices 1st Floor, Platform 2/3 Eastleigh Station Southampton Road Eastleigh Hants SO50 9FL</p>	SITE/PROJECT		SOUTH WEST TRAINS CIS PROJECT	
		DRAWN BY	D GADDU	24/06/2002		TITLE	HOUNSLOW AS BUILT		
FINISH	CONSTRUCTION	CHECKED BY	T WONG		<p>COPYRIGHT © AMEY Rail All rights reserved. Neither this drawing or any of the information it contains may be copied or communicated to third parties without the written permission of the copyright holder</p>	SCALE	DRG No.	ISSUE	SHEET
		APPD BY	A SMITH			NTS	SM803-75563	B	1 of 1
		CONTRACTOR'S Ref:							