



WAN	
CIRCUIT ID	KXIP200505
IP ADDRESS	10.227.163.1

"PLATFORM 1 HP ISDN"
01-483-281350
"PLATFORM 2 HP ISDN"
01-483-281377

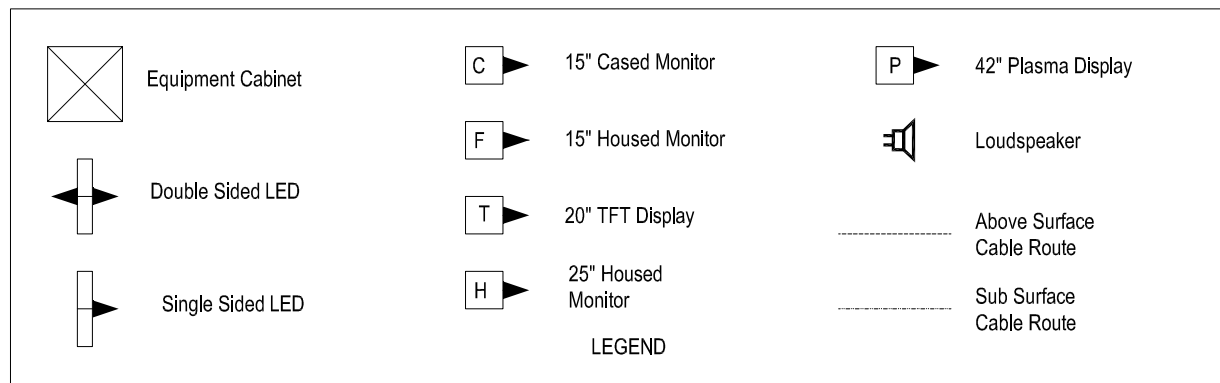

Equipment	Dist Board	
PT1-DSPI-001	GP 2	CCT 8
PT2-DSPI-002	GP 2	CCT 9
TH-CIDU-001	GP 2	CCT 9

All Equipment tags to be prefixed with "HSY-"

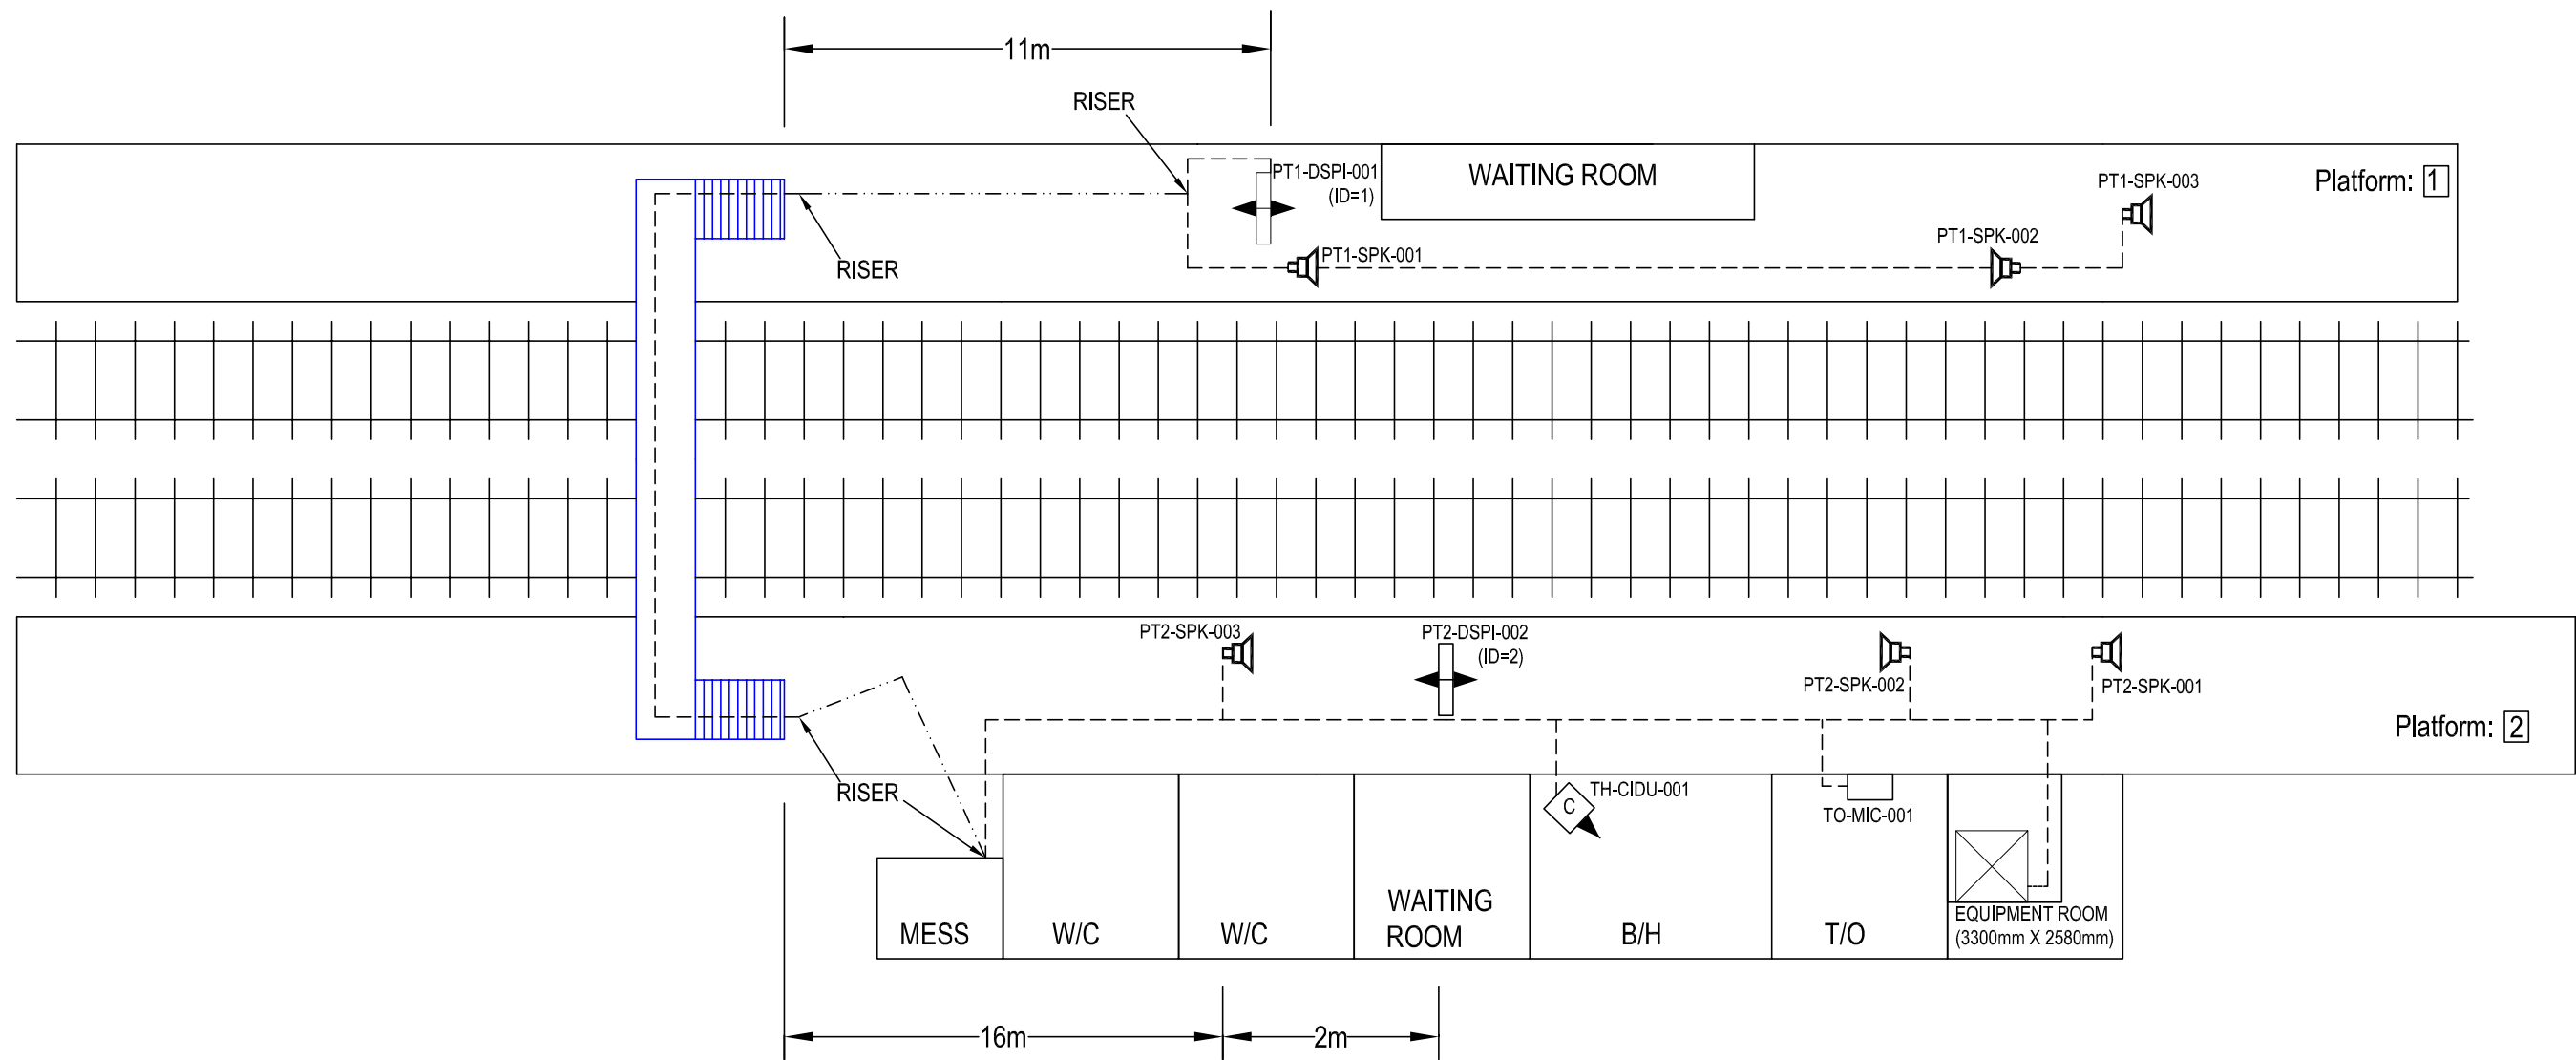

IF IN DOUBT ASK!

MATERIAL	CONSTRUCTION	NAME	SIGNATURE	DATE	<p>AMEY DATEL Project Offices 1st Floor, Platform 2/3 Eastleigh Station Southampton Road Eastleigh Hants SO50 9FL</p>	SITE/PROJECT			
		DRAWN BY	D GADDU				SOUTH WEST TRAINS CIS PROJECT		
FINISH		CHECKED BY	T WONG			TITLE			
		APPD BY	A SMITH			HORSLEY STATION AS BUILT			
		APPD BY				SCALE	DRG No.	ISSUE	SHEET
		CAD Ref:				NTS	SM803-75562	B	1 of 1
		CONTRACTOR'S Ref:							

COPYRIGHT © AMEY Rail  
All rights reserved. Neither this drawing or any of the information it contains may be copied or communicated to third parties without the written permission of the copyright holder