



WAN	
CIRCUIT ID	KXIP200500
IP ADDRESS	10.227.158.1

"PLATFORM 1 HP ISDN"
020-8398-4209

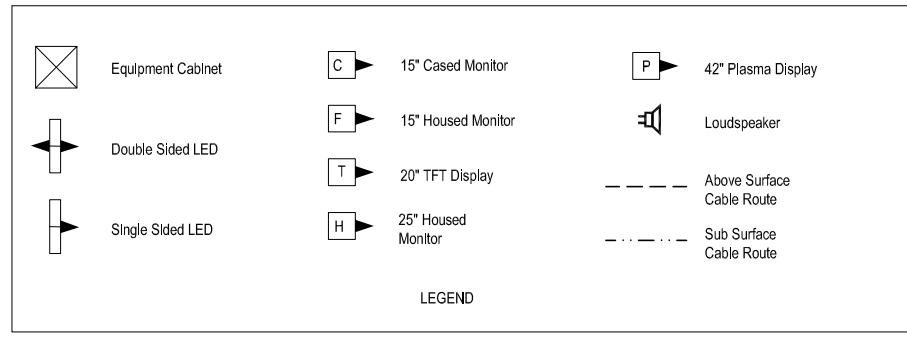

Equipment	Dist Board
TH-FIDU-001	EXISTING SUPPLY
PT2-DSPI-001	SP1 DB A2 15A
PT1-SSPI-002	SP1 DB A2 15A
PT1-DSPI-003	20A FUSED SWITCH IN ELEC ROOM
CIS RACK	20A FUSED SWITCH IN ELEC ROOM

All Equipment tags to be prefixed with "HYW-"

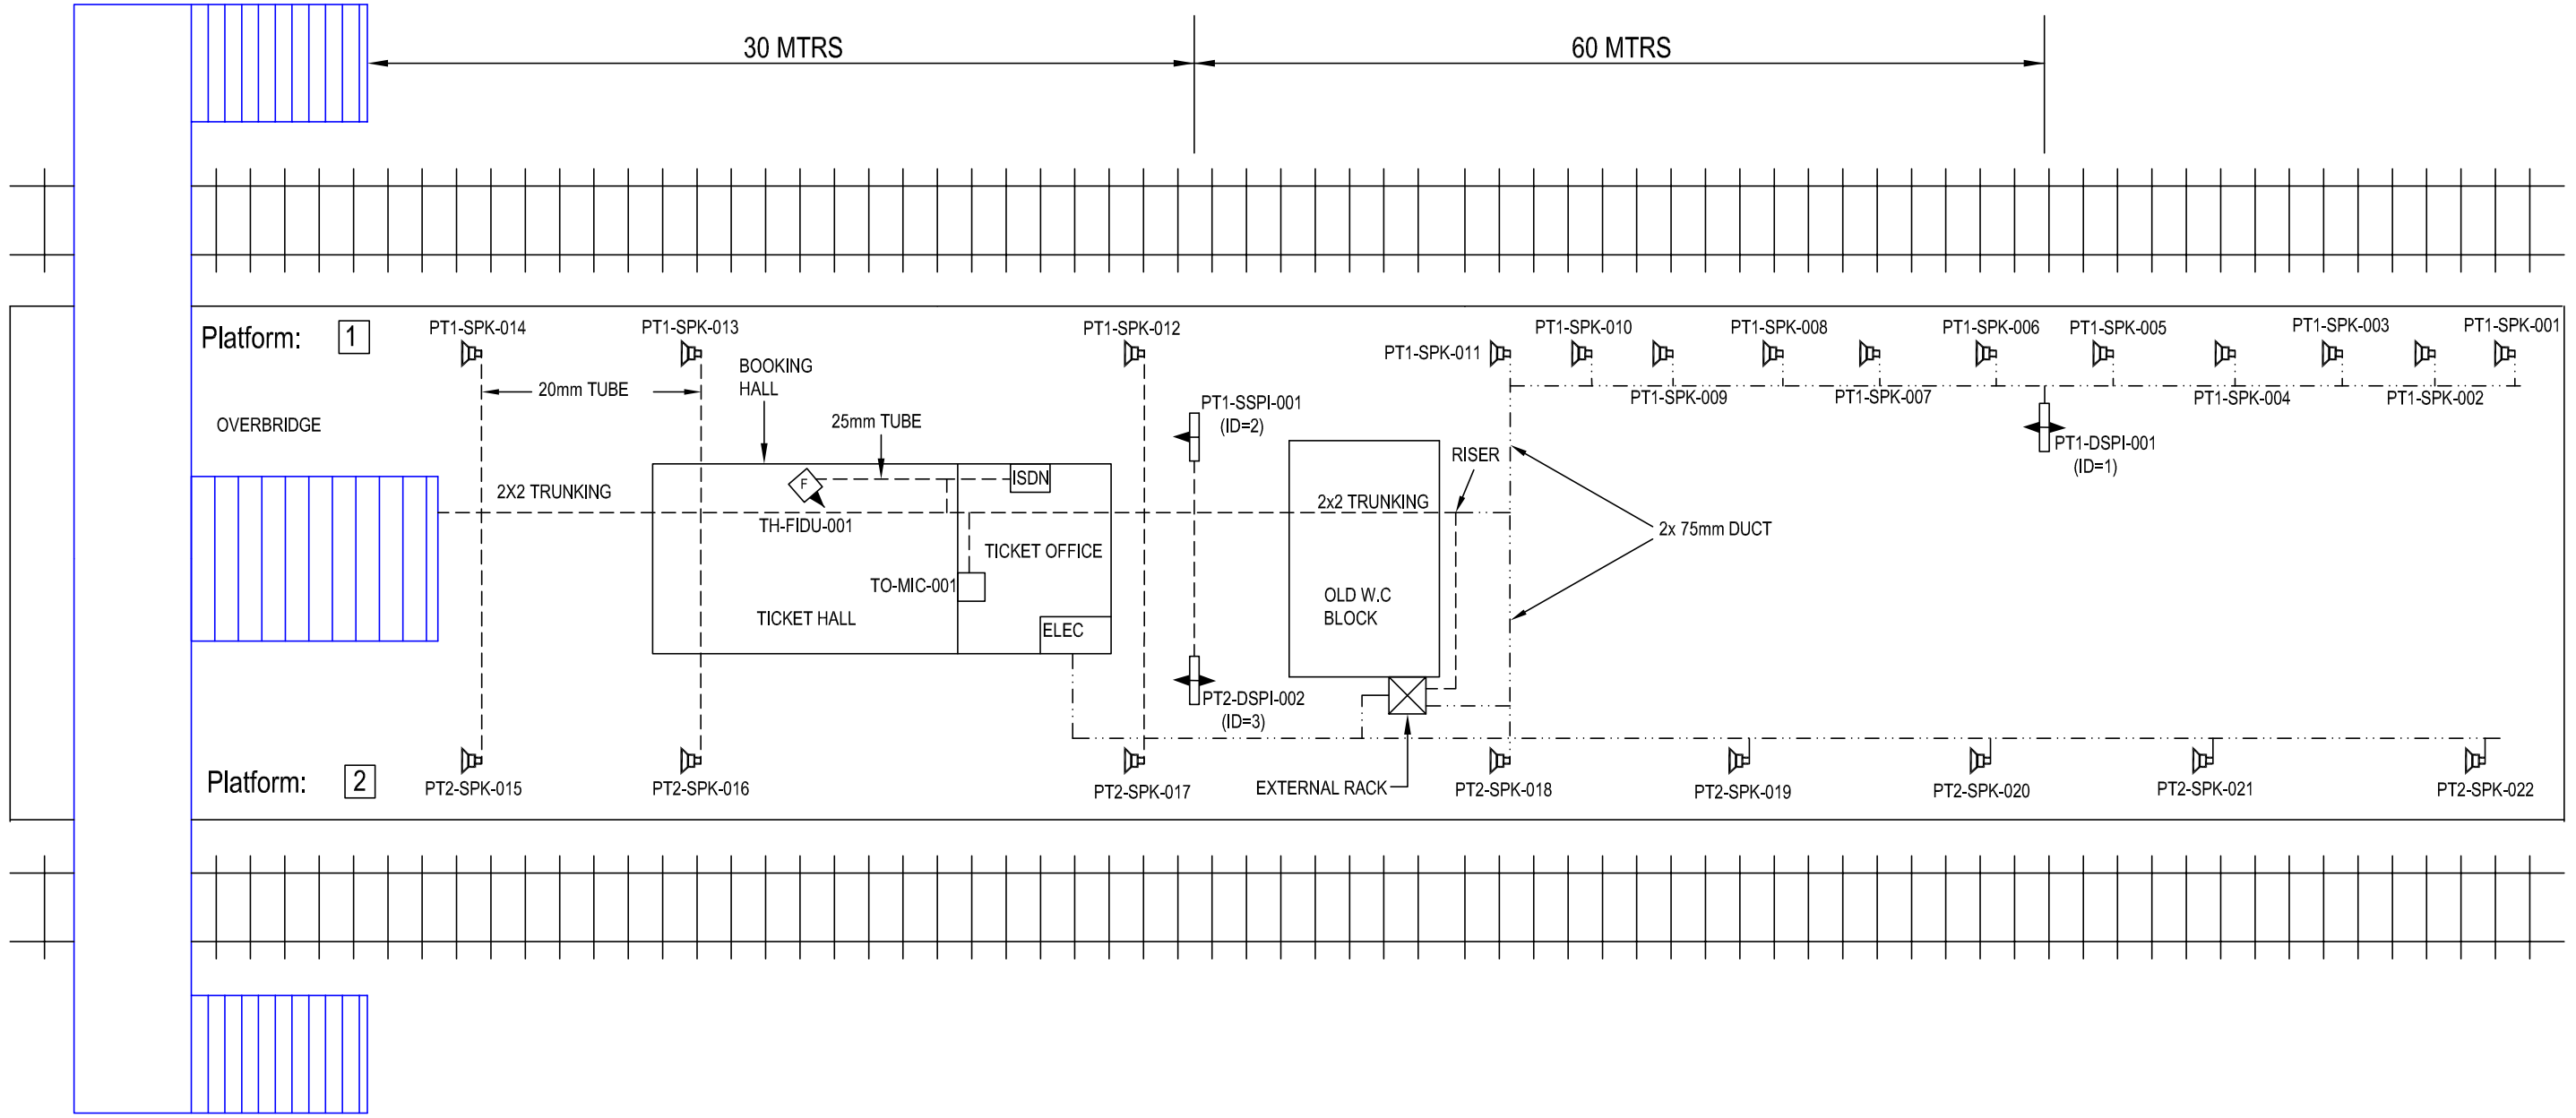

IF IN DOUBT ASK!

MATERIAL	CONSTRUCTION	<table border="1"> <thead> <tr> <th>NAME</th> <th>SIGNATURE</th> <th>DATE</th> </tr> </thead> <tbody> <tr> <td>DRAWN BY: A HATTON</td> <td></td> <td>09-08-2002</td> </tr> <tr> <td>CHECKED BY: T WONG</td> <td></td> <td></td> </tr> <tr> <td>APPD BY: A SMITH</td> <td></td> <td></td> </tr> <tr> <td>APPD BY:</td> <td></td> <td></td> </tr> </tbody> </table>	NAME	SIGNATURE	DATE	DRAWN BY: A HATTON		09-08-2002	CHECKED BY: T WONG			APPD BY: A SMITH			APPD BY:			<p>AMEY DATEL Project Offices 1st Floor, Platform 2/3 Eastleigh Station Southampton Road Eastleigh Hants SO50 9FL</p>	SITE/PROJECT SOUTH WEST TRAINS CIS PROJECT	
		NAME	SIGNATURE	DATE																
DRAWN BY: A HATTON		09-08-2002																		
CHECKED BY: T WONG																				
APPD BY: A SMITH																				
APPD BY:																				
FINISH				TITLE HINCHLEY WOOD STATION AS BUILT																
		CAD Ref:		SCALE NTS	DRG No. SM803-75591	ISSUE B	SHEET 1 of 1													
		CONTRACTOR'S Ref:		<p>COPYRIGHT © AMEY Rail All rights reserved. Neither this drawing or any of the information it contains may be copied or communicated to third parties without the written permission of the copyright holder</p>																