



WAN	
CIRCUIT ID	KXIP 100376
IP ADDRESS	10.227.166.1

"PLATFORM 1 HP ISDN"
N.A
"PLATFORM 2 HP ISDN"
N.A

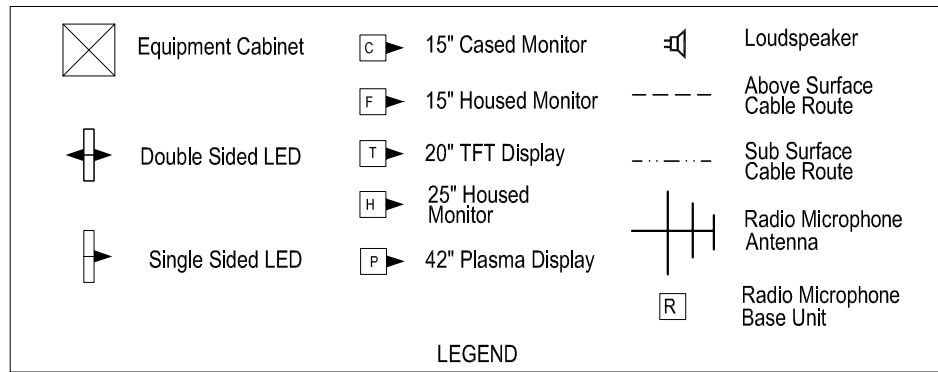

Equipment	Dist Board
CIS RACK	DB1 CCT1
PT1-DSPI-001	DB1 CCT1

All Equipment tags to be prefixed with "KMP-"

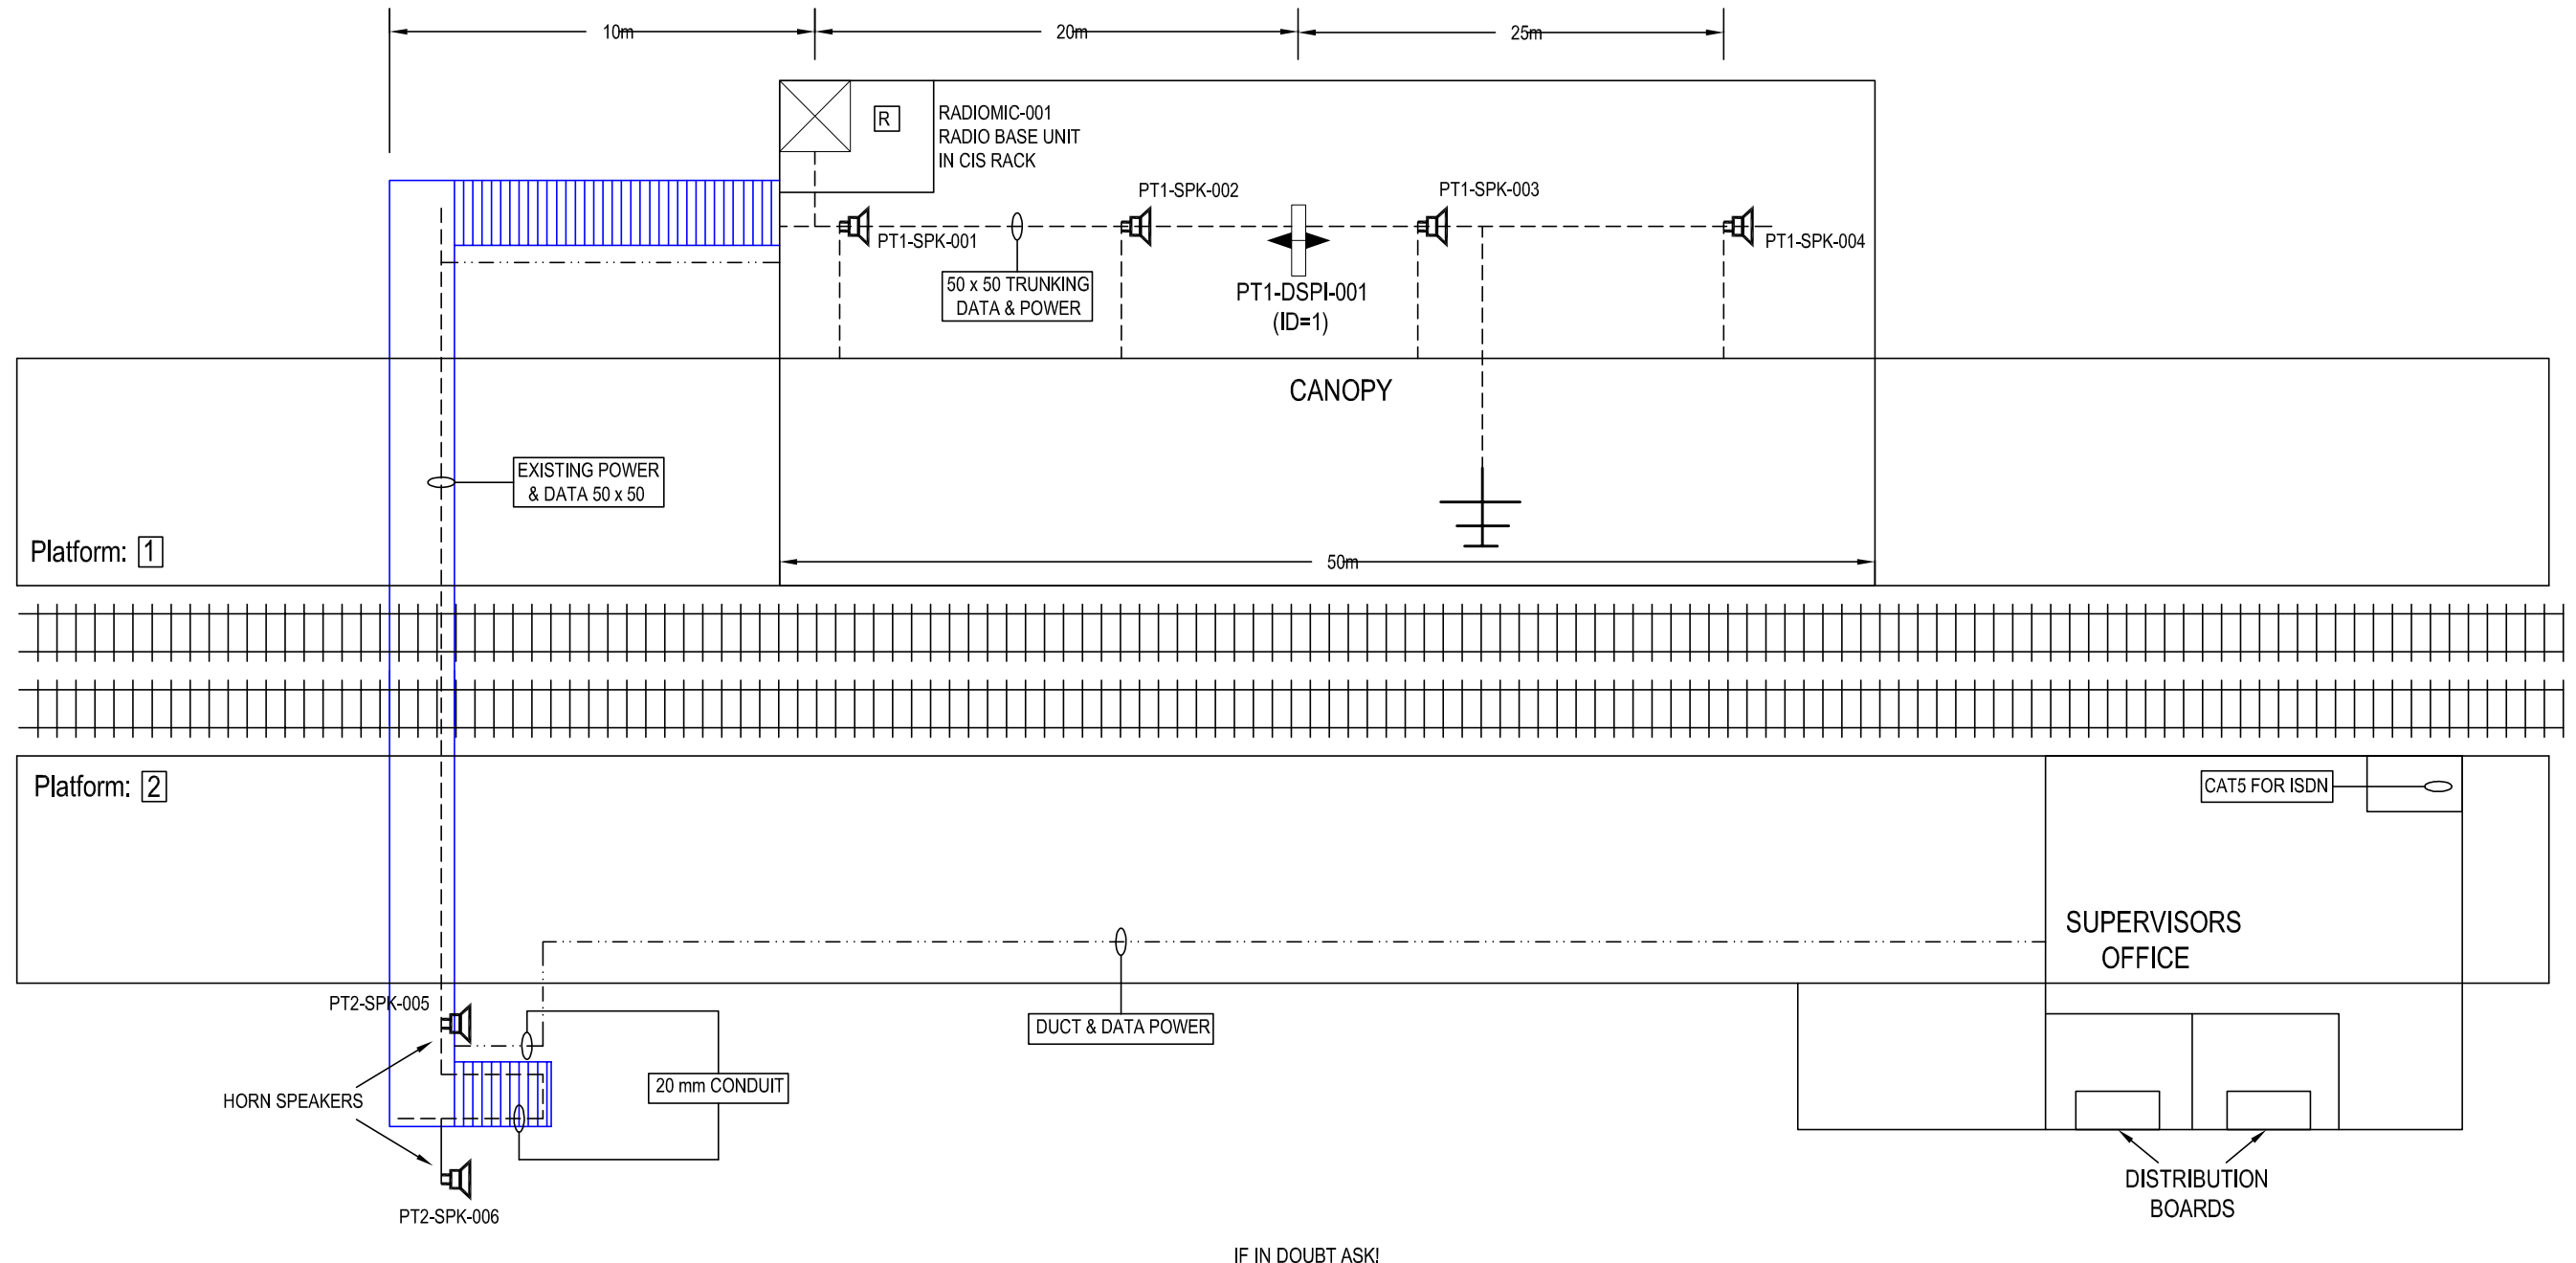

IF IN DOUBT ASK!

MATERIAL	CONSTRUCTION	NAME	SIGNATURE	DATE
		DRAWN BY	D GADDU	21-05-2002
FINISH		CHECKED BY	T WONG	
		APPD BY	A SMITH	
		APPD BY		
		CAD Ref:		
		CONTRACTOR'S Ref:		

AMEY DATEL Project
 Offices
 1st Floor, Platform
 2/3
 Eastleigh Station
 Southampton Road
 Eastleigh
 Hants
 SO50 9FL

COPYRIGHT © AMEY Rail
 All rights reserved. Neither this drawing or any of the information it contains may be copied or communicated to third parties without the written permission of the copyright holder

SITE/PROJECT		SOUTH WEST TRAINS CIS PROJECT	
TITLE		KEMPTON PARK AS BUILT	
SCALE	DRG No.	ISSUE	SHEET
NTS	SM803-75678	B	1 of 1