


DRG No. SM803-75632


WAN	
CIRCUIT ID	KXIP 100381
IP ADDRESS	10.227.170.1

"PLATFORM 1 HP ISDN"
01-483-565453
"PLATFORM 2 HP ISDN"
01-483-565463

All Equipment tags to be prefixed with "LON-"

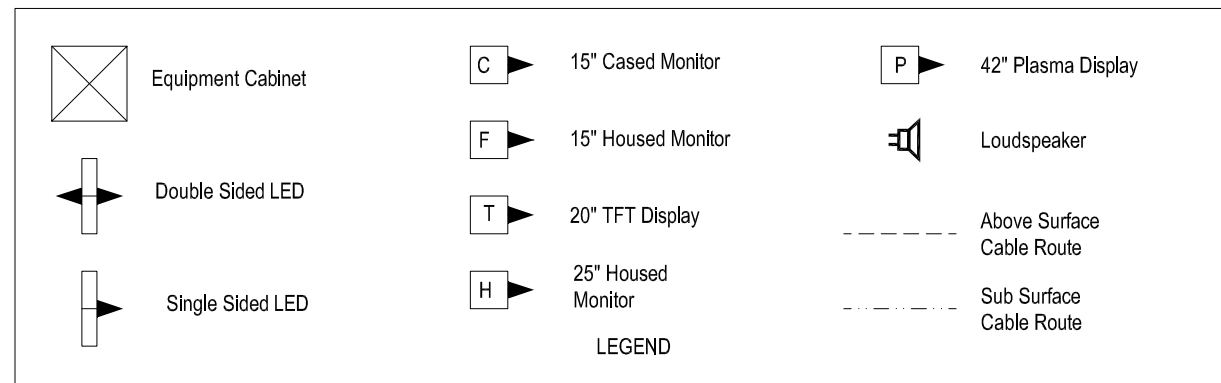

Equipment	Dist Board	
EXISTING USED		

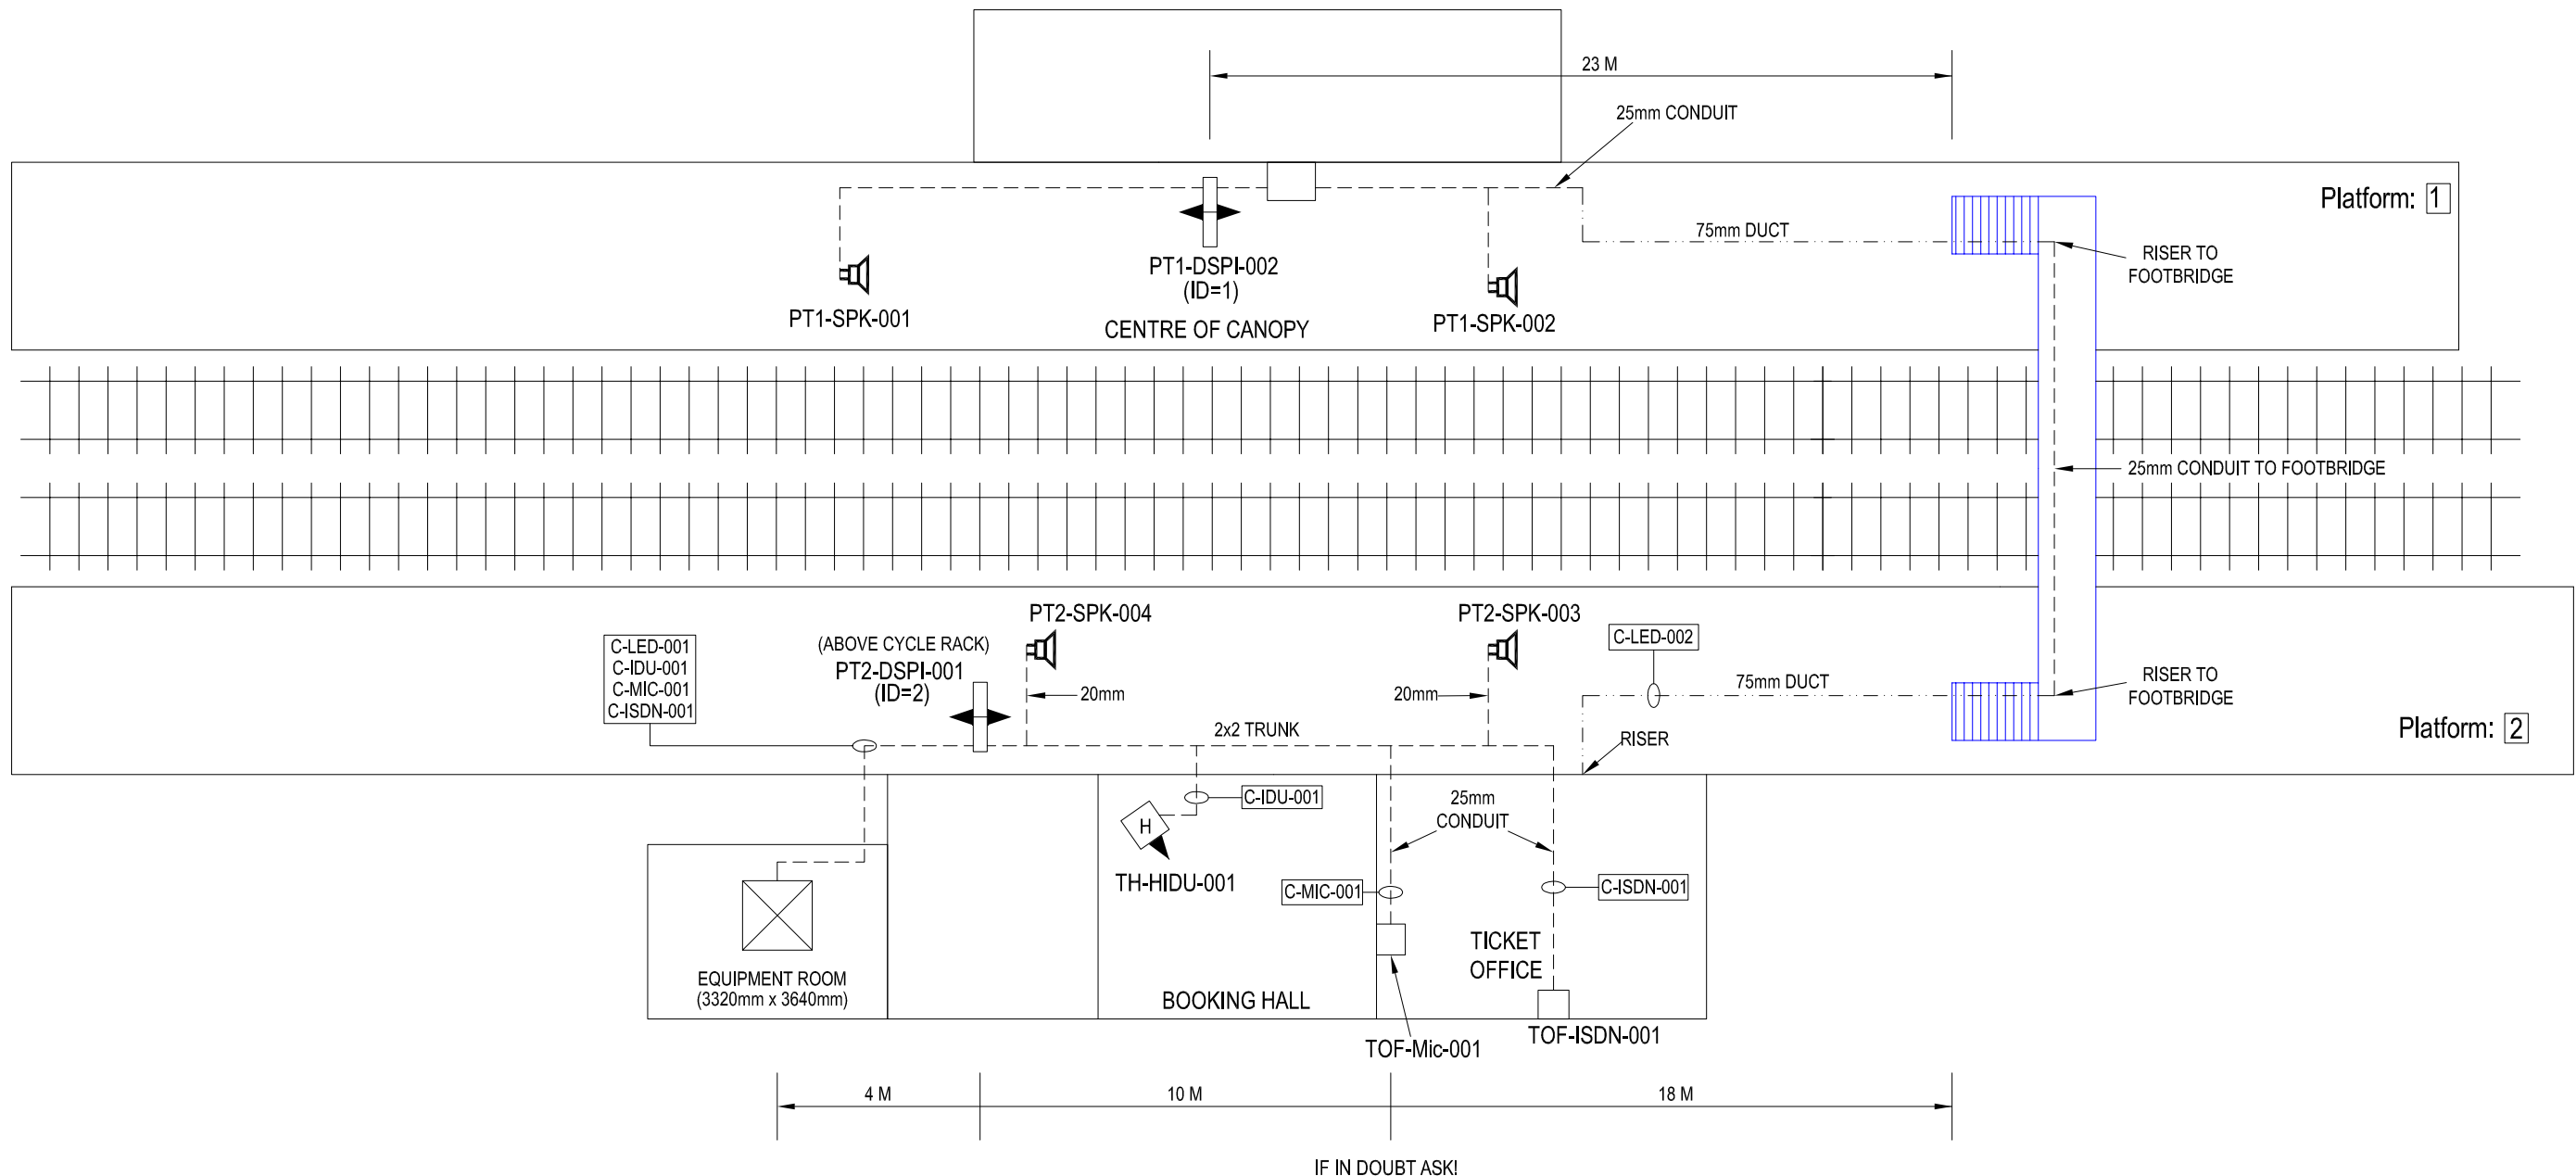

MATERIAL	CONSTRUCTION	DRAWN BY	D GADDU	SIGNATURE		<p>AMEY DATEL Project Offices 1st Floor, Platform 2/3 Eastleigh Station Southampton Road Eastleigh Hants SO50 9FL</p>	SITE/PROJECT		SOUTH WEST TRAINS CIS PROJECT	
		CHECKED BY	T WONG	DATE	04-03-2002		TITLE	LONDON ROAD AS BUILT		
FINISH		APPD BY	A SMITH				SCALE	DRG No.	ISSUE	SHEET
		CAD Ref:					NTS	SM803-75632	B	1 of 1
		CONTRACTOR'S Ref:				<p>COPYRIGHT © AMEY Rail All rights reserved. Neither this drawing or any of the information it contains may be copied or communicated to third parties without the written permission of the copyright holder</p>				