



WAN	
CIRCUIT ID	KXIP100384
IP ADDRESS	10.227.174.1

"PLATFORM 1 HP ISDN"
020-8337-7140
"PLATFORM 2 HP ISDN"
020-8337-7172

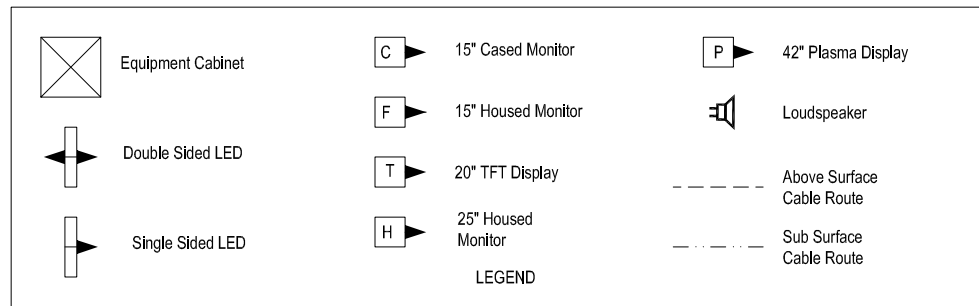

Equipment	Dist Board
	MID PLATFORM 1
CIS RACK	CCT 5
PT1-DSPI-001	CCT 6
PT2-DSPI-002	CCT 6

All Equipment tags to be prefixed with "MAL-"

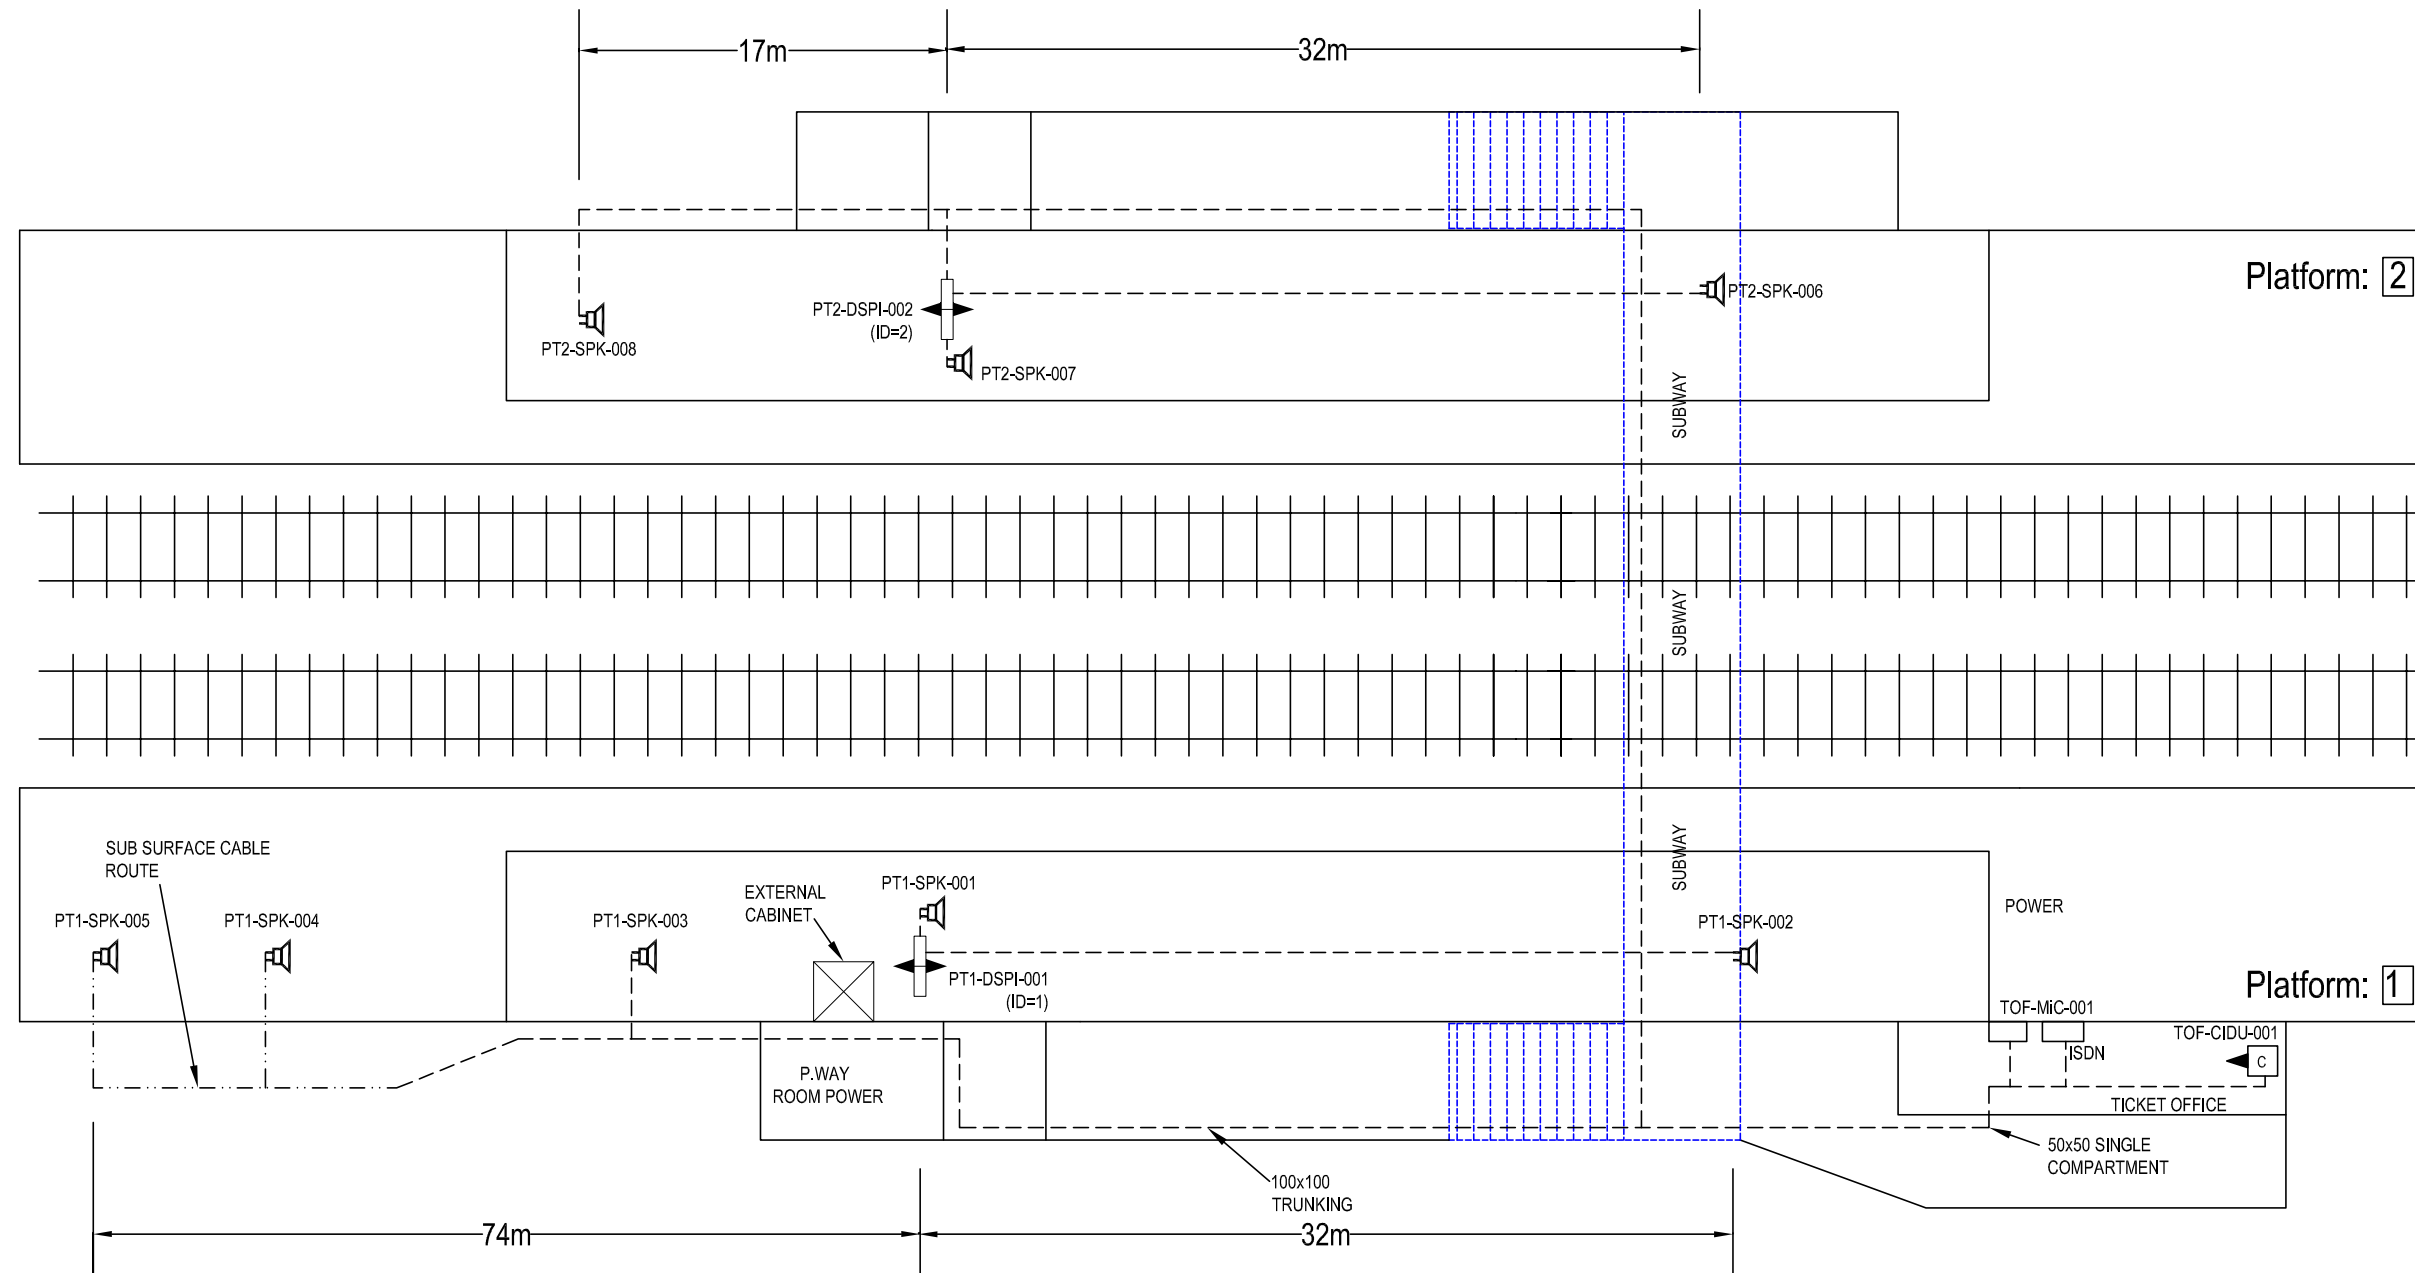

IF IN DOUBT ASK!

MATERIAL	CONSTRUCTION	NAME	SIGNATURE	DATE	<p>AMEY DATEL Project Offices 1st Floor, Platform 2/3 Eastleigh Station Southampton Road Eastleigh Hants SO50 9FL</p>	SITE/PROJECT			
		DRAWN BY	D GADDU	14-05-2002		SOUTH WEST TRAINS CIS PROJECT			
		CHECKED BY	T WONG			TITLE			
		APPD BY	A SMITH			MALDEN MANOR AS BUILT			
FINISH	CONSTRUCTION	CAD Ref:			<p>COPYRIGHT © AMEY Rail All rights reserved. Neither this drawing or any of the information it contains may be copied or communicated to third parties without the written permission of the copyright holder</p>	SCALE	DRG No.	ISSUE	SHEET
		CONTRACTOR'S Ref:				NTS	SM803-75599	B	1 of 1