



WAN	
CIRCUIT ID	KXIP 100386
IP ADDRESS	10.227.175.1

"PLATFORM 1 HP ISDN"	01-344-311135
"PLATFORM 2 HP ISDN"	01-344-311137

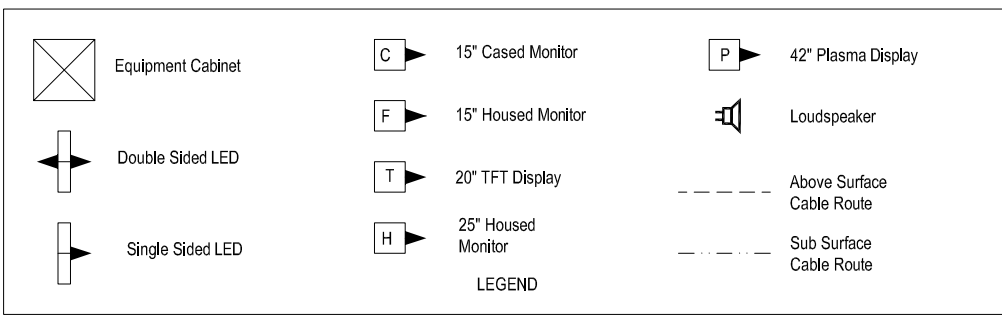

Equipment	Dist Board
PT1-DSPI	GPI-BREAKER 12
PT2-DSPI	
BH MONITOR	

All Equipment tags to be prefixed with "MAO-"

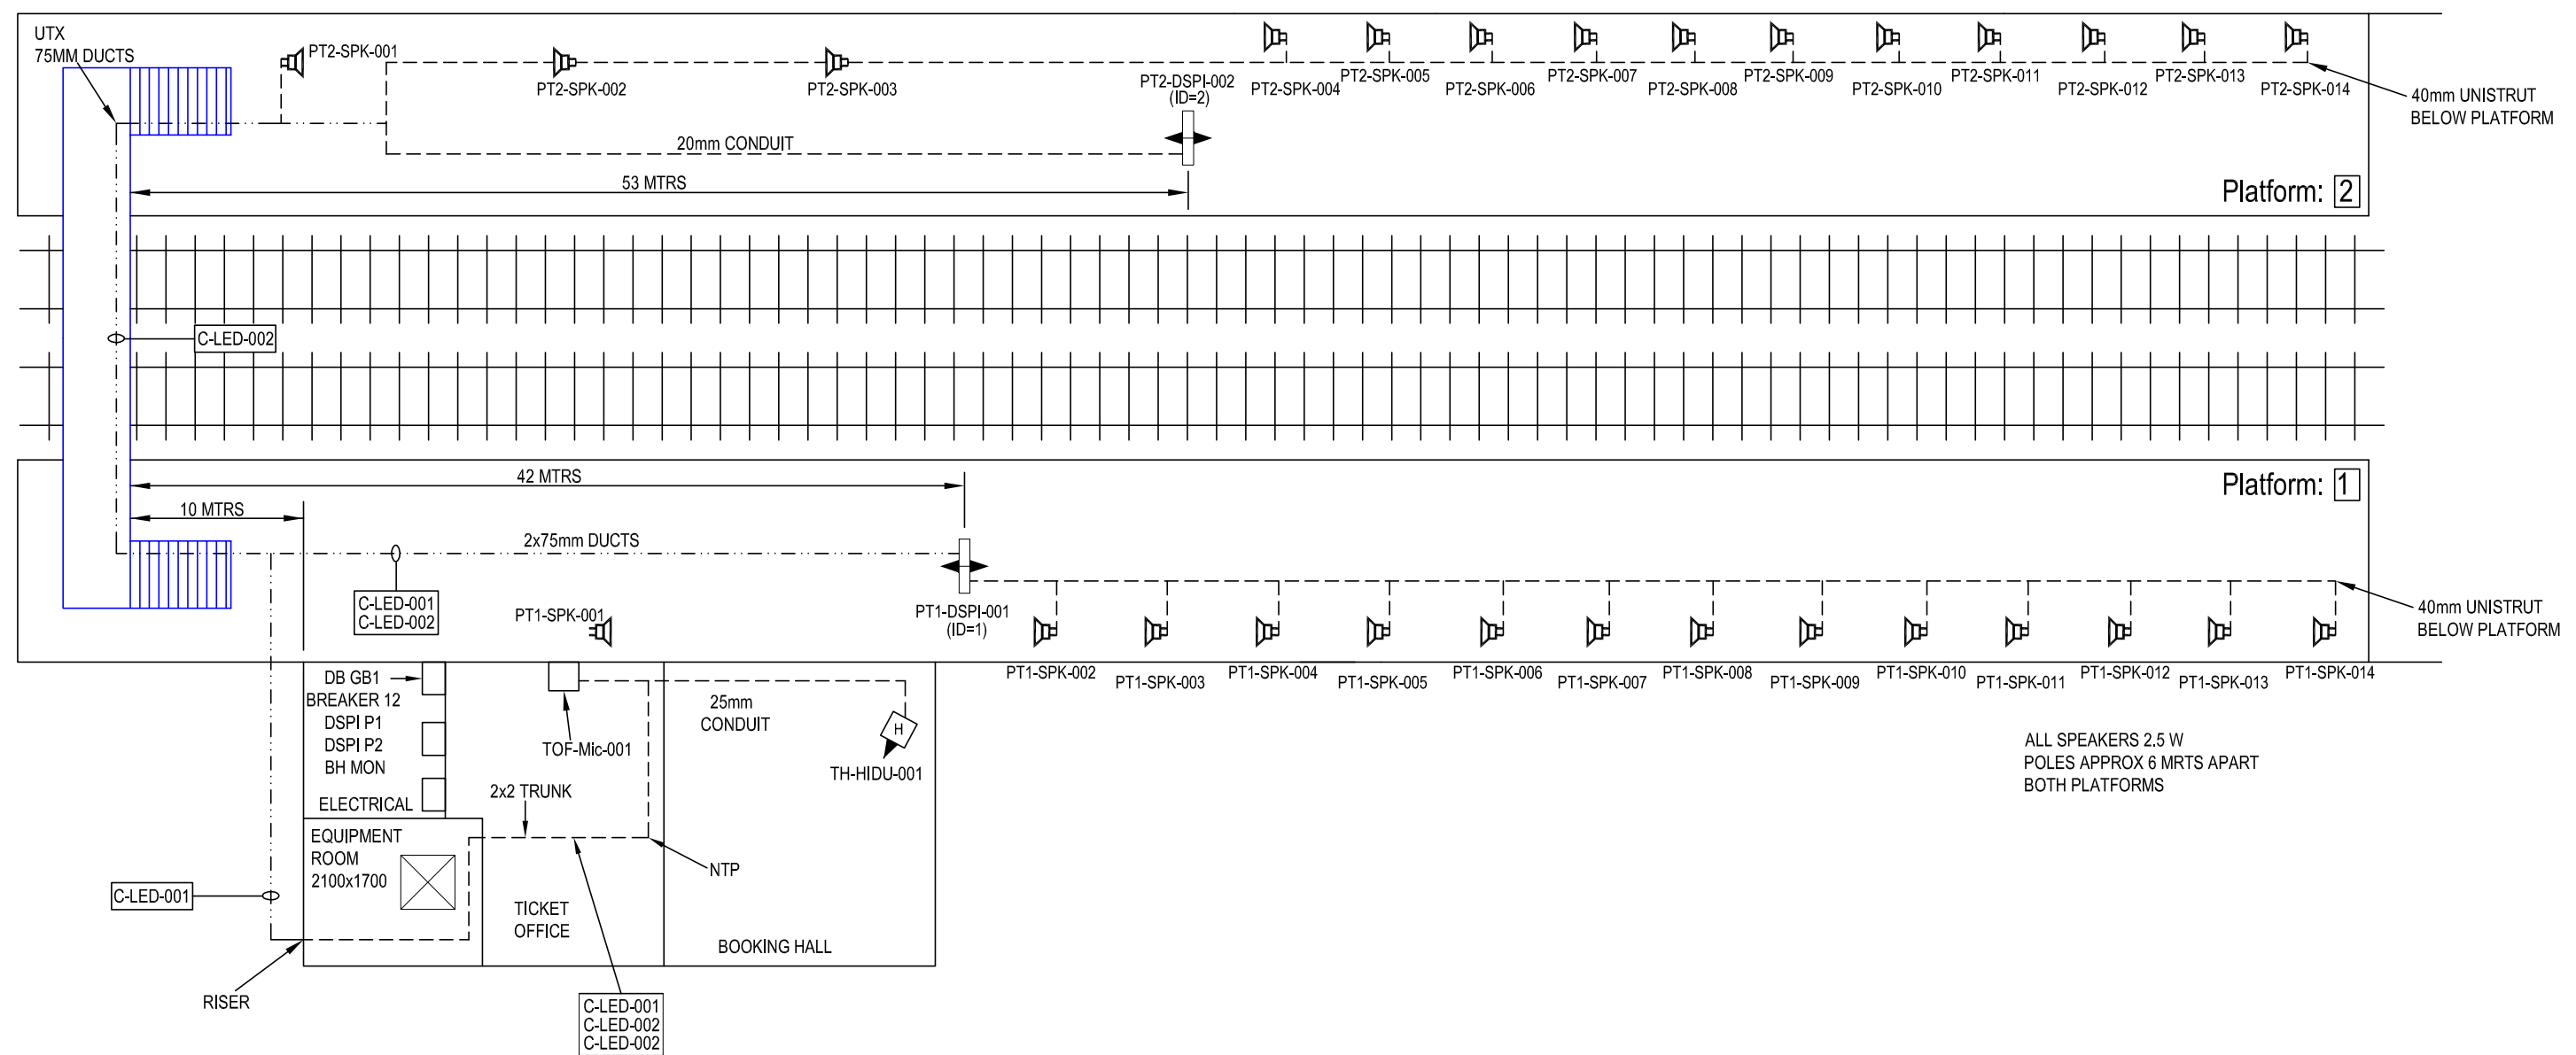

ALL SPEAKERS 2.5 W
POLES APPROX 6 MTRS APART
BOTH PLATFORMS

IF IN DOUBT ASK!

MATERIAL	CONSTRUCTION	DRAWN BY	D GADDU	SIGNATURE		AMEY DATEL Project Offices 1st Floor, Platform 2/3 Eastleigh Station Southampton Road Eastleigh Hants SO50 9FL	SITE/PROJECT		SOUTH WEST TRAINS CIS PROJECT	
		CHECKED BY	T WONG	DATE	11-02-2001		TITLE		MARTINS HERON AS BUILT	
FINISH		APPD BY	A SMITH				SCALE	DRG No.	ISSUE	SHEET
		CAD Ref:					NTS	SM803-75692	B	1 of 1
		CONTRACTOR'S Ref:				COPYRIGHT © AMEY Rail All rights reserved. Neither this drawing or any of the information it contains may copied or communicated to third parties without the written permission of the copyright holder				