



WAN	
CIRCUIT ID	KXIP 200508
IP ADDRESS	10.227.178.1

"PLATFORM 1 HP ISDN"
02380-630464

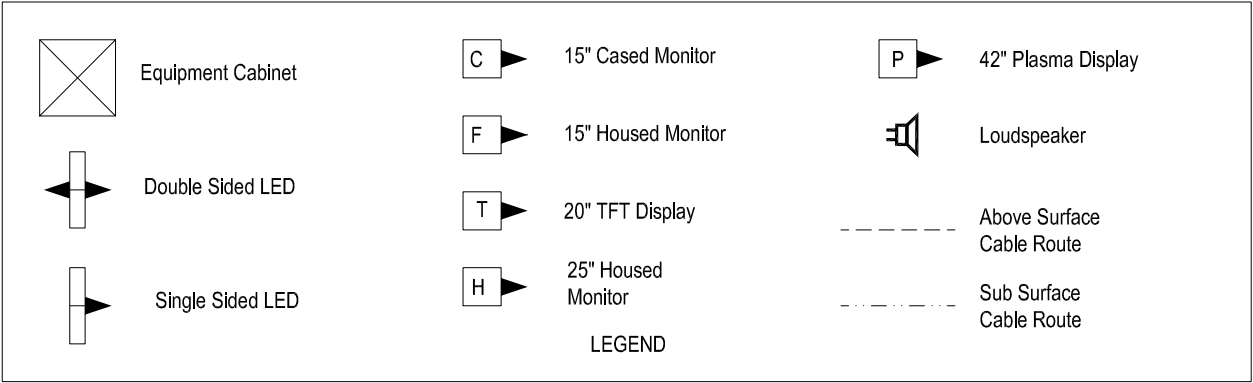

Equipment	Dist Board
CIS RACK	CCT NO 1
LED PT1/2	CCT NO 2
SPARE	CCT NO 3/4
* IN BASE OF EXT. CAB *	

All Equipment tags to be prefixed with "MBK-"

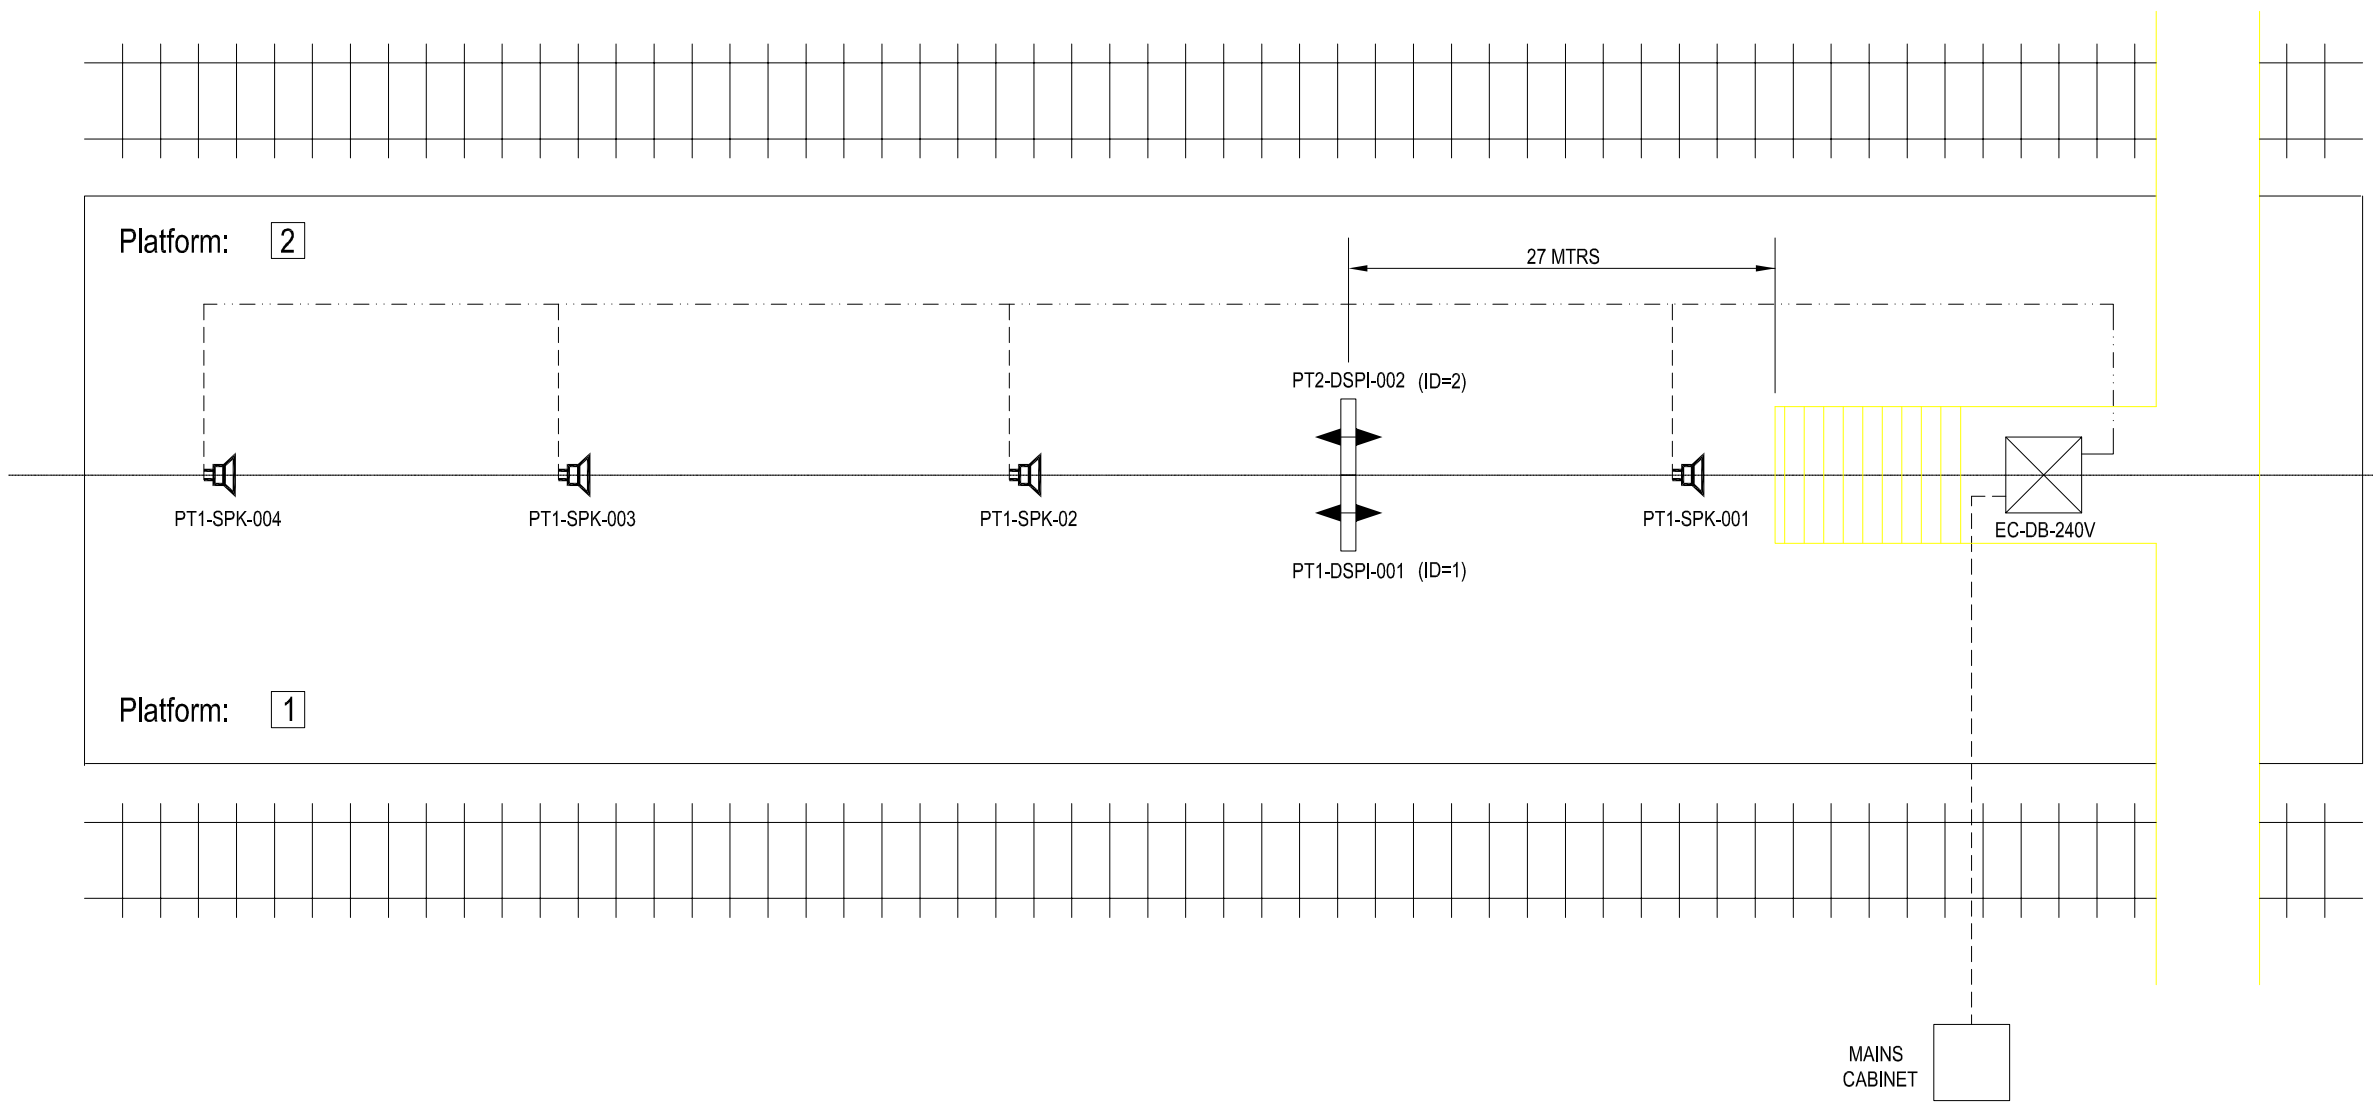

IF IN DOUBT ASK!

MATERIAL	CONSTRUCTION
FINISH	

	NAME	SIGNATURE	DATE
DRAWN BY	D GADDU		31-01-2002
CHECKED BY			
APPD BY			
APPD BY			
CAD Ref:			
CONTRACTOR'S Ref:			

AMEY DATEL Project  
Offices  
1st Floor, Platform  
2/3  
Eastleigh Station  
Southampton Road  
Eastleigh  
Hants  
SO50 9FL

COPYRIGHT © AMEY Rail  
All rights reserved. Neither this drawing or any of the information it contains may be copied or communicated to third parties without the written permission of the copyright holder

SITE/PROJECT		SOUTH WEST TRAINS CIS PROJECT	
TITLE		MILLBROOK AS BUILT	
SCALE	DRG No.	ISSUE	SHEET
NTS	SM803-75909	B	1 of 1