



WAN	
CIRCUIT ID	KXIP 100387
IP ADDRESS	10.227.176.1

"PLATFORM 1 HP ISDN"
01926-774116

All Equipment tags to be prefixed with "MIC-"

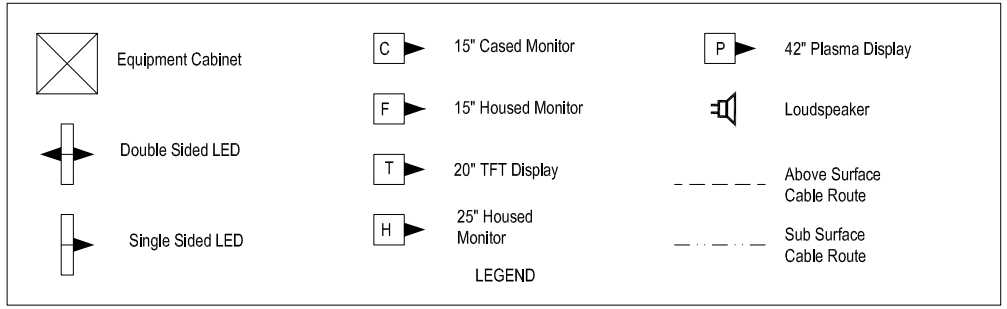

Equipment	Dist Board
CIS RACK	CCT NO. 1
LED RACK	DISTRIBUTION BOARD 2

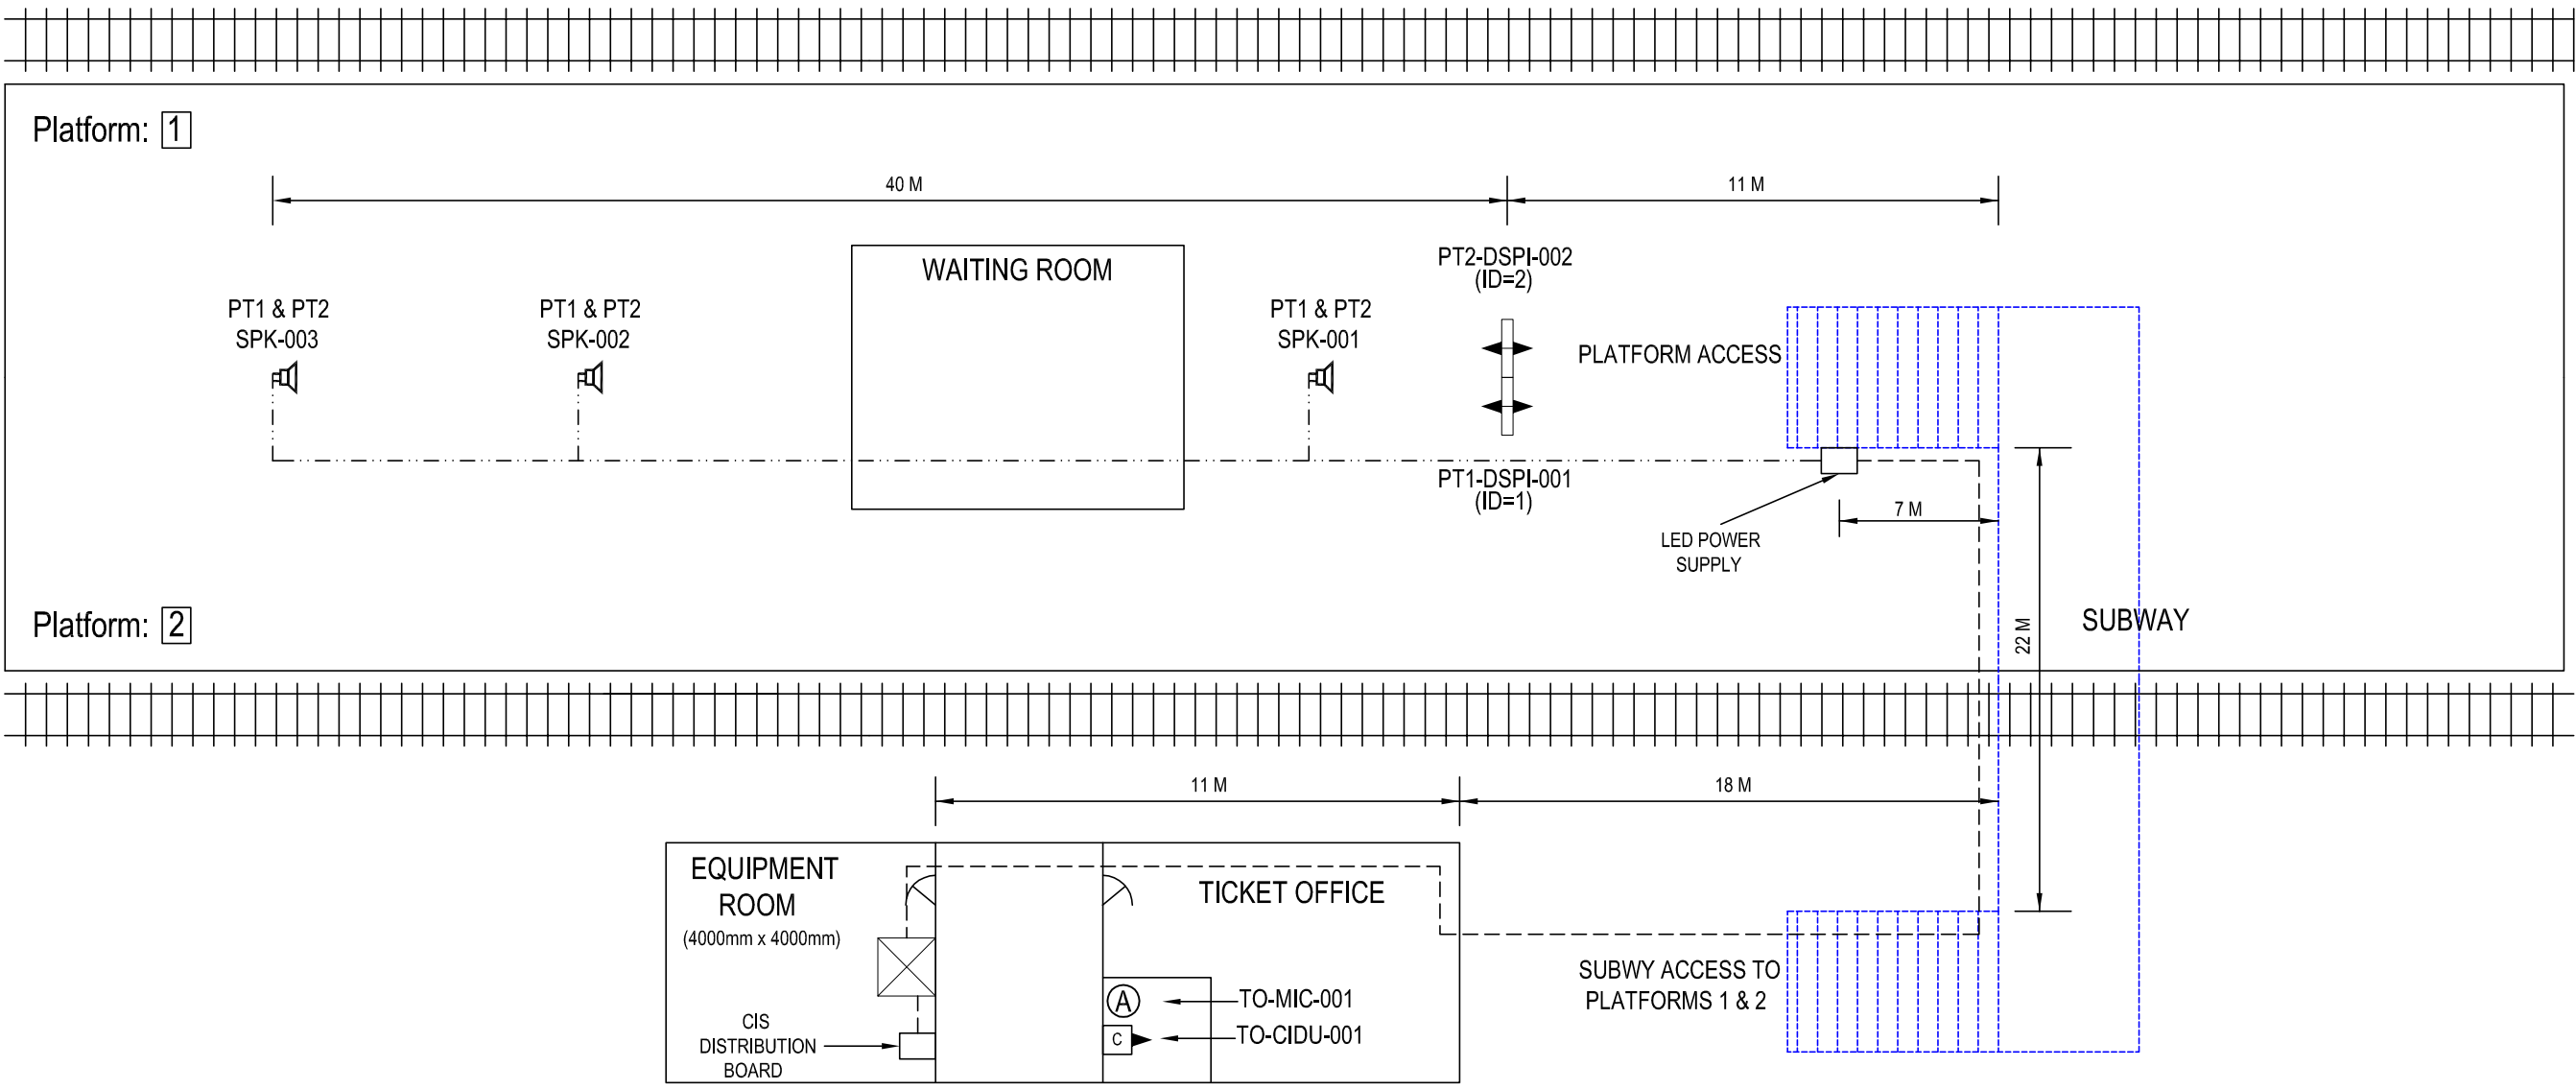

IF IN DOUBT ASK!

Date of Last Modification: 25 April 2003

This Drawing Supersedes Any Previous Drawings

CONSTRUCTION	NAME	SIGNATURE	DATE
DRAWN BY	D GADDU		25-04-2003
CHECKED BY	T WONG		
APPD BY	A SMITH		
APPD BY			
CAD Ref:			
CONTRACTOR'S Ref:			

AMEY DATEL Project  
 Offices  
 1st Floor, Platform  
 2/3  
 Eastleigh Station  
 Southampton Road  
 Eastleigh  
 Hants  
 SO50 9FL

COPYRIGHT © AMEY Rail  
 All rights reserved. Neither this drawing or any of the information it contains may be copied or communicated to third parties without the written permission of the copyright holder

SITE/PROJECT			
SOUTH WEST TRAINS CIS PROJECT			
TITLE			
MICHELDEVER AS BUILT			
SCALE	DRG No.	ISSUE	SHEET
NTS	SM803-75908	C	1 of 1