



WAN	
CIRCUIT ID	KXIP200511
IP ADDRESS	10.227.181.1

"PLATFORM 1 HP ISDN"
020-8336-1036

All Equipment tags to be prefixed with "MOT-"

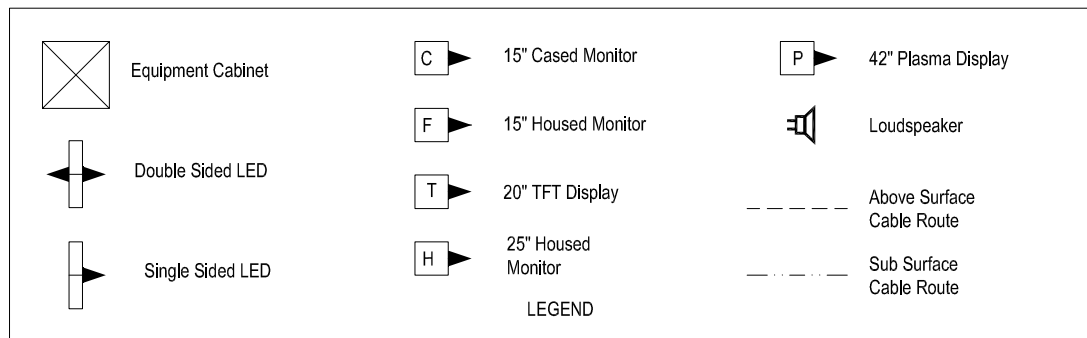


Equipment	Dist Board
PT1-DSPI-001	GP1 CCT 1
PT1-DSPI-002	GP1 CCT 7
PT2-DSPI-003	GP1 CCT 7
CIS RACK	GP1 CCT 2
TO-CIDU-003	EXISTING SPUR USED

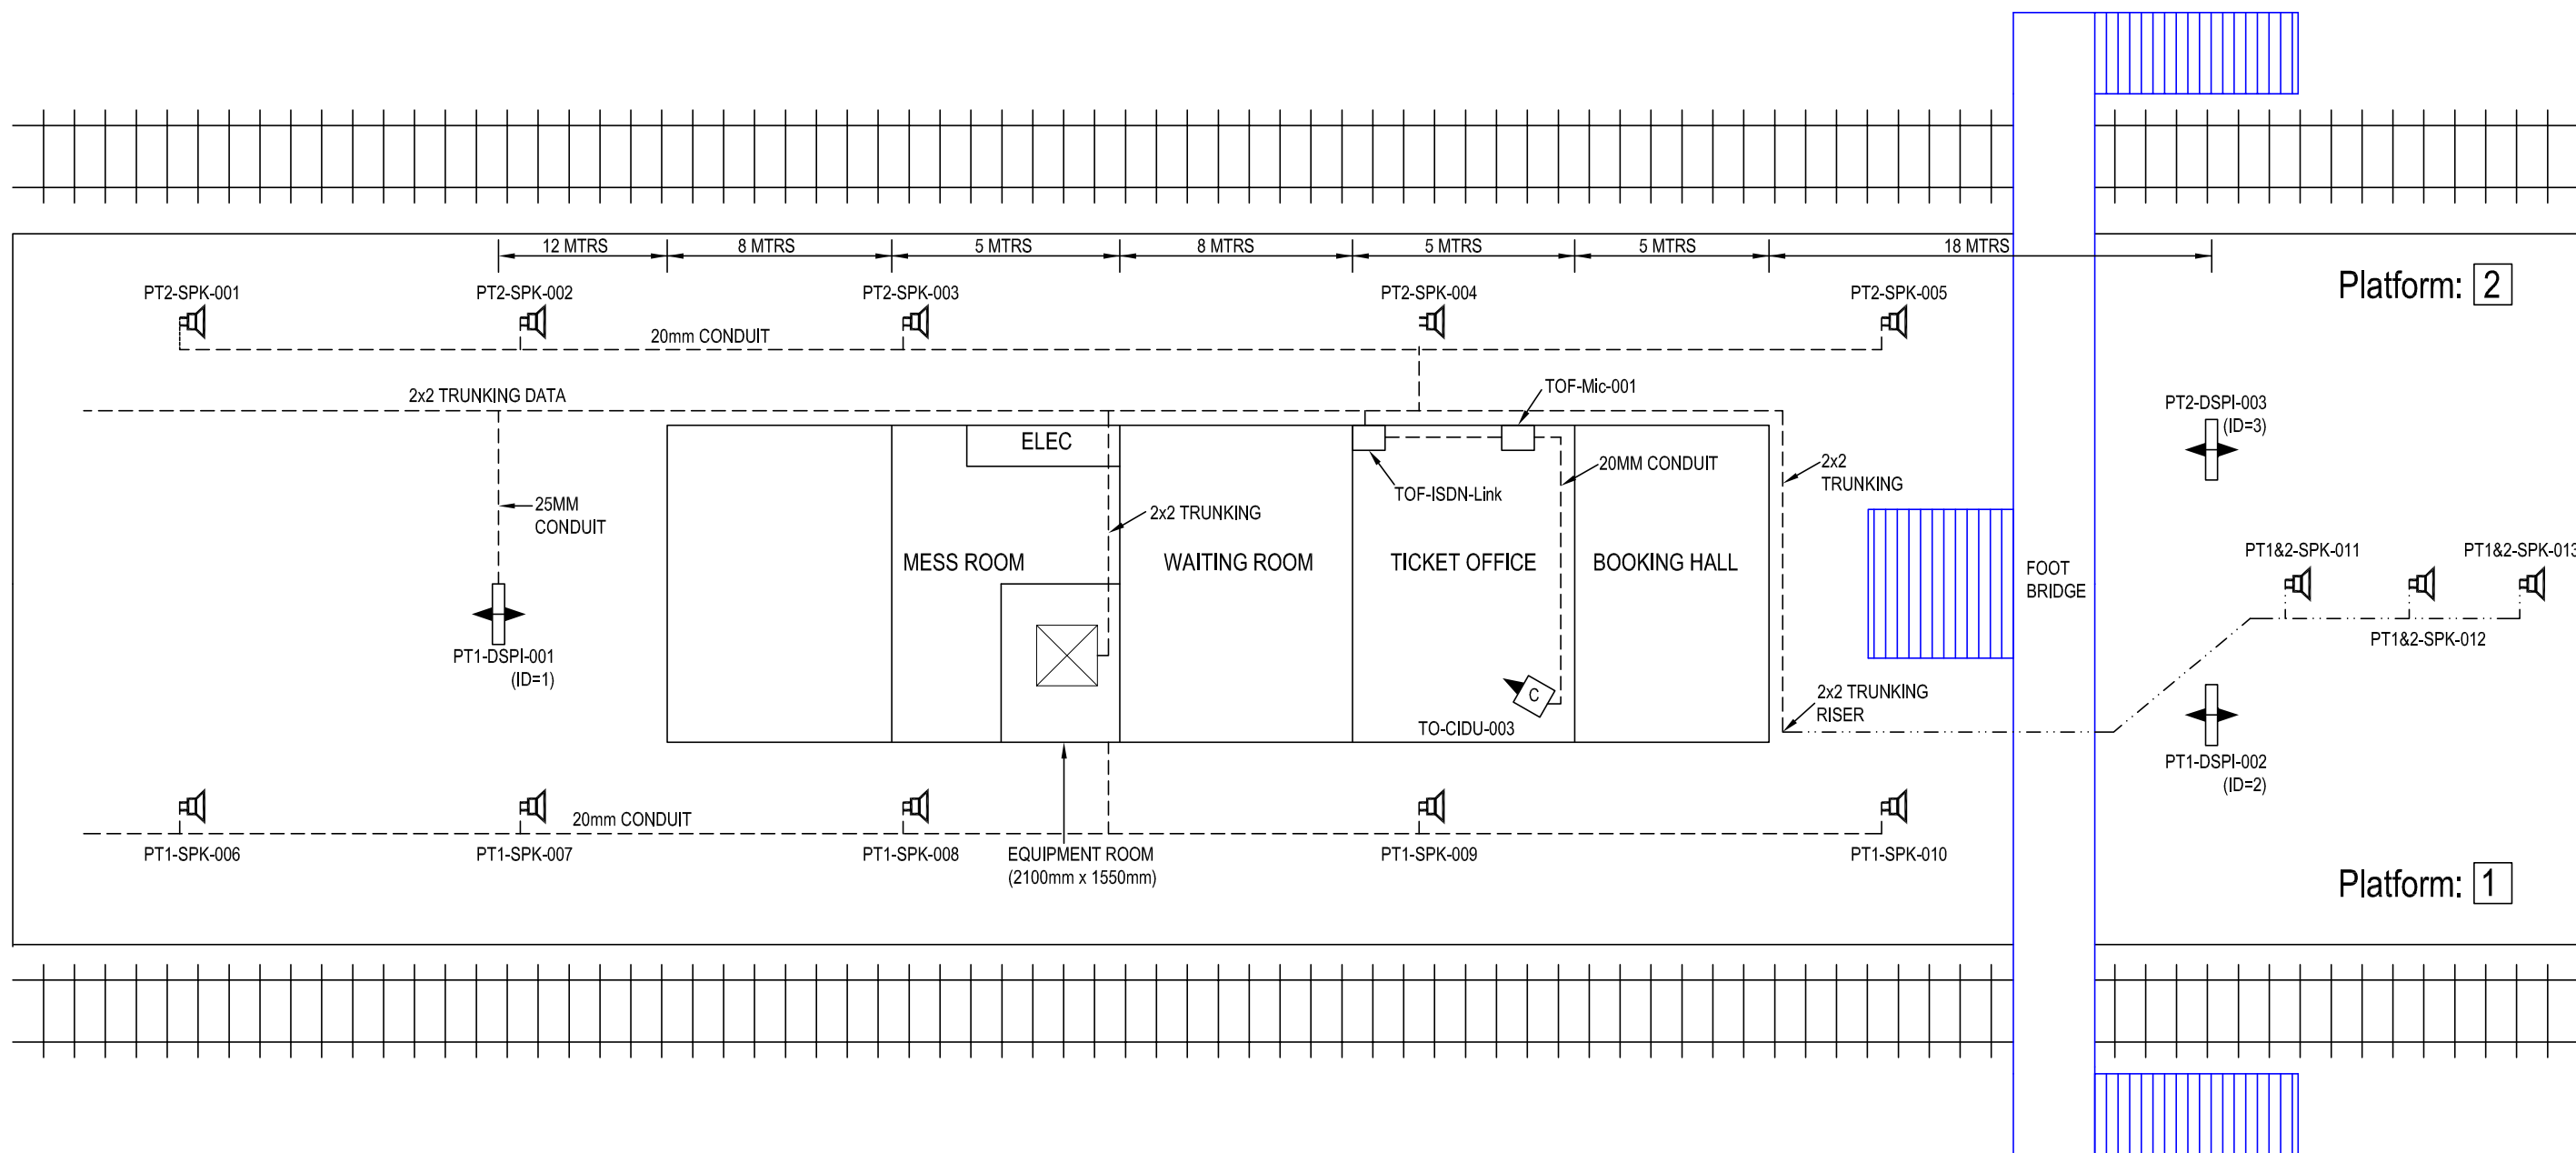

IF IN DOUBT ASK!

MATERIAL	CONSTRUCTION
FINISH	

	NAME	SIGNATURE	DATE
DRAWN BY	D GADDU		13-06-01
CHECKED BY	T WONG		
APPD BY	A SMITH		
APPD BY			
CAD Ref:			
CONTRACTOR'S Ref:			



AMEY DATEL Project Offices
1st Floor, Platform 2/3
Eastleigh Station
Southampton Road
Eastleigh
Hants
SO50 9FL

COPYRIGHT © AMEY Rail
All rights reserved. Neither this drawing or any of the information it contains may be copied or communicated to third parties without the written permission of the copyright holder

SITE/PROJECT			
SOUTH WEST TRAINS CIS PROJECT			
TITLE			
MOTSPUR PARK AS BUILT			
SCALE	DRG No.	ISSUE	SHEET
NTS	SM803-75645	B	1 of 1