



WAN	
CIRCUIT ID	KXIP 200510
IP ADDRESS	10.227.180.21

"PLATFORM 1 HP ISDN"
0208-3921158
"PLATFORM 2 HP ISDN"
0208-3921217

All Equipment tags to be prefixed with "MTL-"

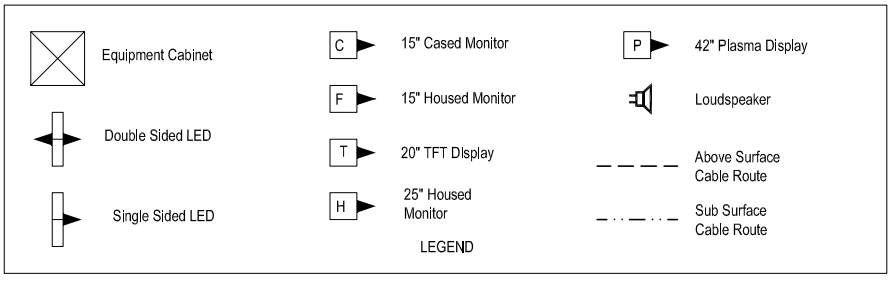


Equipment	Dist Board
CIS RACK	NEW DB FROM MDB1 R5
PT1-DSPI-001	NEW DB R3
PT2-SSPI-002	EXISTING SUPPLY
PT2-SSPI-003	EXISTING SUPPLY
PT2-DSPI-004	DB1A

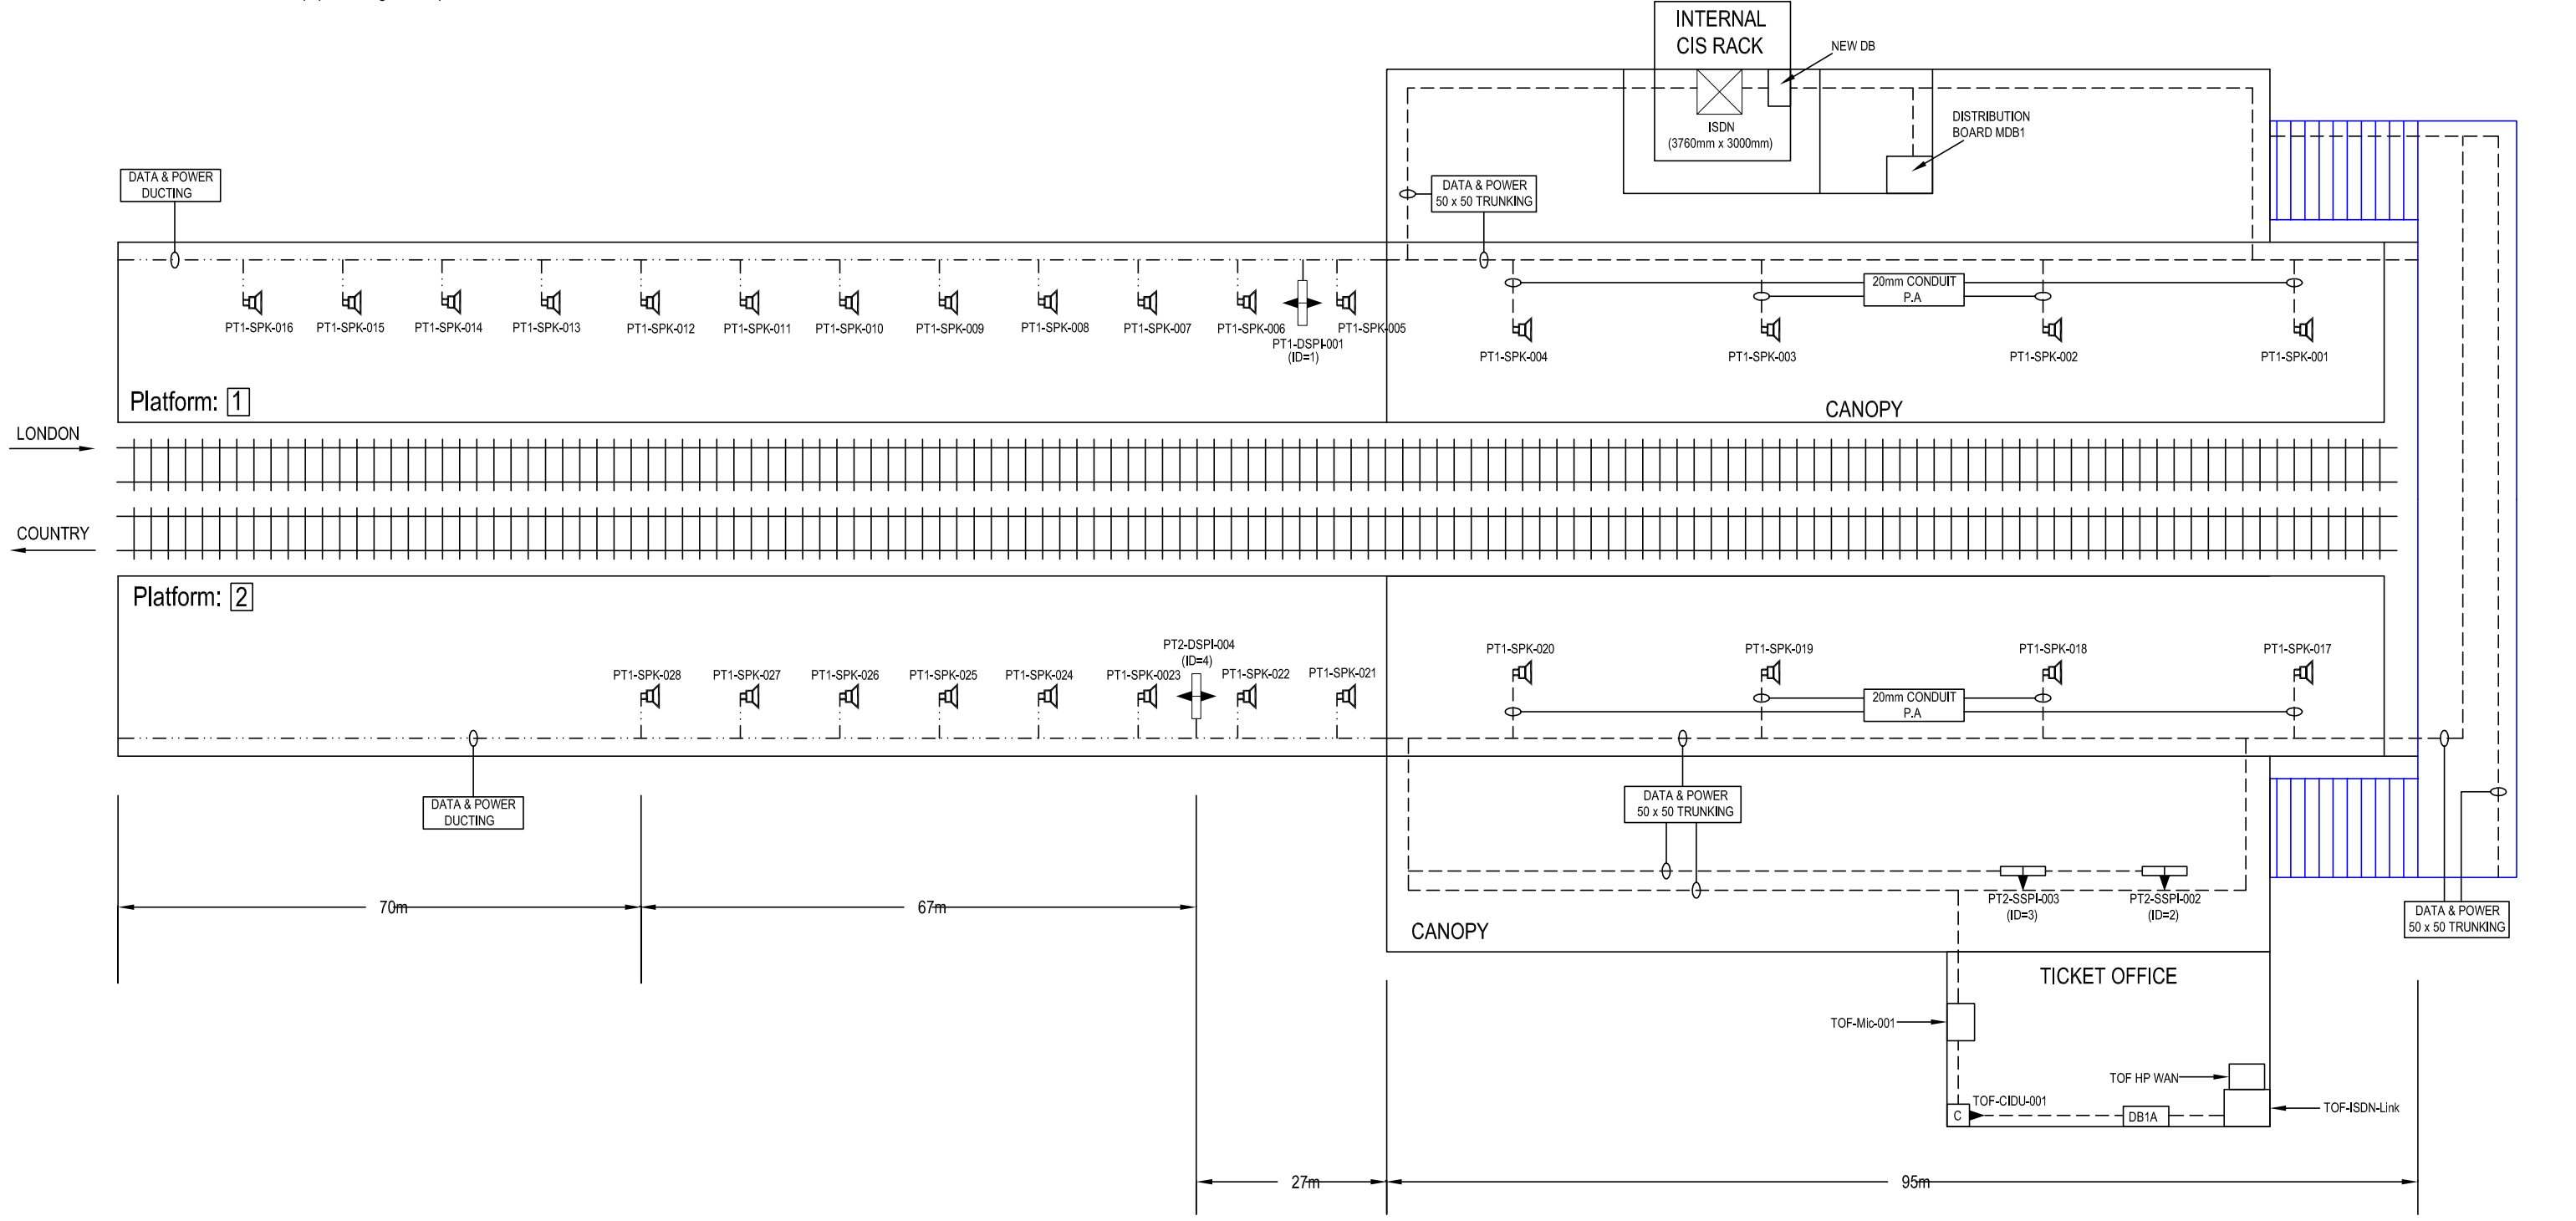

IF IN DOUBT ASK!

MATERIAL	CONSTRUCTION
FINISH	

	NAME	SIGNATURE	DATE
DRAWN BY	D GADDU		10-04-2002
CHECKED BY	T WONG		
APPD BY	A SMITH		
APPD BY			
CAD Ref:			
CONTRACTOR'S Ref:			



AMEY DATEL Project
 Offices
 1st Floor, Platform
 2/3
 Eastleigh Station
 Southampton Road
 Eastleigh
 Hants
 SO50 9FL

COPYRIGHT © AMEY Rail
 All rights reserved. Neither this drawing or any of the information it contains may be copied or communicated to third parties without the written permission of the copyright holder

SITE/PROJECT		SOUTH WEST TRAINS CIS PROJECT	
TITLE		MORTLAKE AS BUILT	
SCALE	DRG No.	ISSUE	SHEET
NTS	SM803-75600	B	1 of 1