



WAN	
CIRCUIT ID	KXIP200513
IP ADDRESS	10.227.183.1

"PLATFORM 1 HP ISDN"
020-8336-1104
"PLATFORM 2 HP ISDN"
020-8336-1136

All Equipment tags to be prefixed with "NEM-"

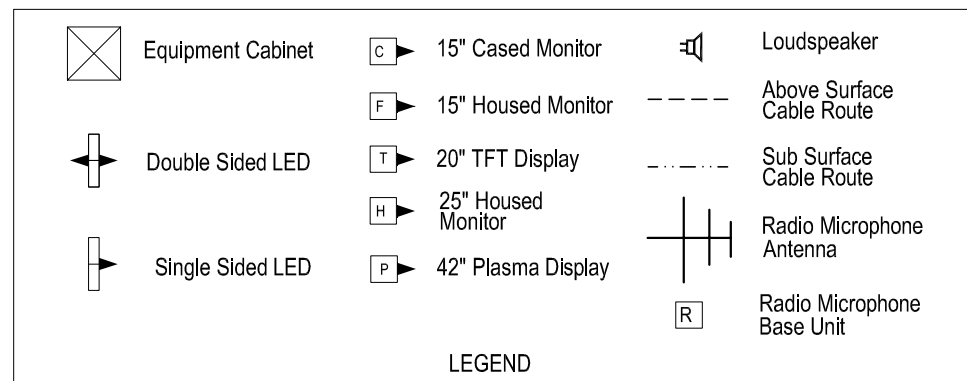

Equipment	Dist Board
TOF-CIDU-001	
PT1-DSPI-001	GP1
PT1-DSPI-002	GP1
PT2-DSPI-003	GP1
PT3-DSPI-004	
PT4-DSPI-005	

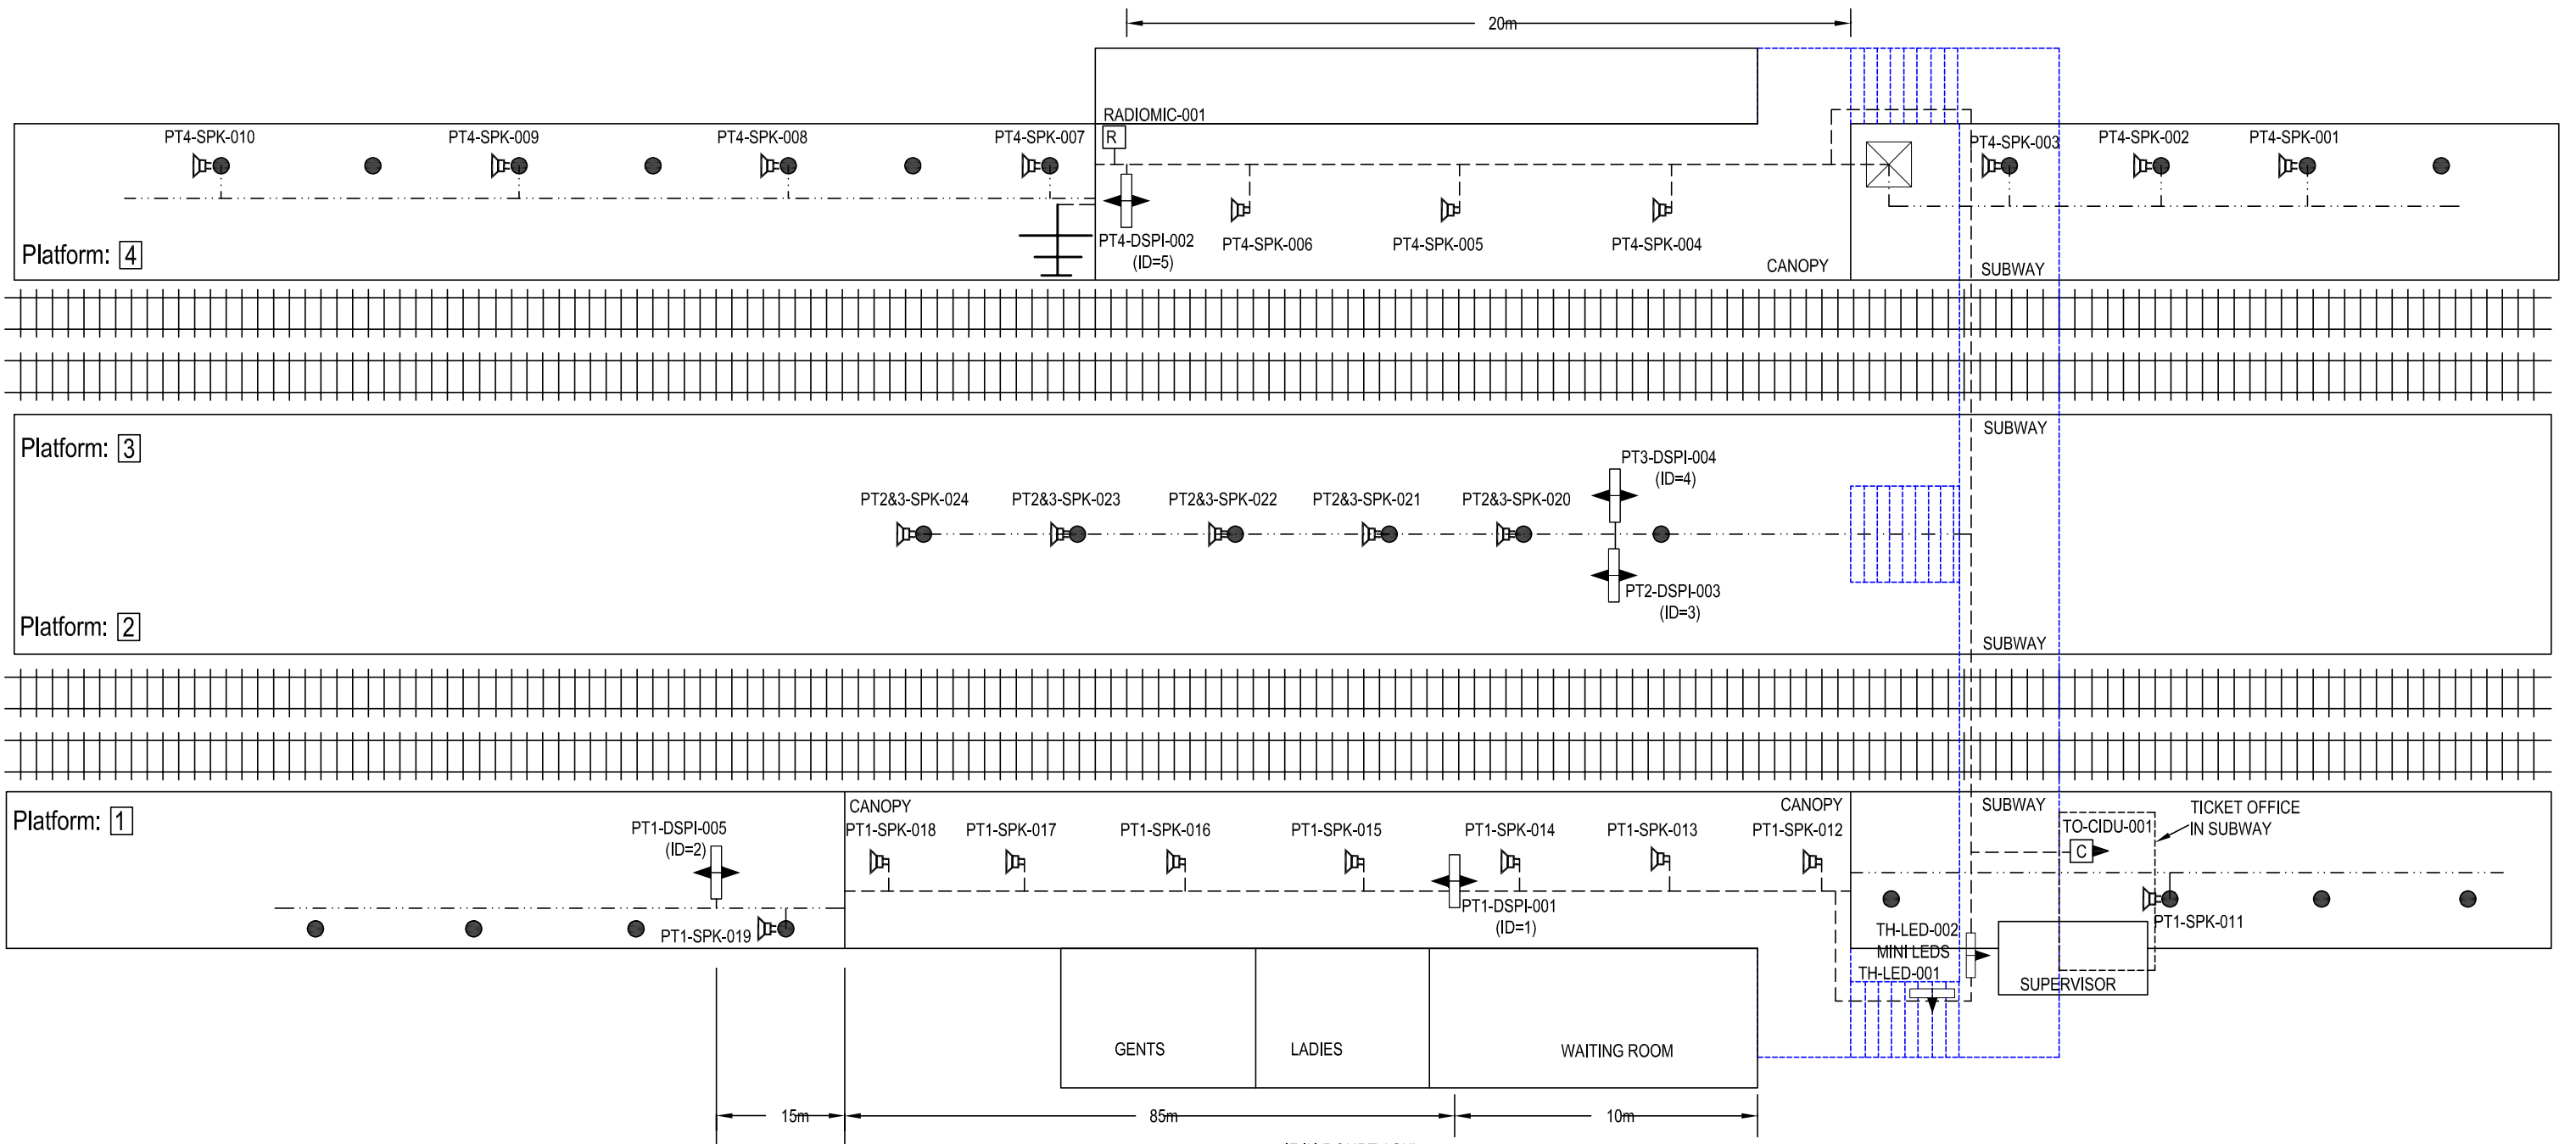

Date of Last Modification: 25 April 2003	CONSTRUCTION	<table border="1"> <thead> <tr> <th></th> <th>NAME</th> <th>SIGNATURE</th> <th>DATE</th> </tr> </thead> <tbody> <tr> <td>DRAWN BY</td> <td>J STEVENS</td> <td></td> <td>25-05-2003</td> </tr> <tr> <td>CHECKED BY</td> <td>T WONG</td> <td></td> <td></td> </tr> <tr> <td>APPD BY</td> <td>A SMITH</td> <td></td> <td></td> </tr> <tr> <td>APPD BY</td> <td></td> <td></td> <td></td> </tr> </tbody> </table>		NAME	SIGNATURE	DATE	DRAWN BY	J STEVENS		25-05-2003	CHECKED BY	T WONG			APPD BY	A SMITH			APPD BY				<p>AMEY DATEL Project Offices 1st Floor, Platform 2/3 Eastleigh Station Southampton Road Eastleigh Hants SO50 9FL</p>	SITE/PROJECT		SOUTH WEST TRAINS CIS PROJECT	
			NAME	SIGNATURE	DATE																						
DRAWN BY	J STEVENS		25-05-2003																								
CHECKED BY	T WONG																										
APPD BY	A SMITH																										
APPD BY																											
<p>This Drawing Supersedes Any Previous Drawings</p>	<p>IF IN DOUBT ASK!</p>	<p>CAD Ref:</p> <p>CONTRACTOR'S Ref:</p>	<p>COPYRIGHT © AMEY Rail All rights reserved. Neither this drawing or any of the information it contains may be copied or communicated to third parties without the written permission of the copyright holder</p>	TITLE		NEW MALDEN AS BUILT																					
				FINISH	SCALE	DRG No.	ISSUE	SHEET																			
				NTS	SM803-75567	C	1 of 1																				