




WAN	
CIRCUIT ID	KXIP 200516
IP ADDRESS	10.227.186.31

"PLATFORM 1 HP ISDN"
0208-8781795

All Equipment tags to be prefixed with "NSH-"

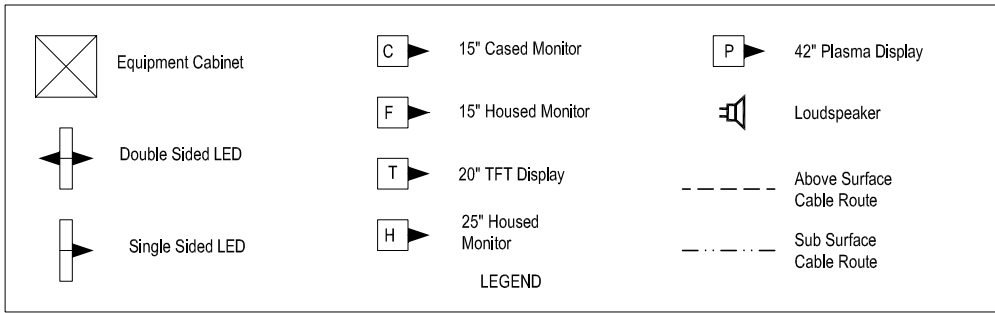


Equipment	Dist Board	
CIS RACK	GP1	C1 15A MCB
PT1-DSPI-001	GP1	C12 20A MCB
PT2-DSPI-002	GP1	C12 20A MCB
TOF-CIDU-001	GP1	C8 15A MCB

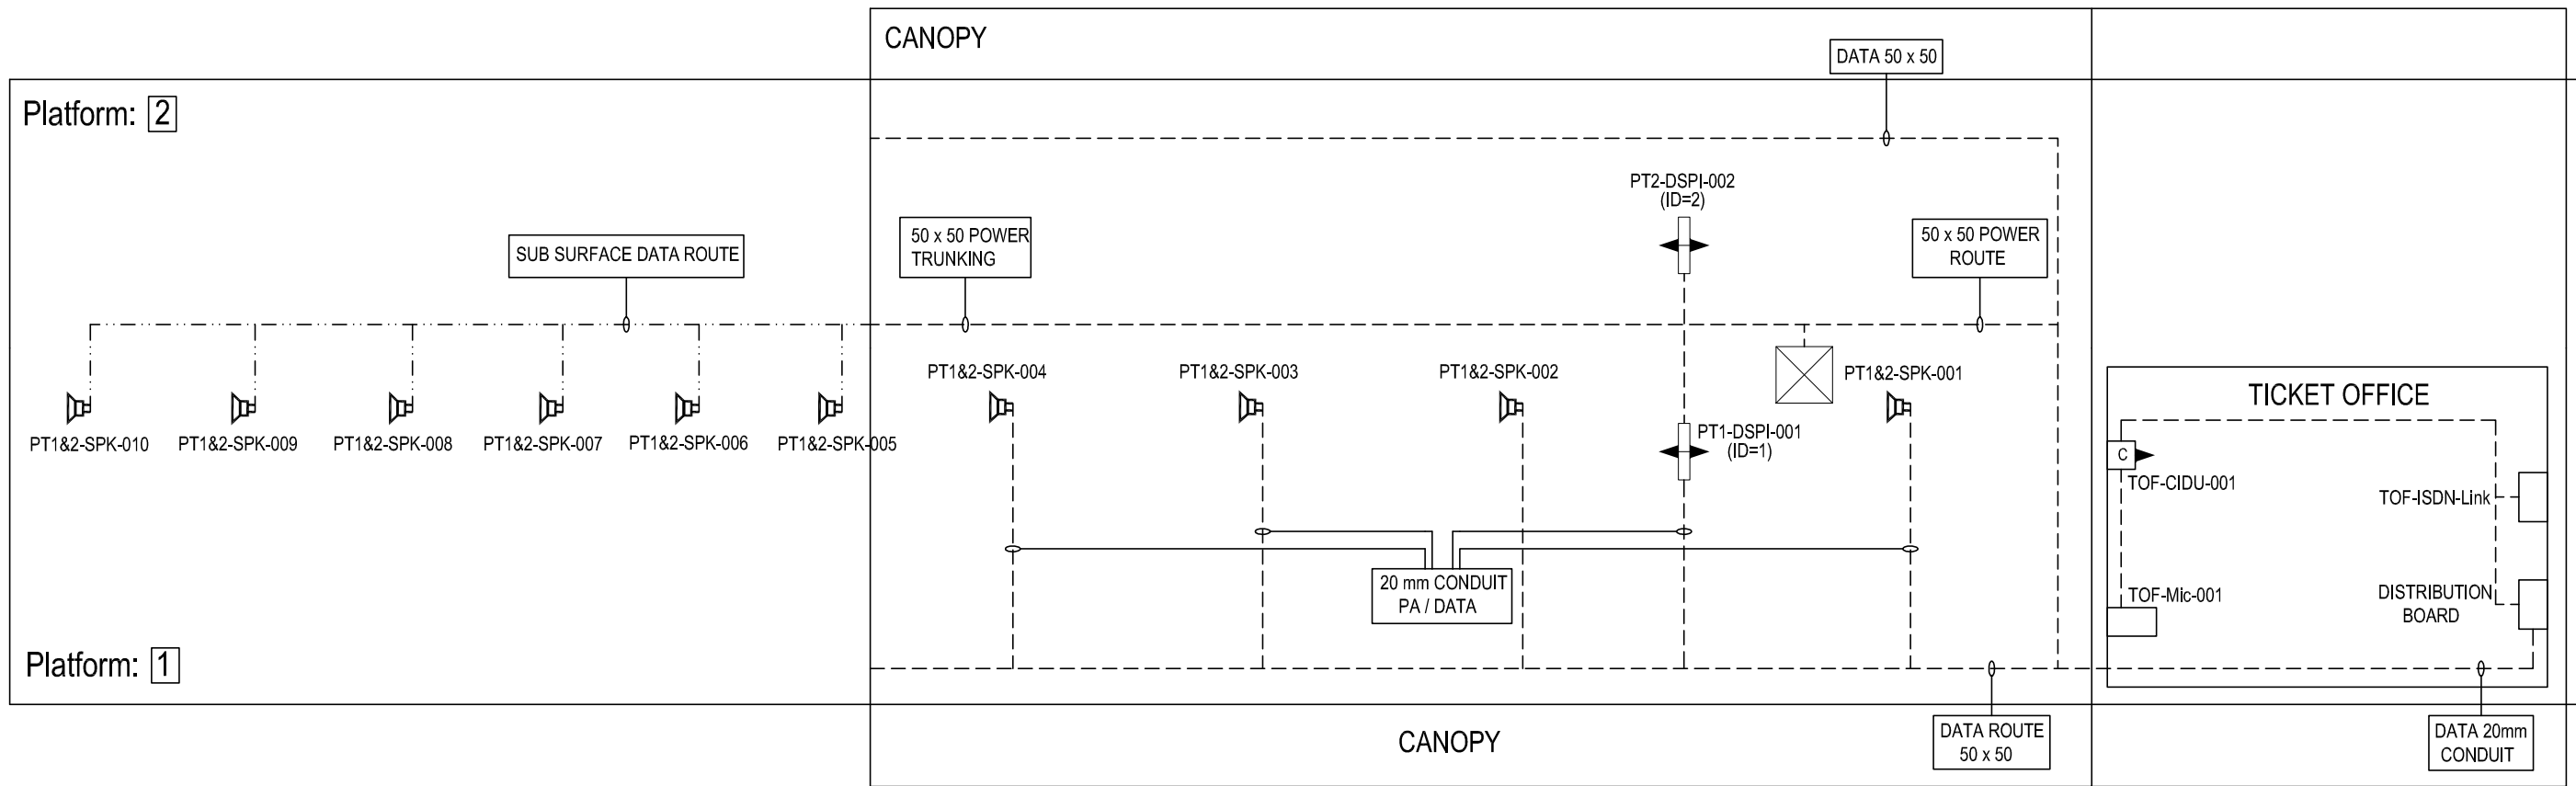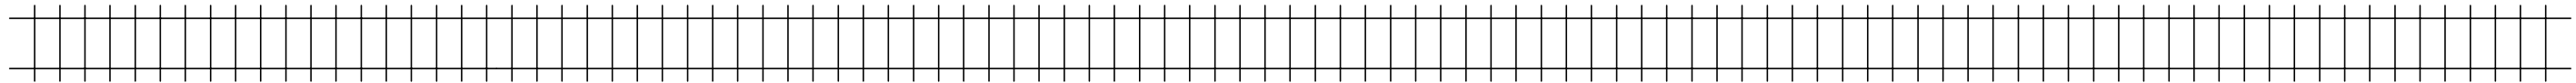

IF IN DOUBT ASK!

MATERIAL	CONSTRUCTION
FINISH	

	NAME	SIGNATURE	DATE
DRAWN BY	D GADDU		05-04-2002
CHECKED BY	T WONG		
APPD BY	A SMITH		
APPD BY			
CAD Ref:			
CONTRACTOR'S Ref:			



AMEY DATEL Project  
 Offices  
 1st Floor, Platform  
 2/3  
 Eastleigh Station  
 Southampton Road  
 Eastleigh  
 Hants  
 SO50 9FL

COPYRIGHT © AMEY Rail  
 All rights reserved. Neither this drawing or any of the information it contains may be copied or communicated to third parties without the written permission of the copyright holder

SITE/PROJECT		SOUTH WEST TRAINS CIS PROJECT	
TITLE		NORTH SHEEN AS BUILT	
SCALE	DRG No.	ISSUE	SHEET
NTS	SM803-75601	B	1 of 1