



WAN	
CIRCUIT ID	KXIP200518
IP ADDRESS	10.227.188.1

"PLATFORM 1 HP ISDN"
01-372-842323
"PLATFORM 2 HP ISDN"
01-372-842786

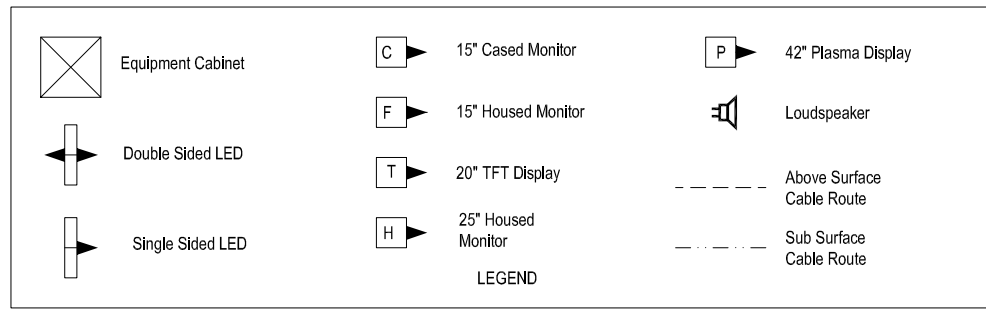


Equipment	Dist Board
PT1-DSPI-001	GP1 CCT 3
TH-HIDU-001	GP1 CCT 3
PT2-DSPI-002	GLASDON CCT 5
CIS RACK	GLASDON CCT 6

All Equipment tags to be prefixed with "OXS-"

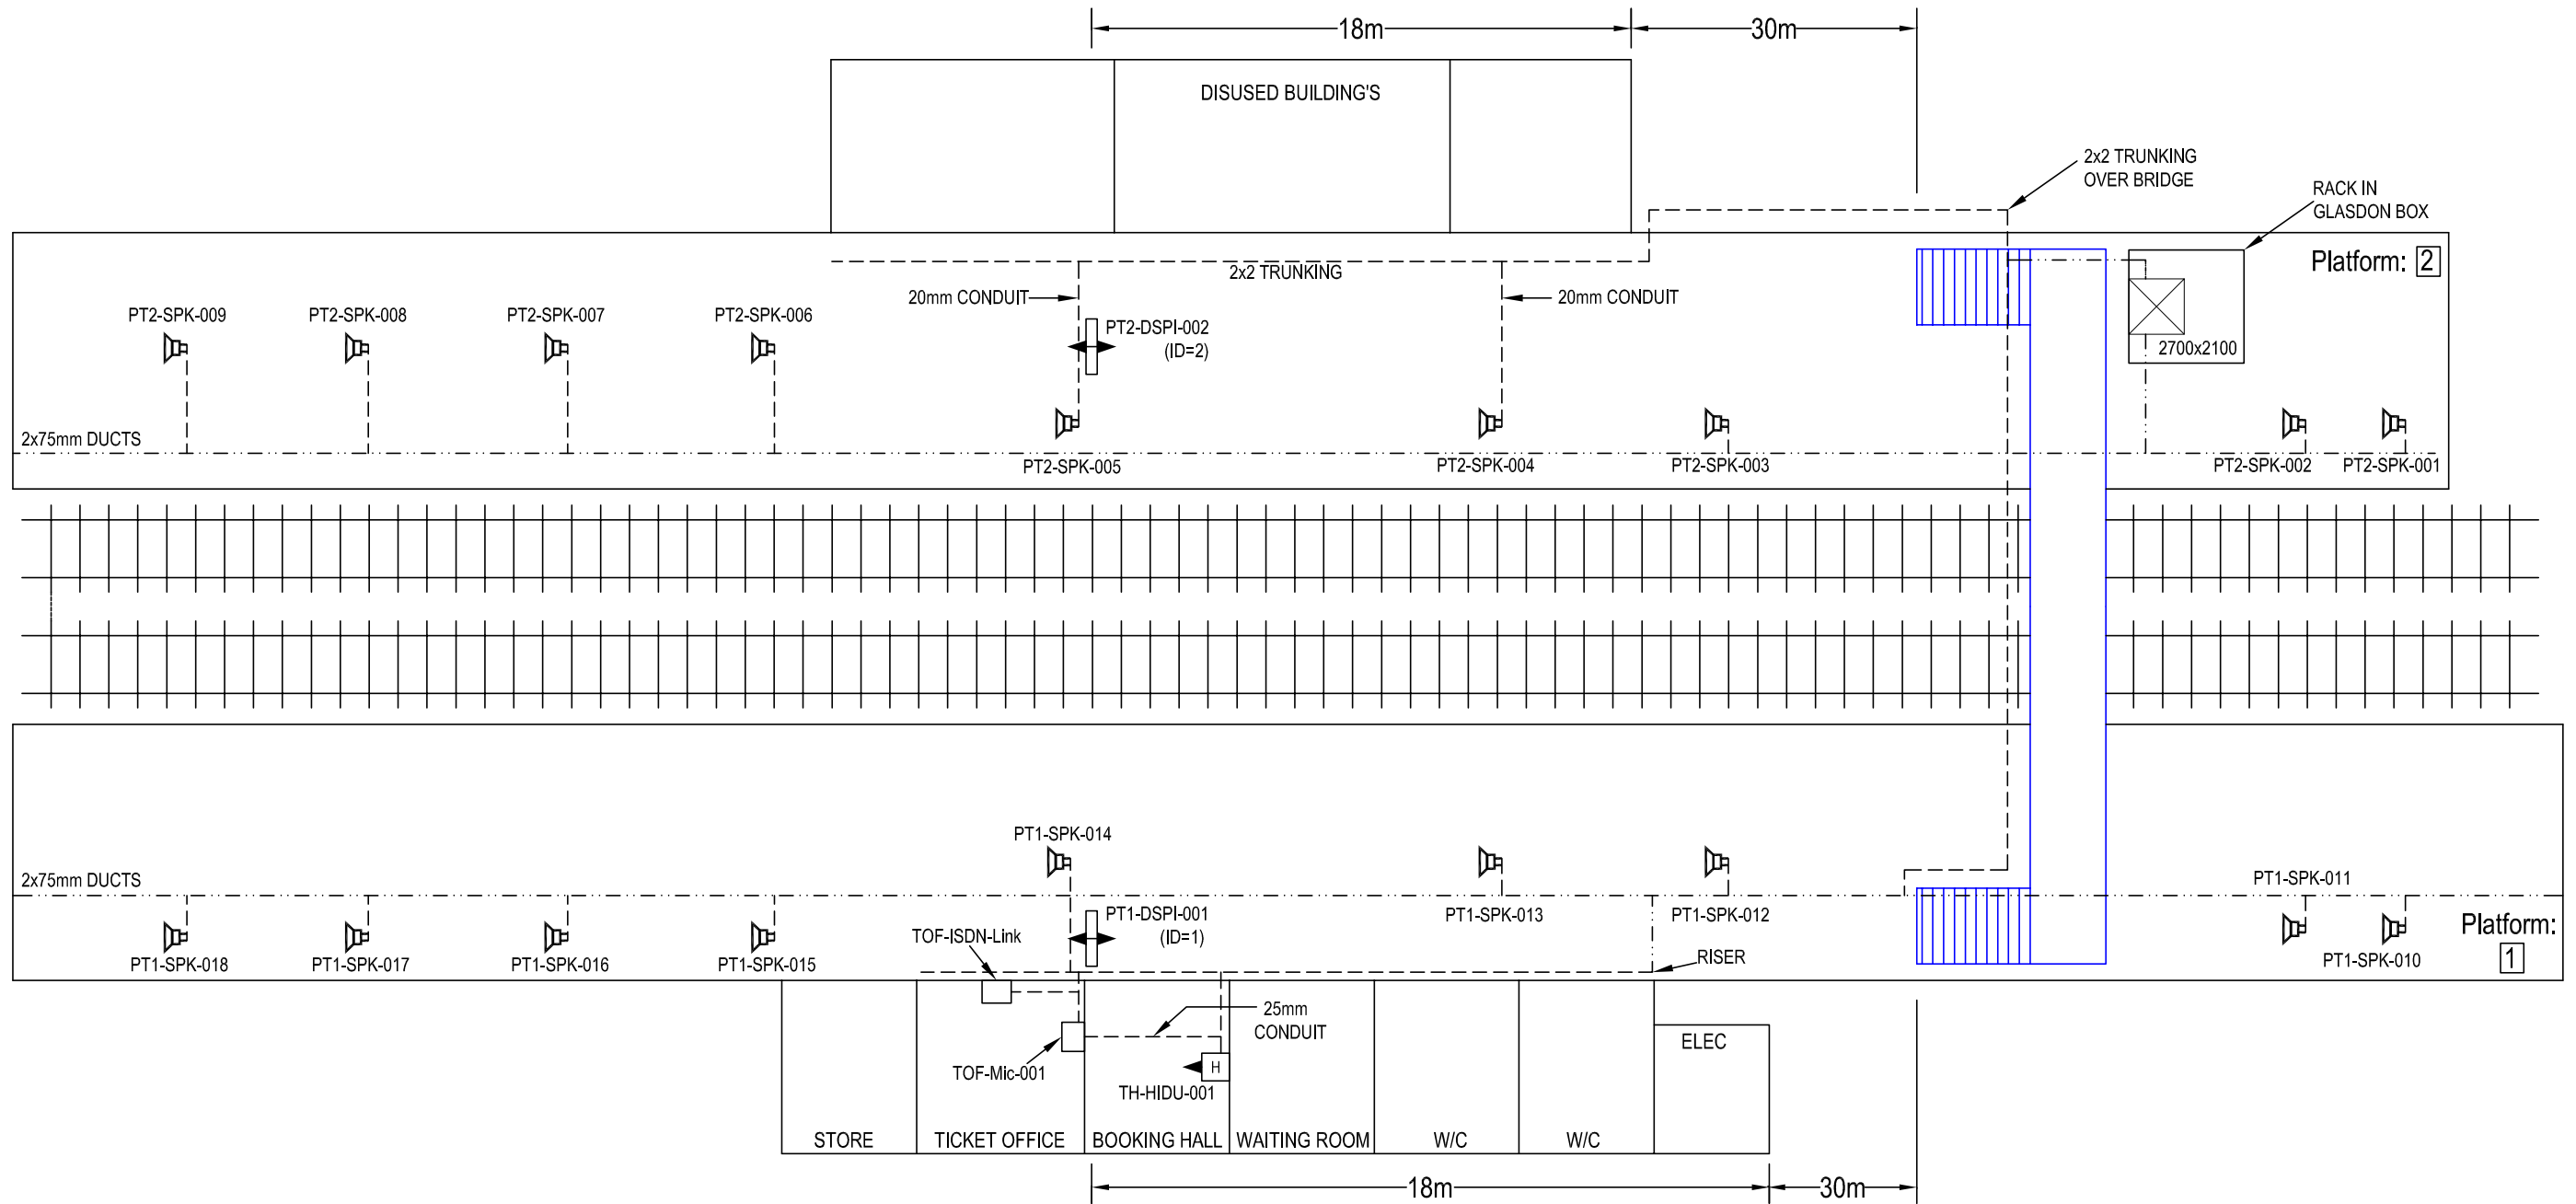

IF IN DOUBT ASK!

MATERIAL	CONSTRUCTION	NAME	SIGNATURE	DATE	 AMEY DATEL Project Offices 1st Floor, Platform 2/3 Eastleigh Station Southampton Road Eastleigh Hants SO50 9FL	SITE/PROJECT			
		DRAWN BY	D GADDU	14-05-2002		SOUTH WEST TRAINS CIS PROJECT			
		CHECKED BY	T WONG			TITLE			
		APPD BY	A SMITH			OXSHOTT AS BUILT			
FINISH	CONSTRUCTION	CAD Ref:			COPYRIGHT © AMEY Rail All rights reserved. Neither this drawing or any of the information it contains may be copied or communicated to third parties without the written permission of the copyright holder	SCALE	DRG No.	ISSUE	SHEET
		CONTRACTOR'S Ref:				NTS	SM803-75602	B	1 of 1