


DRG No. SM803-75757


WAN	
CIRCUIT ID	KXIP 600374
IP ADDRESS	10.227.190.1

"PLATFORM 1 HP ISDN"
01392-460501
"PLATFORM 2 HP ISDN"
01392-460504

All Equipment tags to be prefixed with "PIN-"

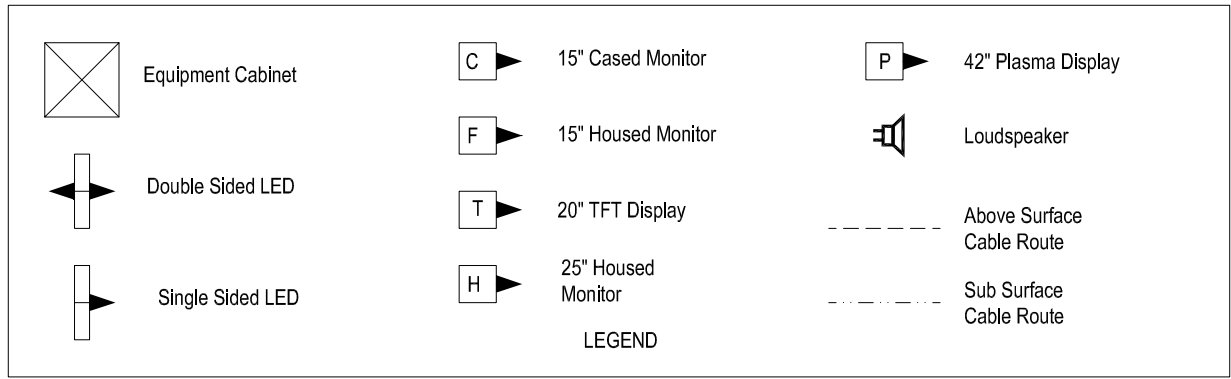

Equipment	Dist Board
CIS CAB	CCT NO. 1
LED PT2	CCT NO. 2
LED PT1	CCT NO. 3
SPARE	CCT NO. 4

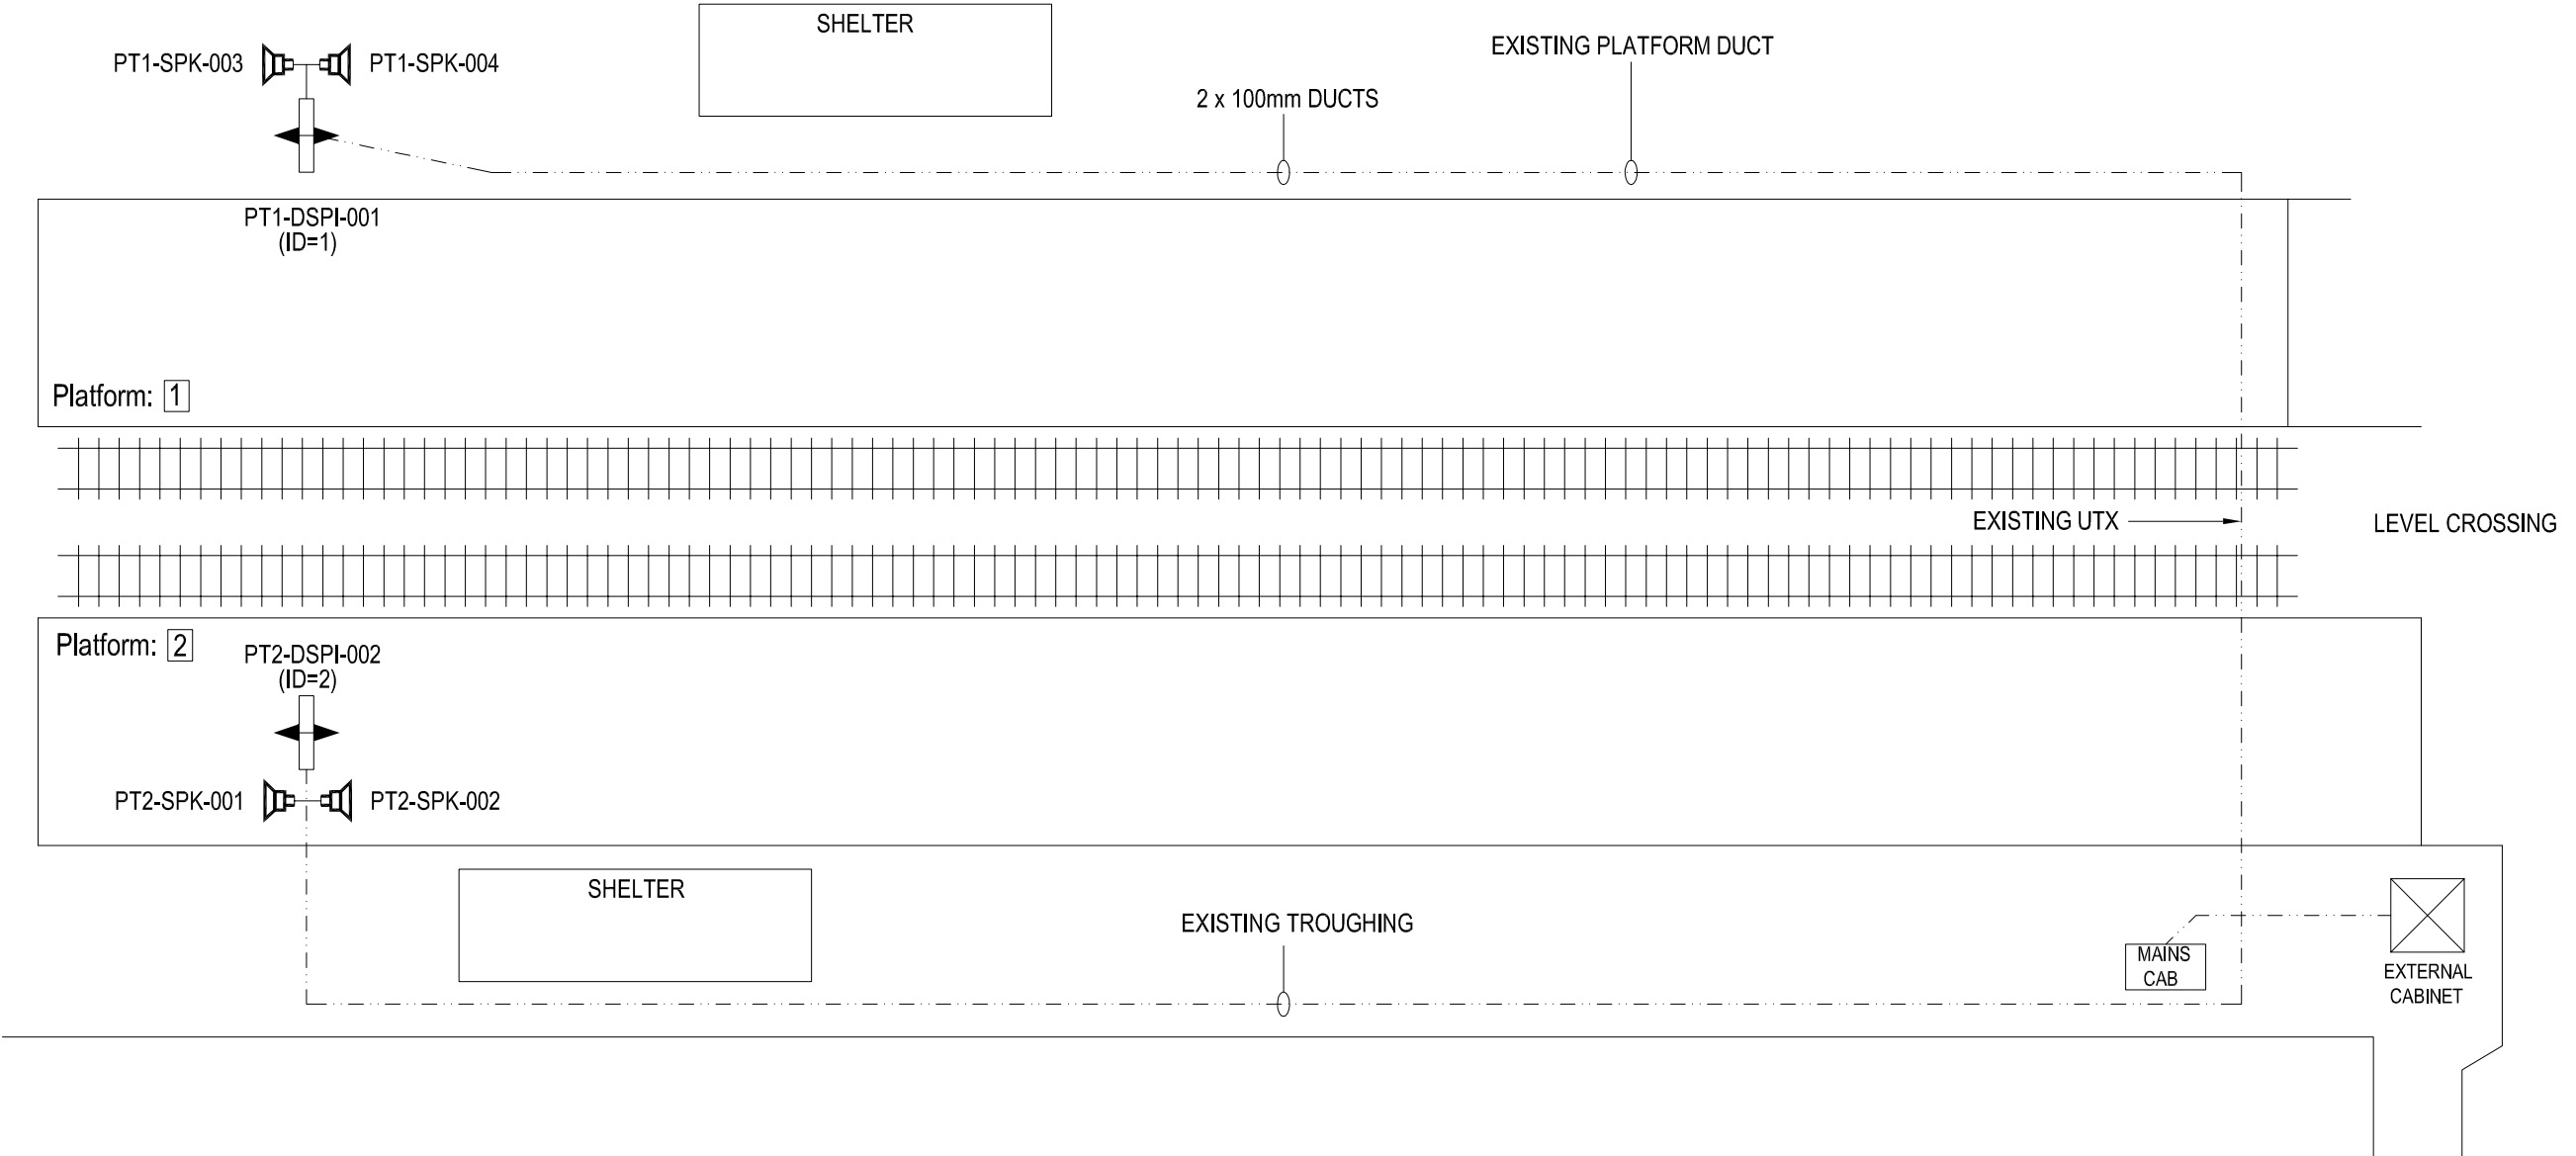

IF IN DOUBT ASK!

MATERIAL	CONSTRUCTION	DRAWN BY	D GADDU	SIGNATURE		<p>AMEY DATEL Project Offices 1st Floor, Platform 2/3 Eastleigh Station Southampton Road Eastleigh Hants SO50 9FL</p>	SITE/PROJECT		SOUTH WEST TRAINS CIS PROJECT	
		CHECKED BY	T WONG	DATE	15-03-2002		TITLE		PINHOE AS BUILT	
FINISH	CONSTRUCTION	APPD BY				<p>COPYRIGHT © AMEY Rail All rights reserved. Neither this drawing or any of the information it contains may be copied or communicated to third parties without the written permission of the copyright holder</p>	SCALE	DRG No.	ISSUE	SHEET
		CONTRACTOR'S Ref:					NTS	SM803-75757	B	1 of 1