



WAN	
CIRCUIT ID	KXIP 200519
IP ADDRESS	10.227.189.1

"PLATFORM 1 HP ISDN"
01-202-749774
"PLATFORM 2 HP ISDN"
01-202-74979


All Equipment tags to be prefixed with "PKS-"

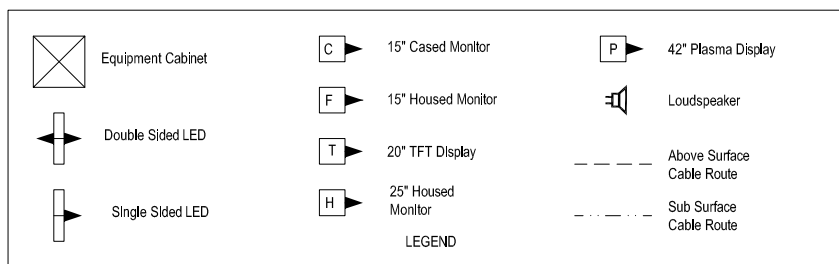

Equipment	Dist Board
SPARE	CCT NO.1
13A TWIN	CCT NO.2
HEATER	CCT NO.3
CIS RACK	CCT NO.4
LED 1	CCT NO.5
CRT	CCT NO.6
LED 2	CCT NO.7
SPARE	CCT NO.8

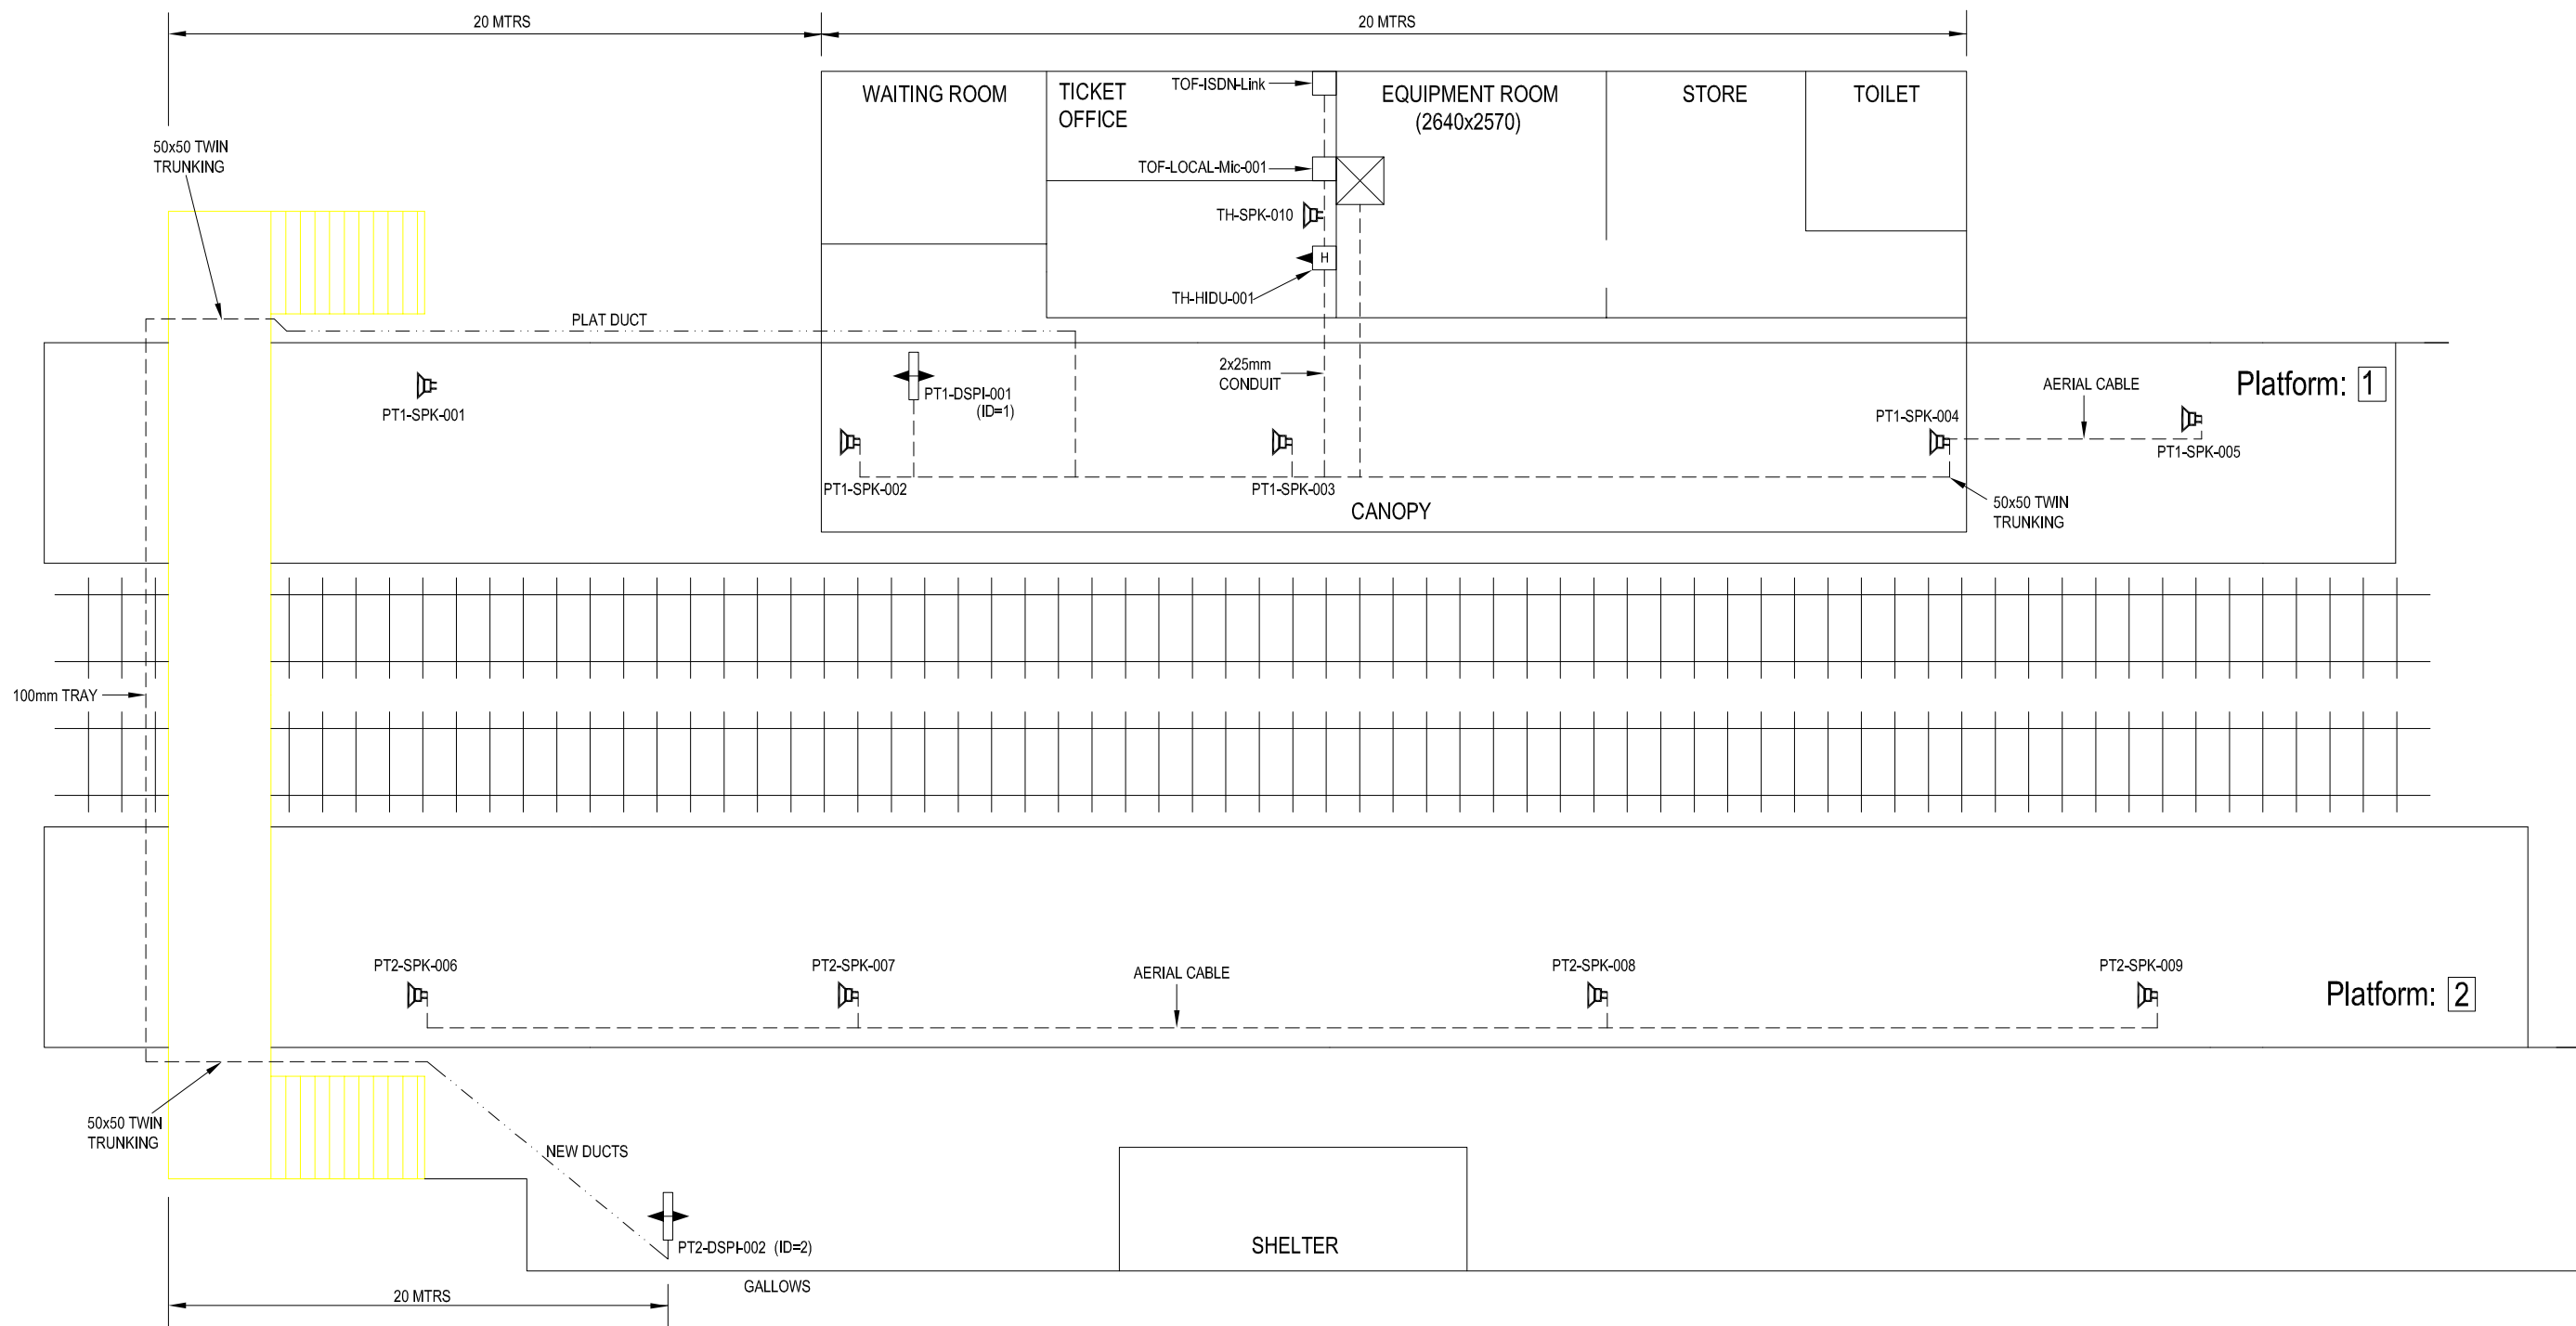

IF IN DOUBT ASK!

MATERIAL	CONSTRUCTION	NAME	SIGNATURE	DATE	 <p>AMEY DATEL Project Offices 1st Floor, Platform 2/3 Eastleigh Station Southampton Road Eastleigh Hants SO50 9FL</p>	SITE/PROJECT		
		DRAWN BY	D GADDU	24-01-2002		SOUTH WEST TRAINS CIS PROJECT		
FINISH		CHECKED BY			<p>Copyright © AMEY Rail All rights reserved. Neither this drawing or any of the information it contains may be copied or communicated to third parties without the written permission of the copyright holder</p>	TITLE		
		APPD BY				PARKSTONE AS BUILT		
		CAD Ref:			SCALE	DRG No.	ISSUE	SHEET
		CONTRACTOR'S Ref:			NTS	SM803-75882	B	1 of 1