

WAN	
CIRCUIT ID	MXIP201586
IP ADDRESS	10.227.55.1


All Equipment tags to be prefixed with "POH-"

"PLATFORM 1 HP ISDN"	02-392-833875
"PLATFORM 3 HP ISDN"	02-392-833853
"PLATFORM 4 HP ISDN"	02-392-833858

LEGEND

	Equipment Cabinet		15" Cased Monitor		Loudspeaker
	Double Sided LED		15" Housed Monitor		Above Surface Cable Route
	Single Sided LED		20" TFT Display		Sub Surface Cable Route
			25" Housed Monitor		Radio Microphone Antenna
			42" Plasma Display		Radio Microphone Base Unit

Equipment	Dist Board
LED'S ON EXISTING SUPPLIES	
CRT'S ON EXISTING SUPPLIES	

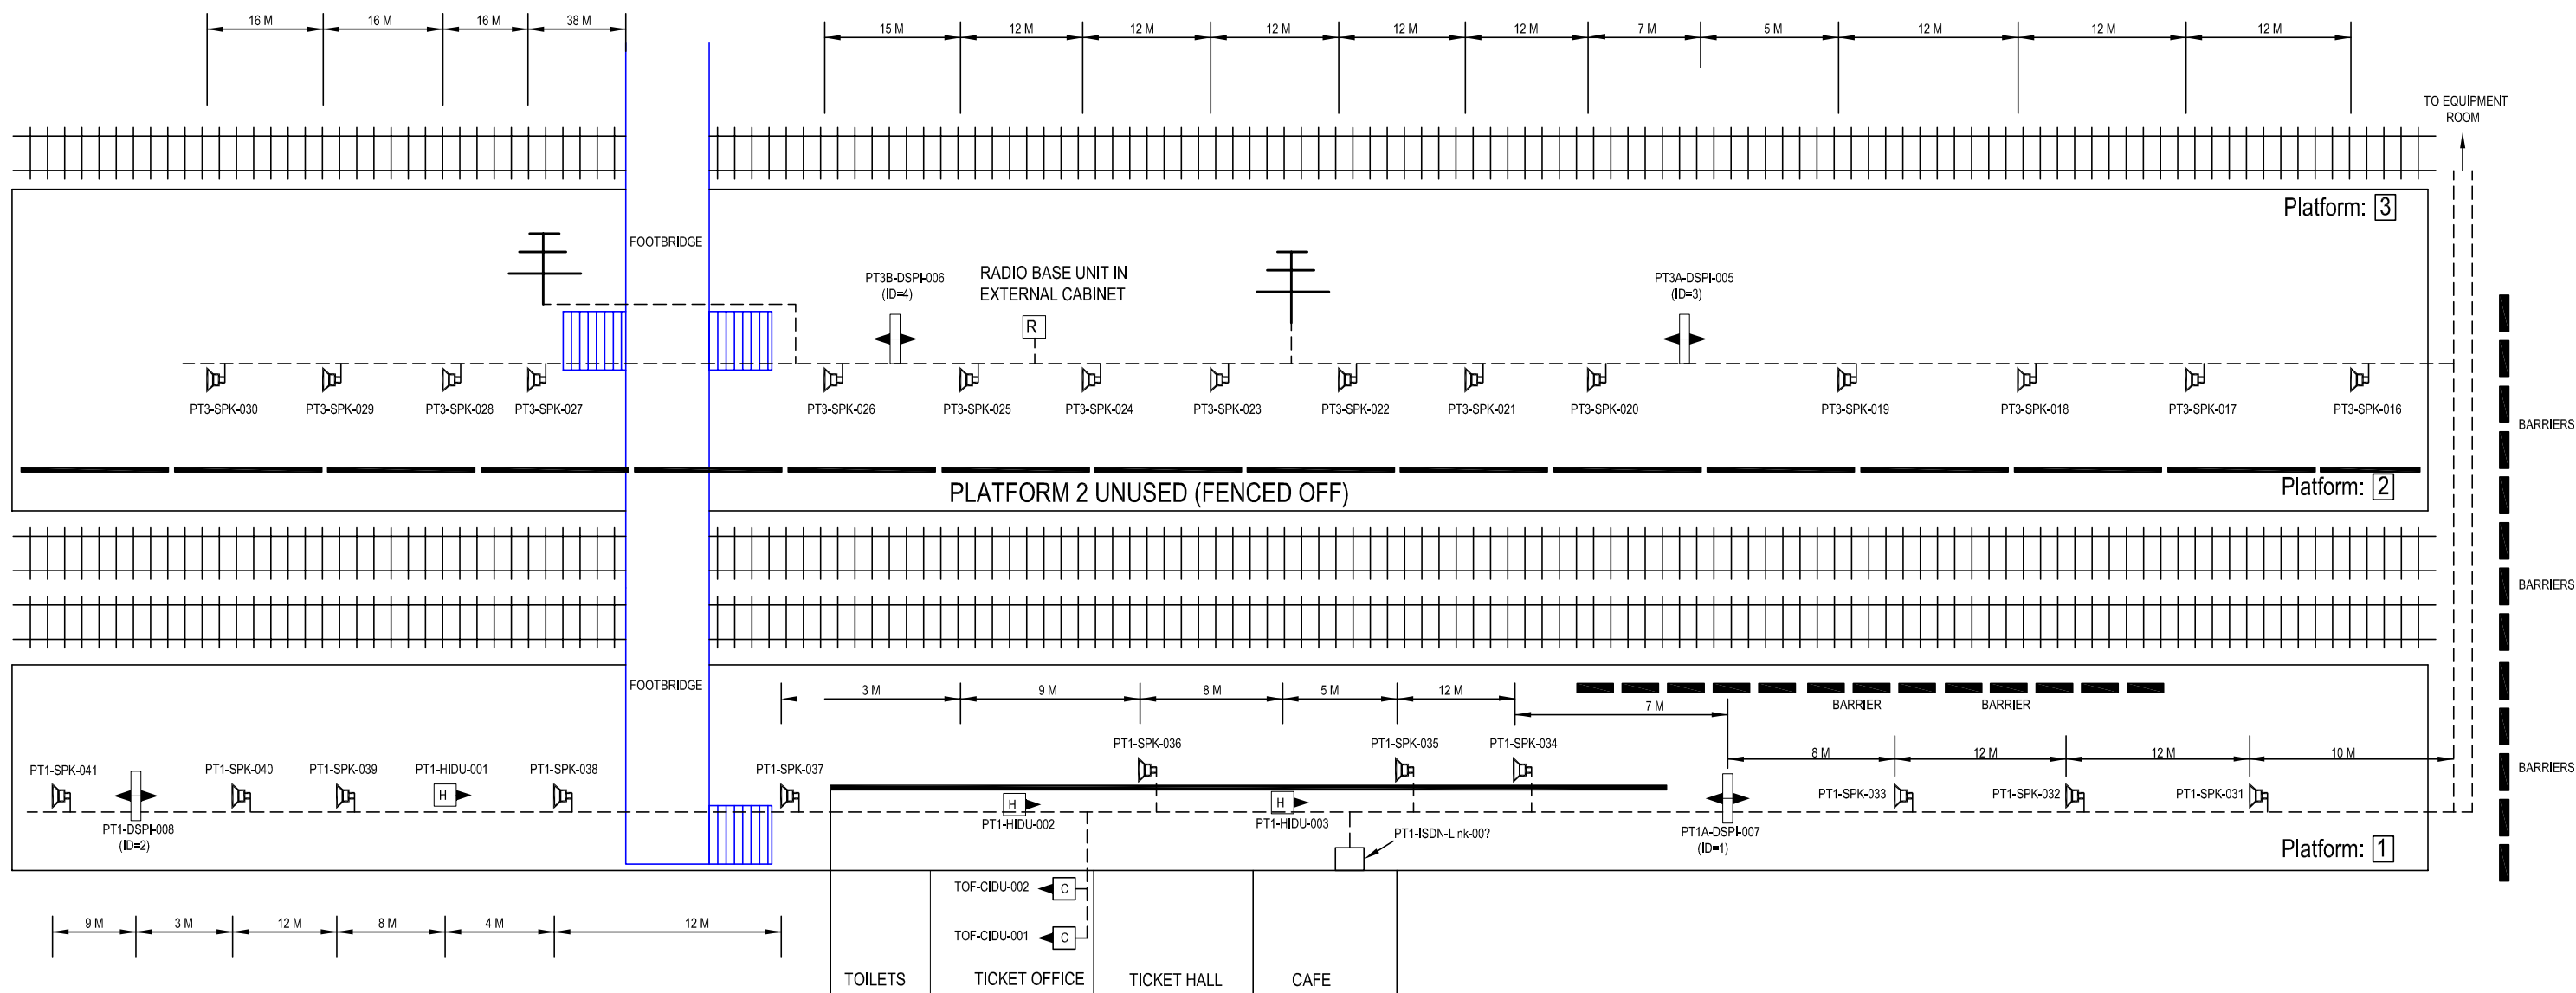

IF IN DOUBT ASK!

MATERIAL	CONSTRUCTION	DRAWN BY	D GADDU	SIGNATURE		AMEY DATEL Project Offices 1st Floor, Platform 2/3 Eastleigh Station Southampton Road Eastleigh Hants SO50 9FL	SITE/PROJECT		SOUTH WEST TRAINS CIS PROJECT	
		CHECKED BY	T WONG	DATE	05-06-2002		TITLE		PORTSMOUTH HARBOUR PLATFORMS 1 & 3 AS BUILT	
FINISH	CONSTRUCTION	APPD BY	A SMITH			COPYRIGHT © AMEY Rail All rights reserved. Neither this drawing or any of the information it contains may be copied or communicated to third parties without the written permission of the copyright holder.	SCALE	DRG No.	ISSUE	SHEET
		CAD Ref:					NTS	SM803-75540	B	1 of 2
		CONTRACTOR'S Ref:								


DRG No.

SM803-75540


WAN	
CIRCUIT ID	MXIP201586
IP ADDRESS	10.227.55.1

All Equipment tags to be prefixed with "POH-"

"PLATFORM 1 HP ISDN"	02-392-833875
"PLATFORM 3 HP ISDN"	02-392-833853
"PLATFORM 4 HP ISDN"	02-392-833858

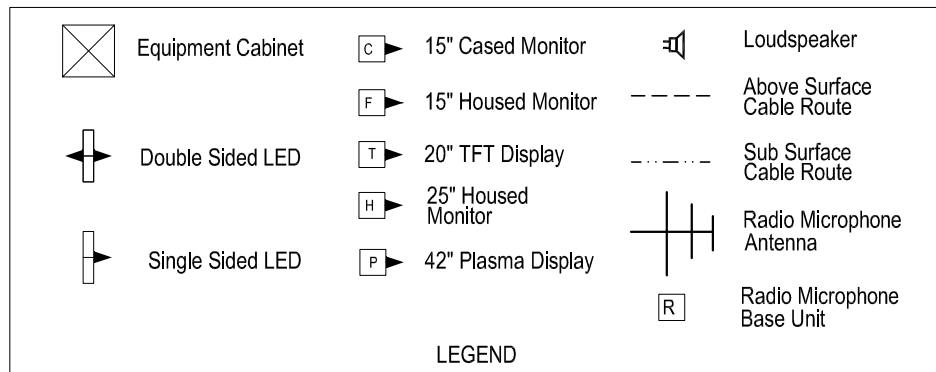

Equipment	Dist Board
CIS AD EXISTING BOARD CCT 1	
LED'S ON EXISTING SUPPLYS	

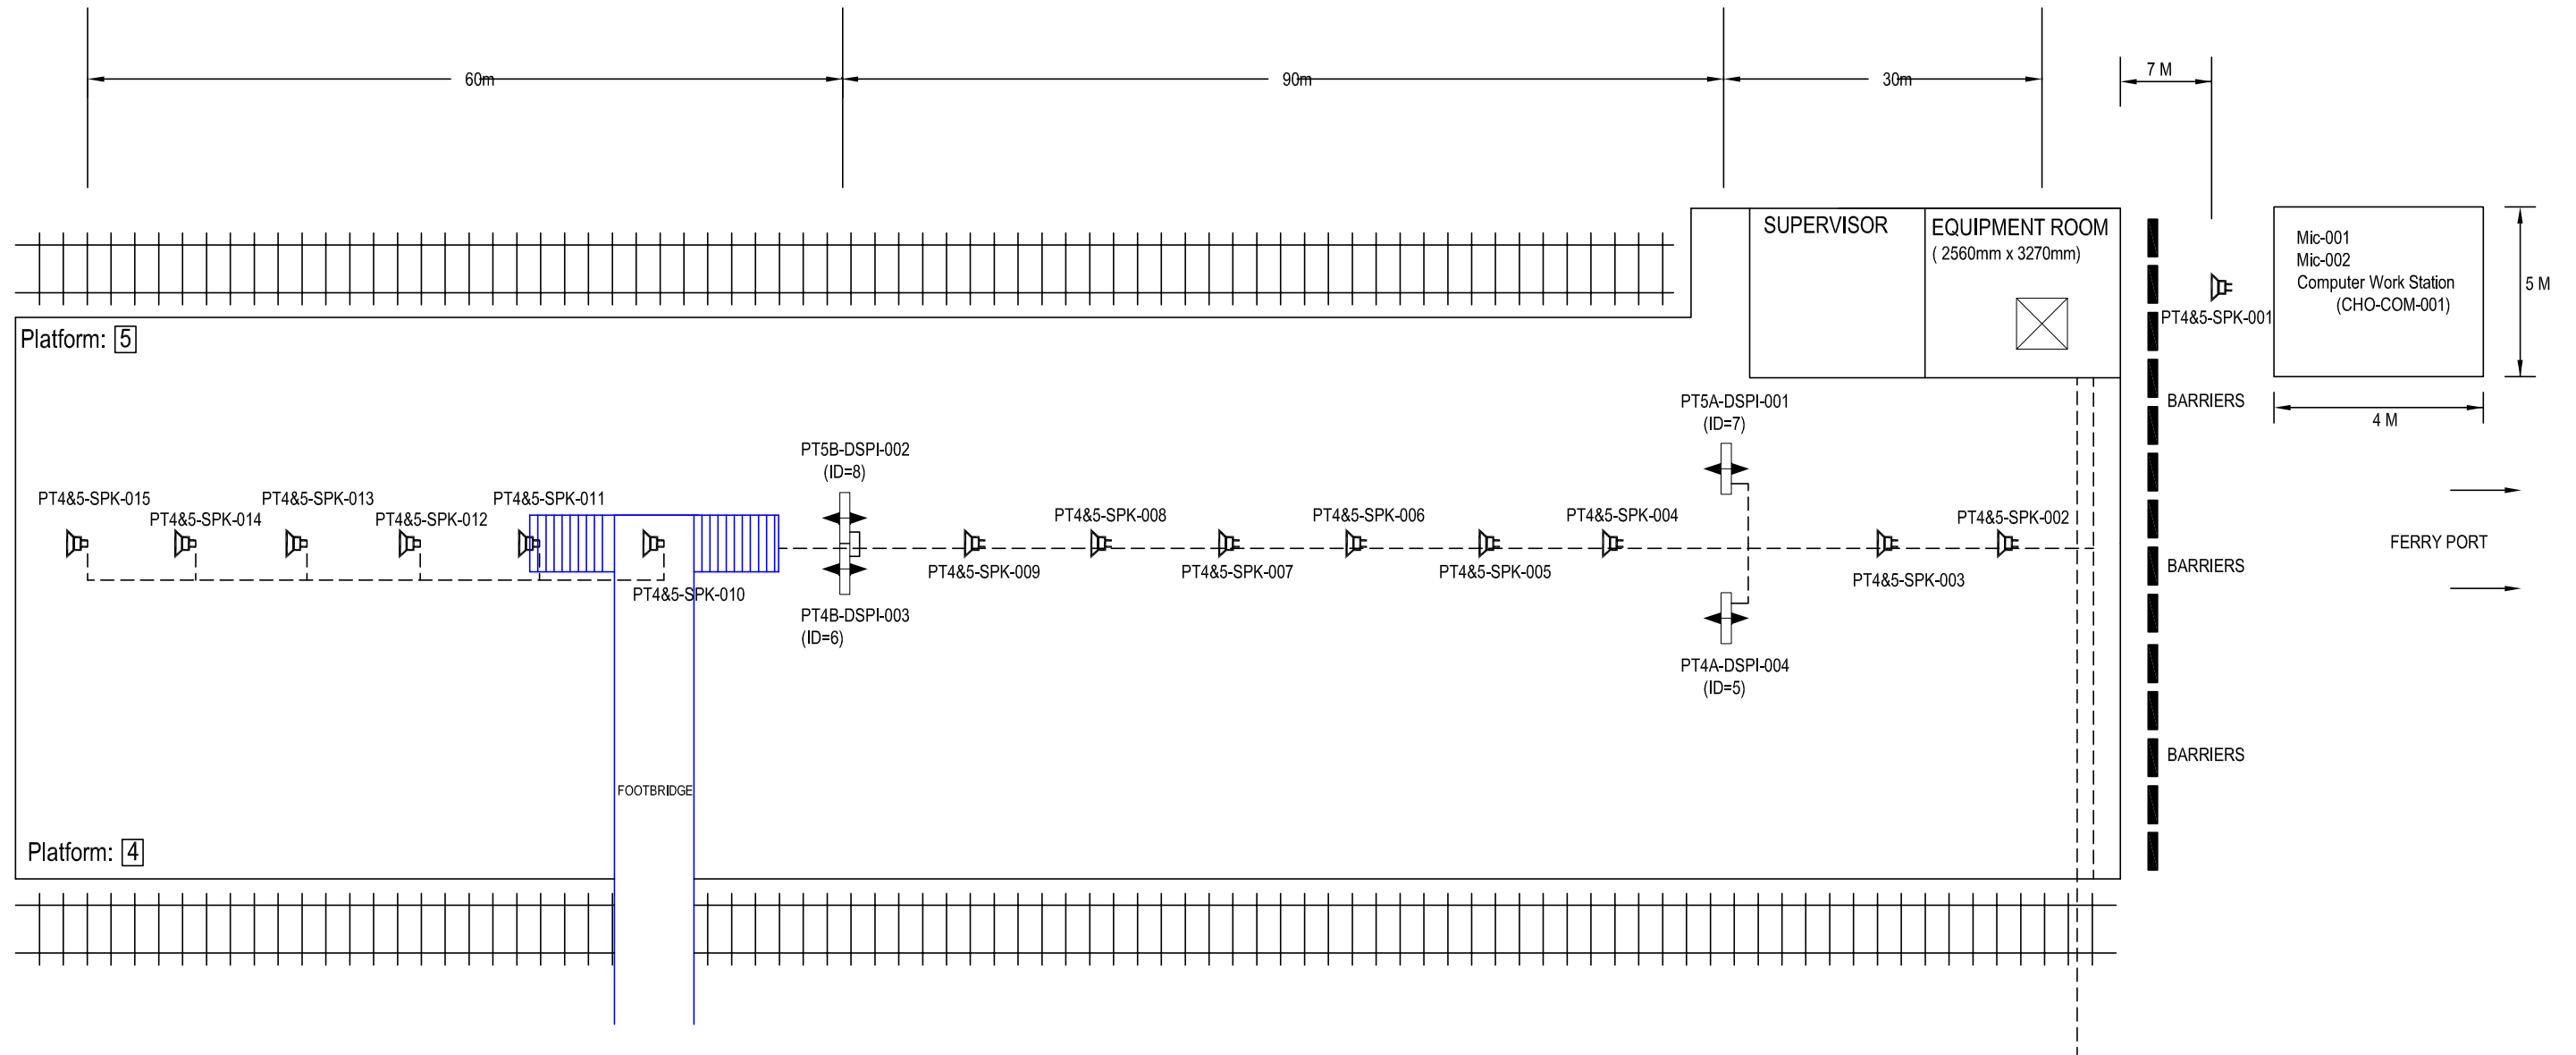

IF IN DOUBT ASK!

MATERIAL	CONSTRUCTION	NAME	SIGNATURE	DATE	AMEY DATEL Project Offices 1st Floor, Platform 2/3 Eastleigh Station Southampton Road Eastleigh Hants SO50 9FL	SITE/PROJECT			
		DRAWN BY	D GADDU	05-06-2002		SOUTH WEST TRAINS CIS PROJECT			
FINISH		CHECKED BY	T WONG		AMEY	TITLE			
		APPD BY	A SMITH			PORTSMOUTH HARBOUR PLATFORMS 4 & 5 AS BUILT			
		CAD Ref:			COPYRIGHT © AMEY Rail All rights reserved. Neither this drawing or any of the information it contains may copied or communicated to third parties without the written permission of the copyright holder	SCALE	DRG No.	ISSUE	SHEET
		CONTRACTOR'S Ref:				NTS	SM803-75540	B	2 of 2