


WAN	
CIRCUIT ID	KXIP 600376
IP ADDRESS	10.227.72.1

"PLATFORM 1 HP ISDN"
01-202-660888
"PLATFORM 2 HP ISDN"
01-202-660-968

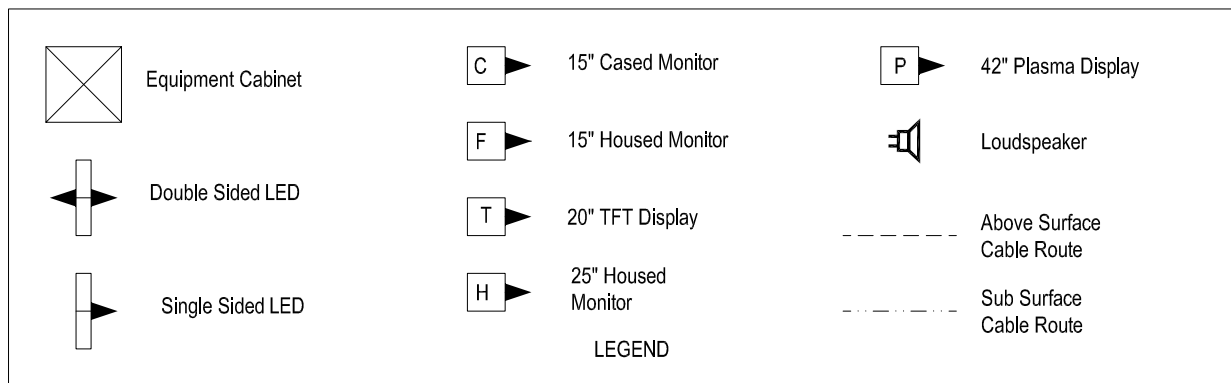

Equipment	Dist Board
CCT NO 1 CCT NO 2 CCT NO 3	CIS CAB T/OFFICE CRT T/CENTRE CRT

All Equipment tags to be prefixed with "POO-"

RADIO MICROPHONE
DEAD SPOT FROM 7TH
LIGHTING COLUMN FROM
FOOTBRIDGE

Platform: 1

PT1-SPK-001

PT1-SPK-002

PT1-SPK-003

RADIO MICROPHONE
DEAD SPOT FROM 7TH
LIGHTING COLUMN FROM
FOOTBRIDGE

Platform: 2

PT2-SPK-012

PT2-SPK-013

PT2-SPK-014


CONTINUED ON SHEET 2

IF IN DOUBT ASK!

MATERIAL	CONSTRUCTION	DRAWN BY	D GADDU	SIGNATURE	DATE	 AMEY DATEL Project Offices 1st Floor, Platform 2/3 Eastleigh Station Southampton Road Eastleigh Hants SO50 9FL	SITE/PROJECT		SOUTH WEST TRAINS CIS PROJECT	
		CHECKED BY	T WONG				TITLE		POOLE AS BUILT	
FINISH	CONSTRUCTION	APPD BY				COPYRIGHT © AMEY Rail All rights reserved. Neither this drawing or any of the information it contains may copied or communicated to third parties without the written permission of the copyright holder	SCALE	DRG No.	ISSUE	SHEET
		CAD Ref:					NTS	SM803-75883	B	1 of 3
		CONTRACTOR'S Ref:								

Equipment	Dist Board
CCT NO 1	CIS CAB
CCT NO 2	T/OFFICE CRT
CCT NO 3	T/CENTRE CRT

All Equipment tags to be prefixed with "POO-"

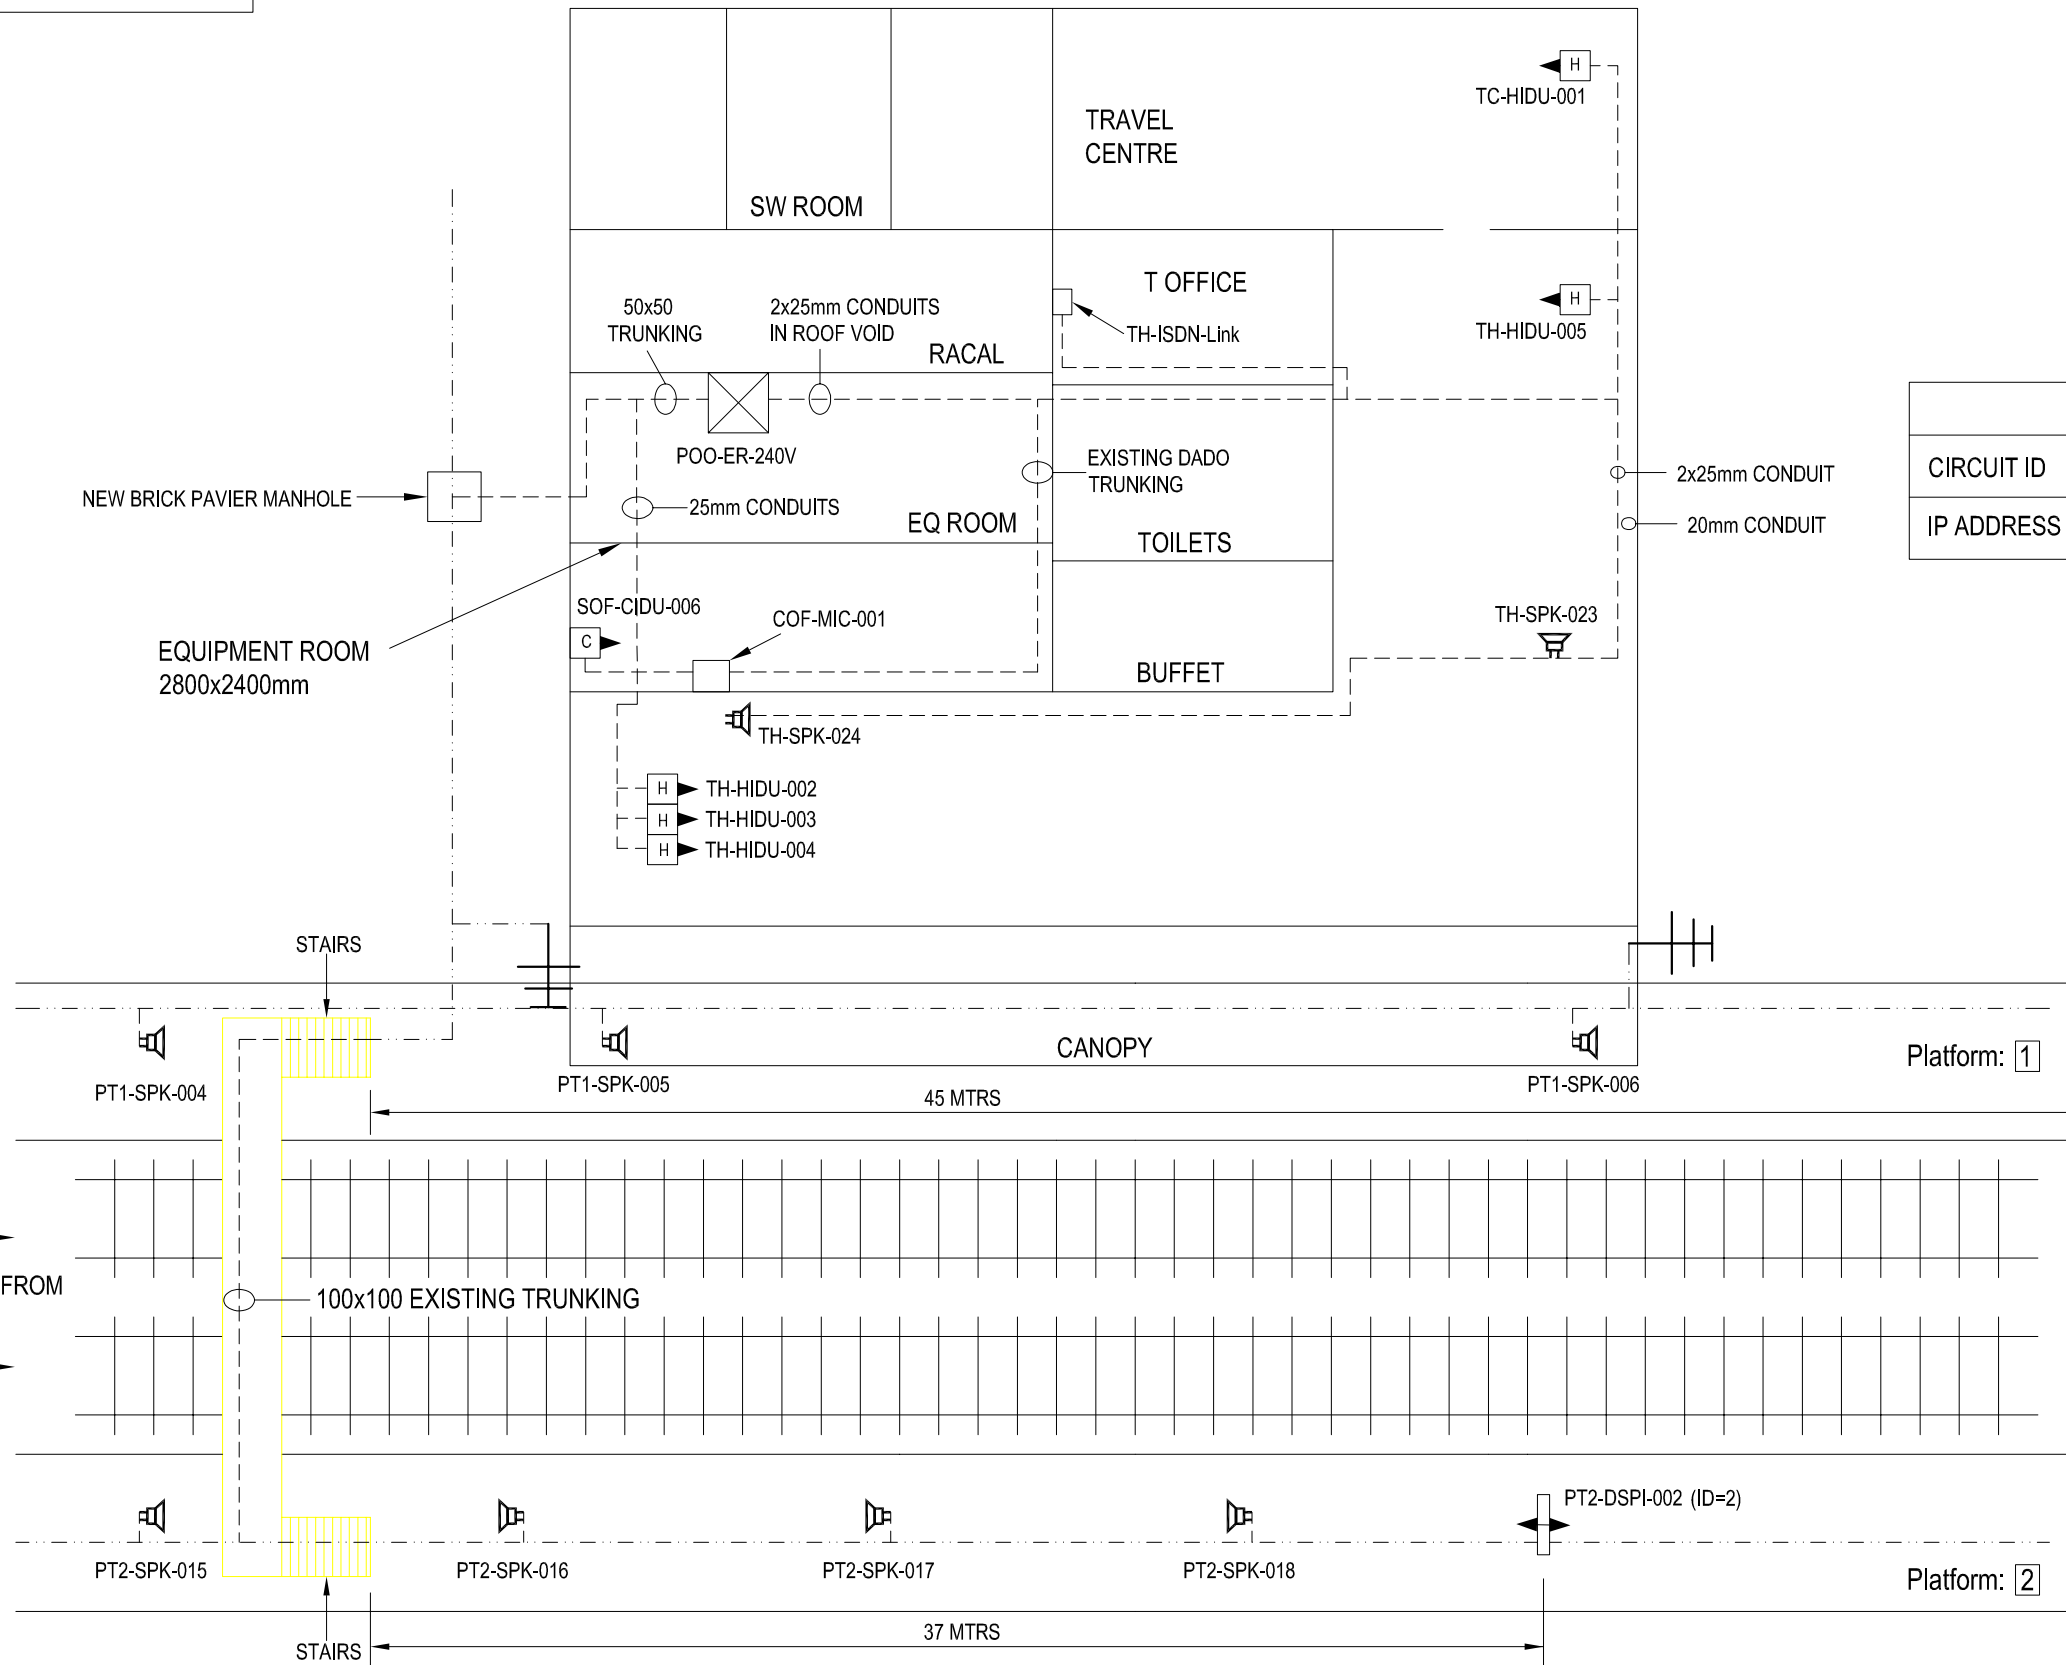

WAN	
CIRCUIT ID	KXIP 600 376
IP ADDRESS	10.227.72.1

"PLATFORM 1 HP ISDN"
01-202-660888
"PLATFORM 2 HP ISDN"
01-202-660968

LEGEND	
	Equipment Cabinet
	Double Sided LED
	Single Sided LED
	15" Cased Monitor
	15" Housed Monitor
	20" TFT Display
	25" Housed Monitor
	42" Plasma Display
	Loudspeaker
	Above Surface Cable Route
	Sub Surface Cable Route
	Radio Microphone Antenna
	Radio Microphone Base Unit

CONTINUED FROM SHEET 1

CONTINUED TO SHEET 3


CONTINUED ON SHEET 3

IF IN DOUBT ASK!

MATERIAL	CONSTRUCTION	<table border="1"> <thead> <tr> <th>NAME</th> <th>SIGNATURE</th> <th>DATE</th> </tr> </thead> <tbody> <tr> <td>D GADDU</td> <td></td> <td>30-01-2002</td> </tr> <tr> <td></td> <td></td> <td></td> </tr> <tr> <td></td> <td></td> <td></td> </tr> <tr> <td></td> <td></td> <td></td> </tr> </tbody> </table>	NAME	SIGNATURE	DATE	D GADDU		30-01-2002										<p>AMEY DATEL Project Offices 1st Floor, Platform 2/3 Eastleigh Station Southampton Road Eastleigh Hants SO50 9FL</p>	SITE/PROJECT		SOUTH WEST TRAINS CIS PROJECT	
		NAME	SIGNATURE	DATE																		
D GADDU		30-01-2002																				
FINISH				TITLE		POOLE AS BUILT																
		CAD Ref:		SCALE		NTS																
		CONTRACTOR'S Ref:		DRG No.		SM803-75883																
				ISSUE		B																
				SHEET		2 of 3																
				<p>COPYRIGHT © AMEY Rail All rights reserved. Neither this drawing or any of the information it contains may be copied or communicated to third parties without the written permission of the copyright holder</p>																		

WAN	
CIRCUIT ID	KXIP 600 376
IP ADDRESS	10.227.72.1


"PLATFORM 1 HP ISDN"
01-202-660888
"PLATFORM 2 HP ISDN"
01-202-660968

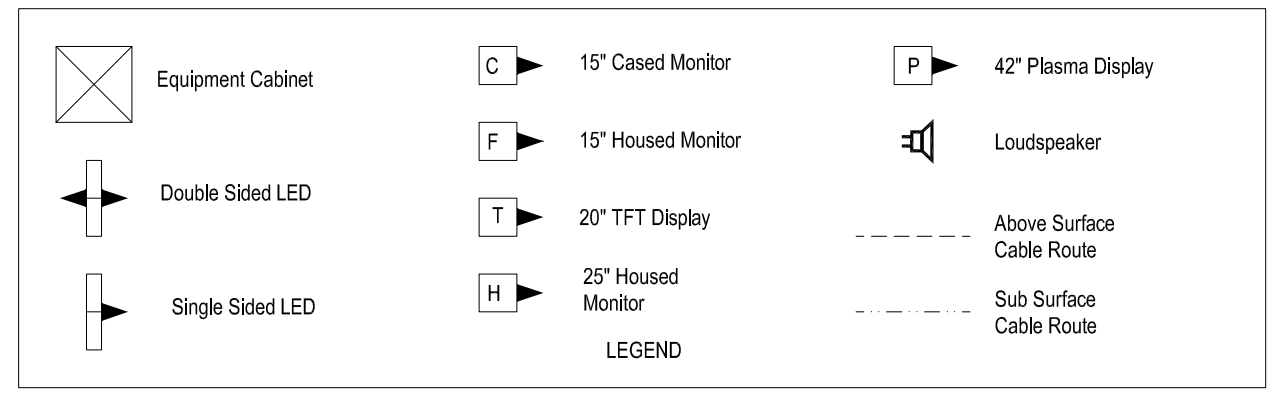

Equipment	Dist Board
CCT NO 1	CIS CAB
CCT NO 2	T/OFFICE CRT
CCT NO 3	T/CENTRE CRT

All Equipment tags to be prefixed with "POO-"

CONTINUED FROM SHEET 2

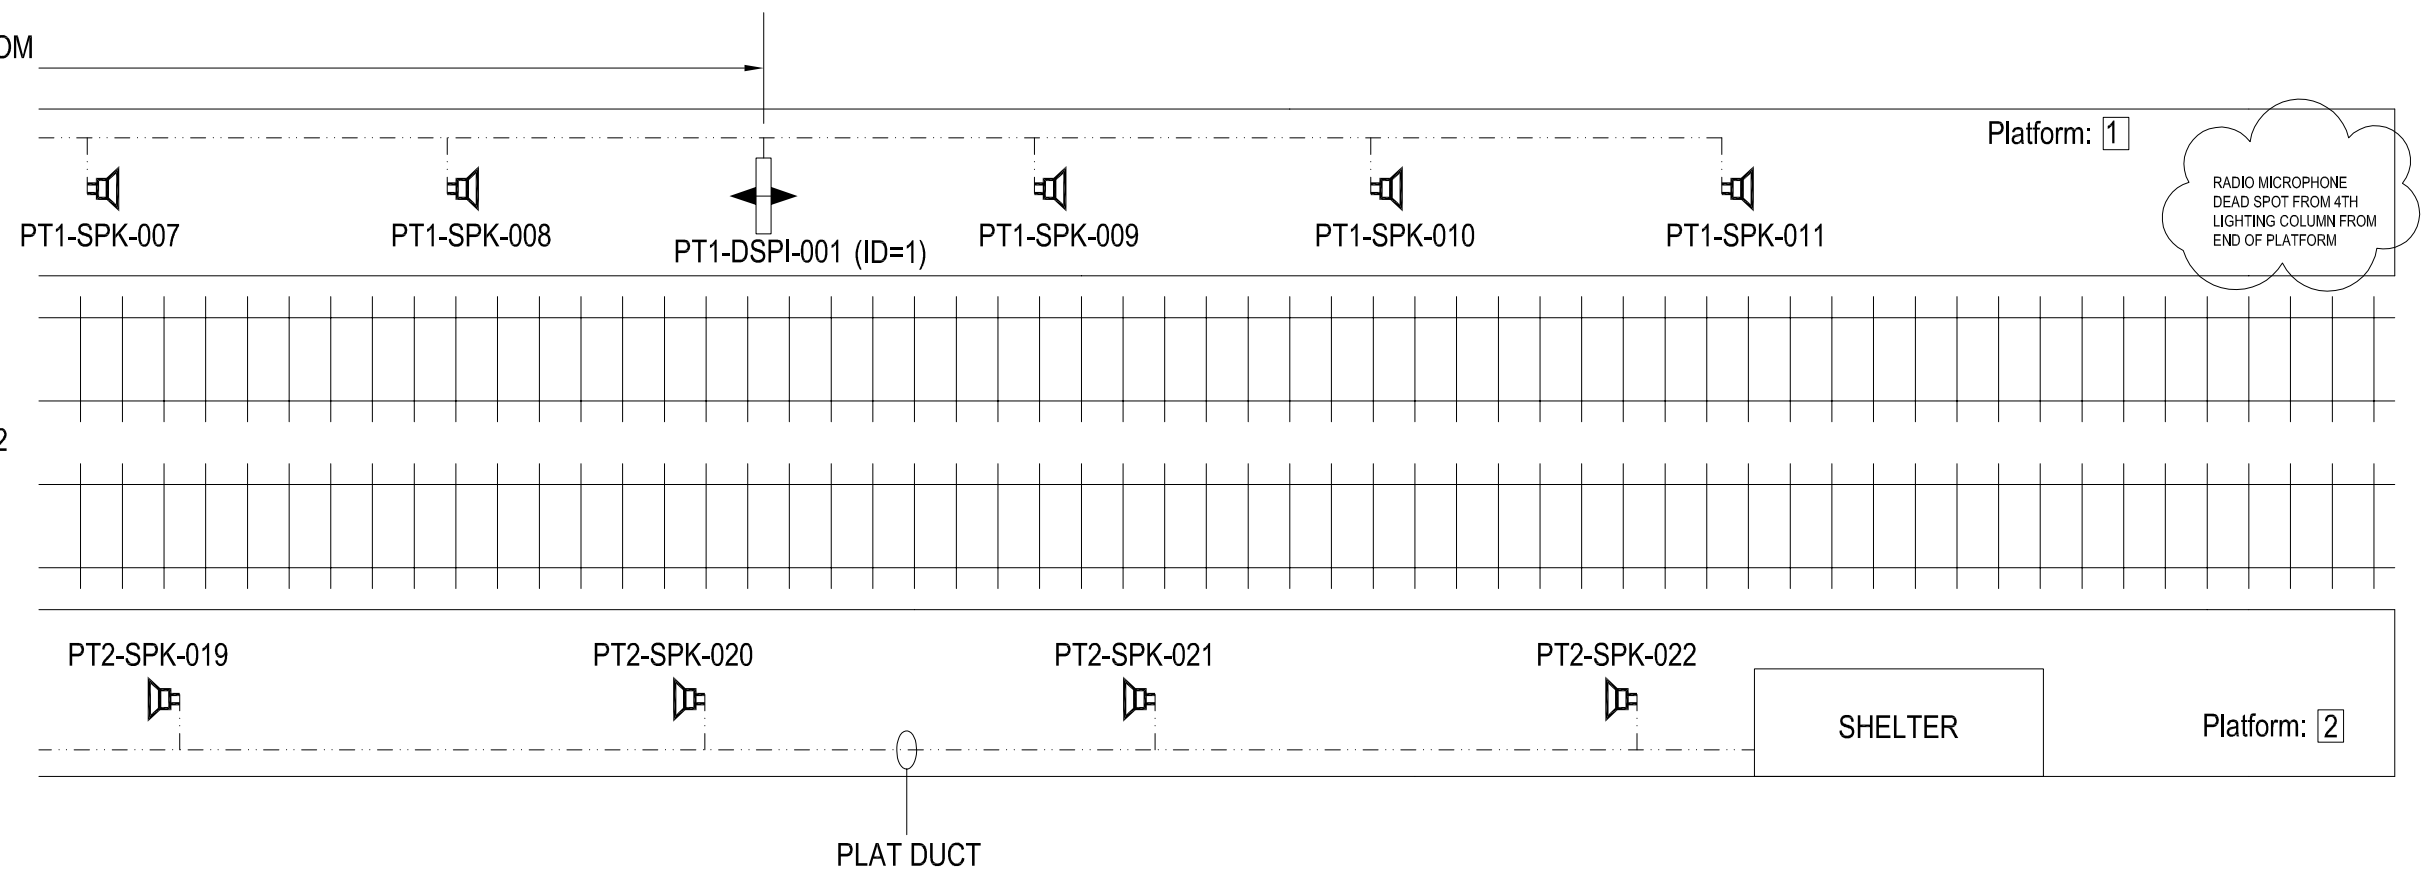

RADIO MICROPHONE
DEAD SPOT FROM 4TH
LIGHTING COLUMN FROM
END OF PLATFORM

CONTINUED FROM SHEET 2

IF IN DOUBT ASK!

MATERIAL	CONSTRUCTION	DRAWN BY	D GADDU	SIGNATURE	DATE	<p>AMEY DATEL Project Offices 1st Floor, Platform 2/3 Eastleigh Station Southampton Road Eastleigh Hants SO50 9FL</p>	SITE/PROJECT		SOUTH WEST TRAINS CIS PROJECT	
		CHECKED BY	T WONG				TITLE	POOLE AS BUILT		
FINISH		APPD BY				<p>COPYRIGHT © AMEY Rail All rights reserved. Neither this drawing or any of the information it contains may be copied or communicated to third parties without the written permission of the copyright holder</p>	SCALE	DRG No.	ISSUE	SHEET
		APPD BY					NTS	SM803-75883	B	3 of 3
		CAD Ref:								
		CONTRACTOR'S Ref:								