


DRG No.

SM803-75928


WAN	
CIRCUIT ID	KXIP 600377
IP ADDRESS	10.227.192.1

"PLATFORM 1 HP ISDN"
02392-370456
"PLATFORM 2 HP ISDN"
02392-370474

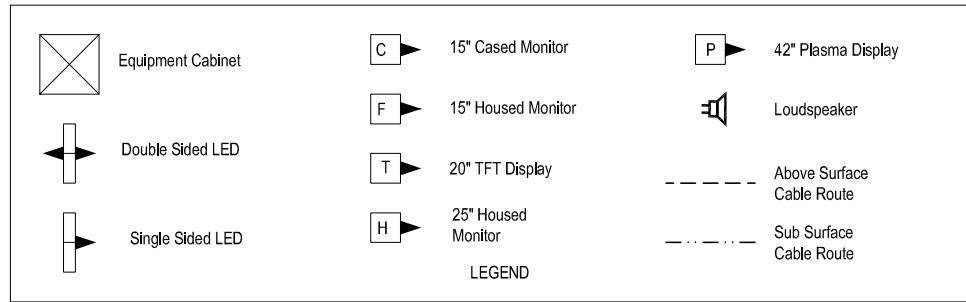

Equipment	Dist Board
CIS RACK	CCT 1
LED'S	CCT 2

All Equipment tags to be prefixed with "PTC-"

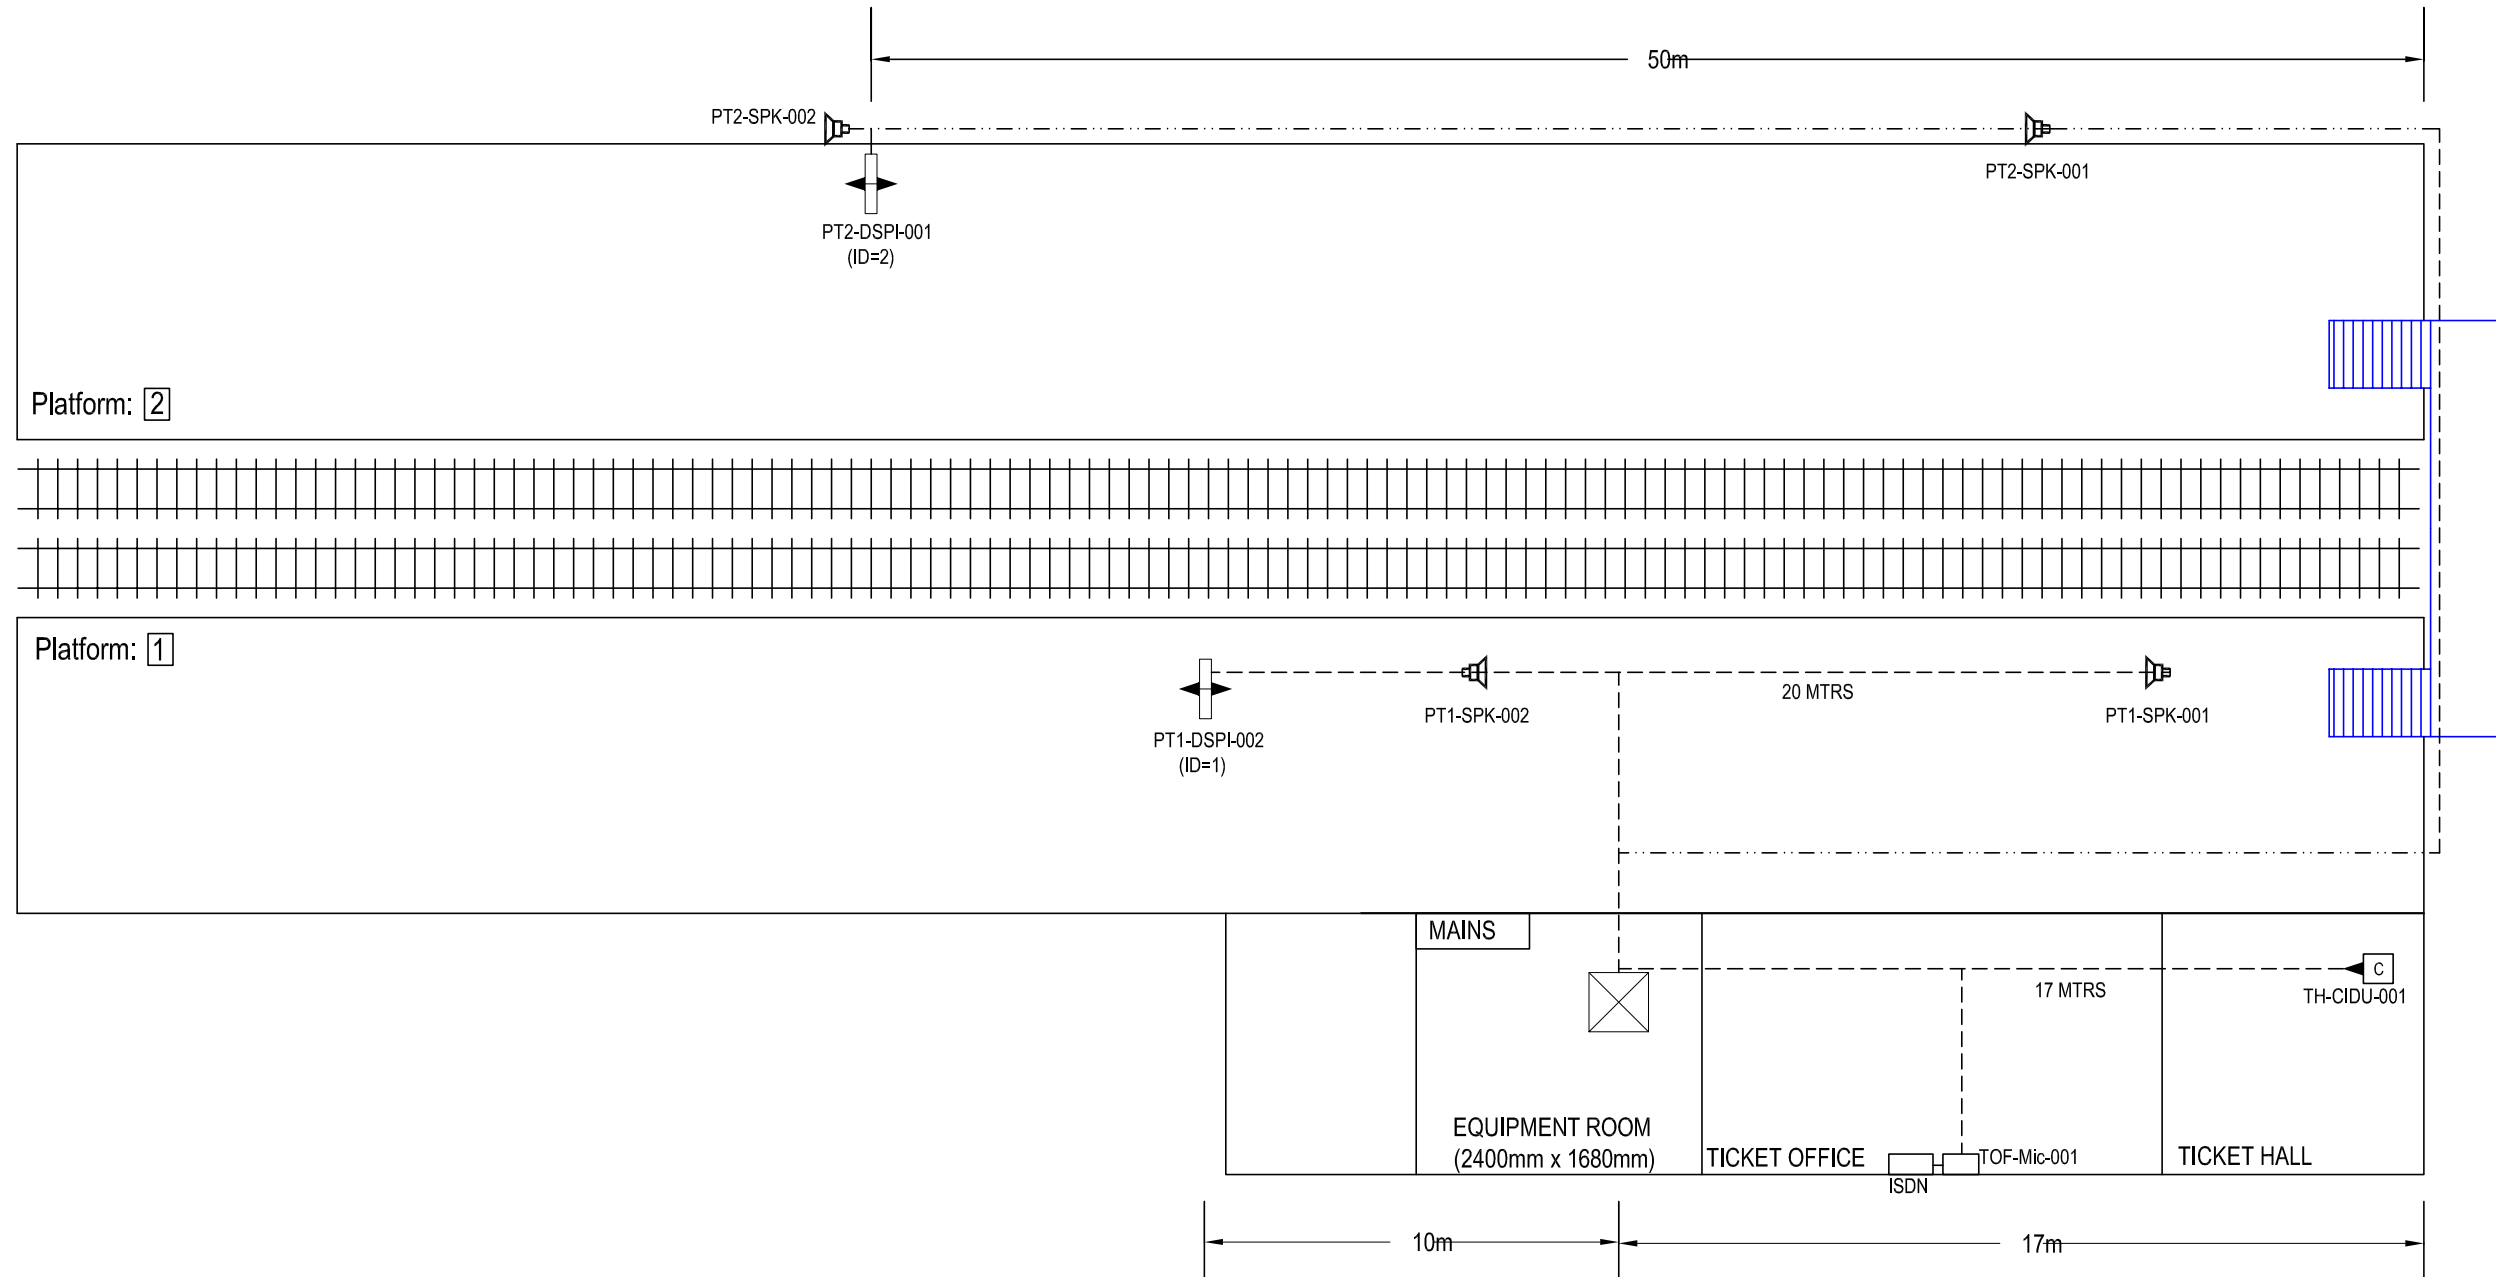

MATERIAL	CONSTRUCTION	NAME	SIGNATURE	DATE
		D GADDU		20-05-2002
		T WONG		
		A SMITH		
FINISH				
		CAD Ref:		
		CONTRACTOR'S Ref:		



AMEY DATEL Project  
 Offices  
 1st Floor, Platform  
 2/3  
 Eastleigh Station  
 Southampton Road  
 Eastleigh  
 Hants  
 SO50 9FL

COPYRIGHT © AMEY Rail  
 All rights reserved. Neither this drawing or any of the information  
 it contains may be copied or communicated to third parties  
 without the written permission of the copyright holder

SITE/PROJECT		SOUTH WEST TRAINS CIS PROJECT	
TITLE		PORTCHESTER AS BUILT	
SCALE	DRG No.	ISSUE	SHEET
NTS	SM803-75928	B	1 of 1