



WAN		"PLATFORM 1 HP ISDN"
CIRCUIT ID	KXIP600373	01-730-260448
IP ADDRESS	10.227.102.1	"PLATFORM 2 HP ISDN"
		07-730-260470

All Equipment tags to be prefixed with "PTR-"

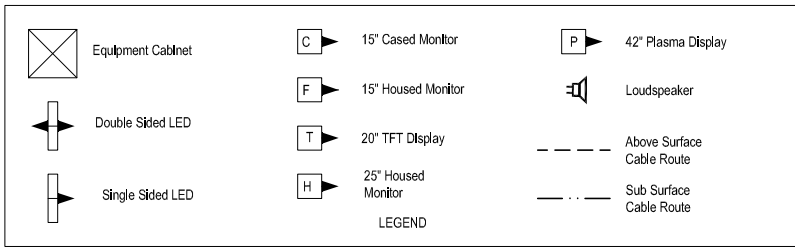


Equipment	Dist Board	
CIS RACK	6WAY POLESTAR CCT4	C16A
PT1-DSPI-001	6WAY CRABTREE CCT2	15A
PT1-DSPI-002	6WAY POLESTAR CCT6	15A
PT2-DSPI-003	GP2 IN T.O. CCT11	16A
TH-FIDU-001	GP2 IN T.O. CCT 10	10A
CHO-CIDU-001	EXISTING SPUR	

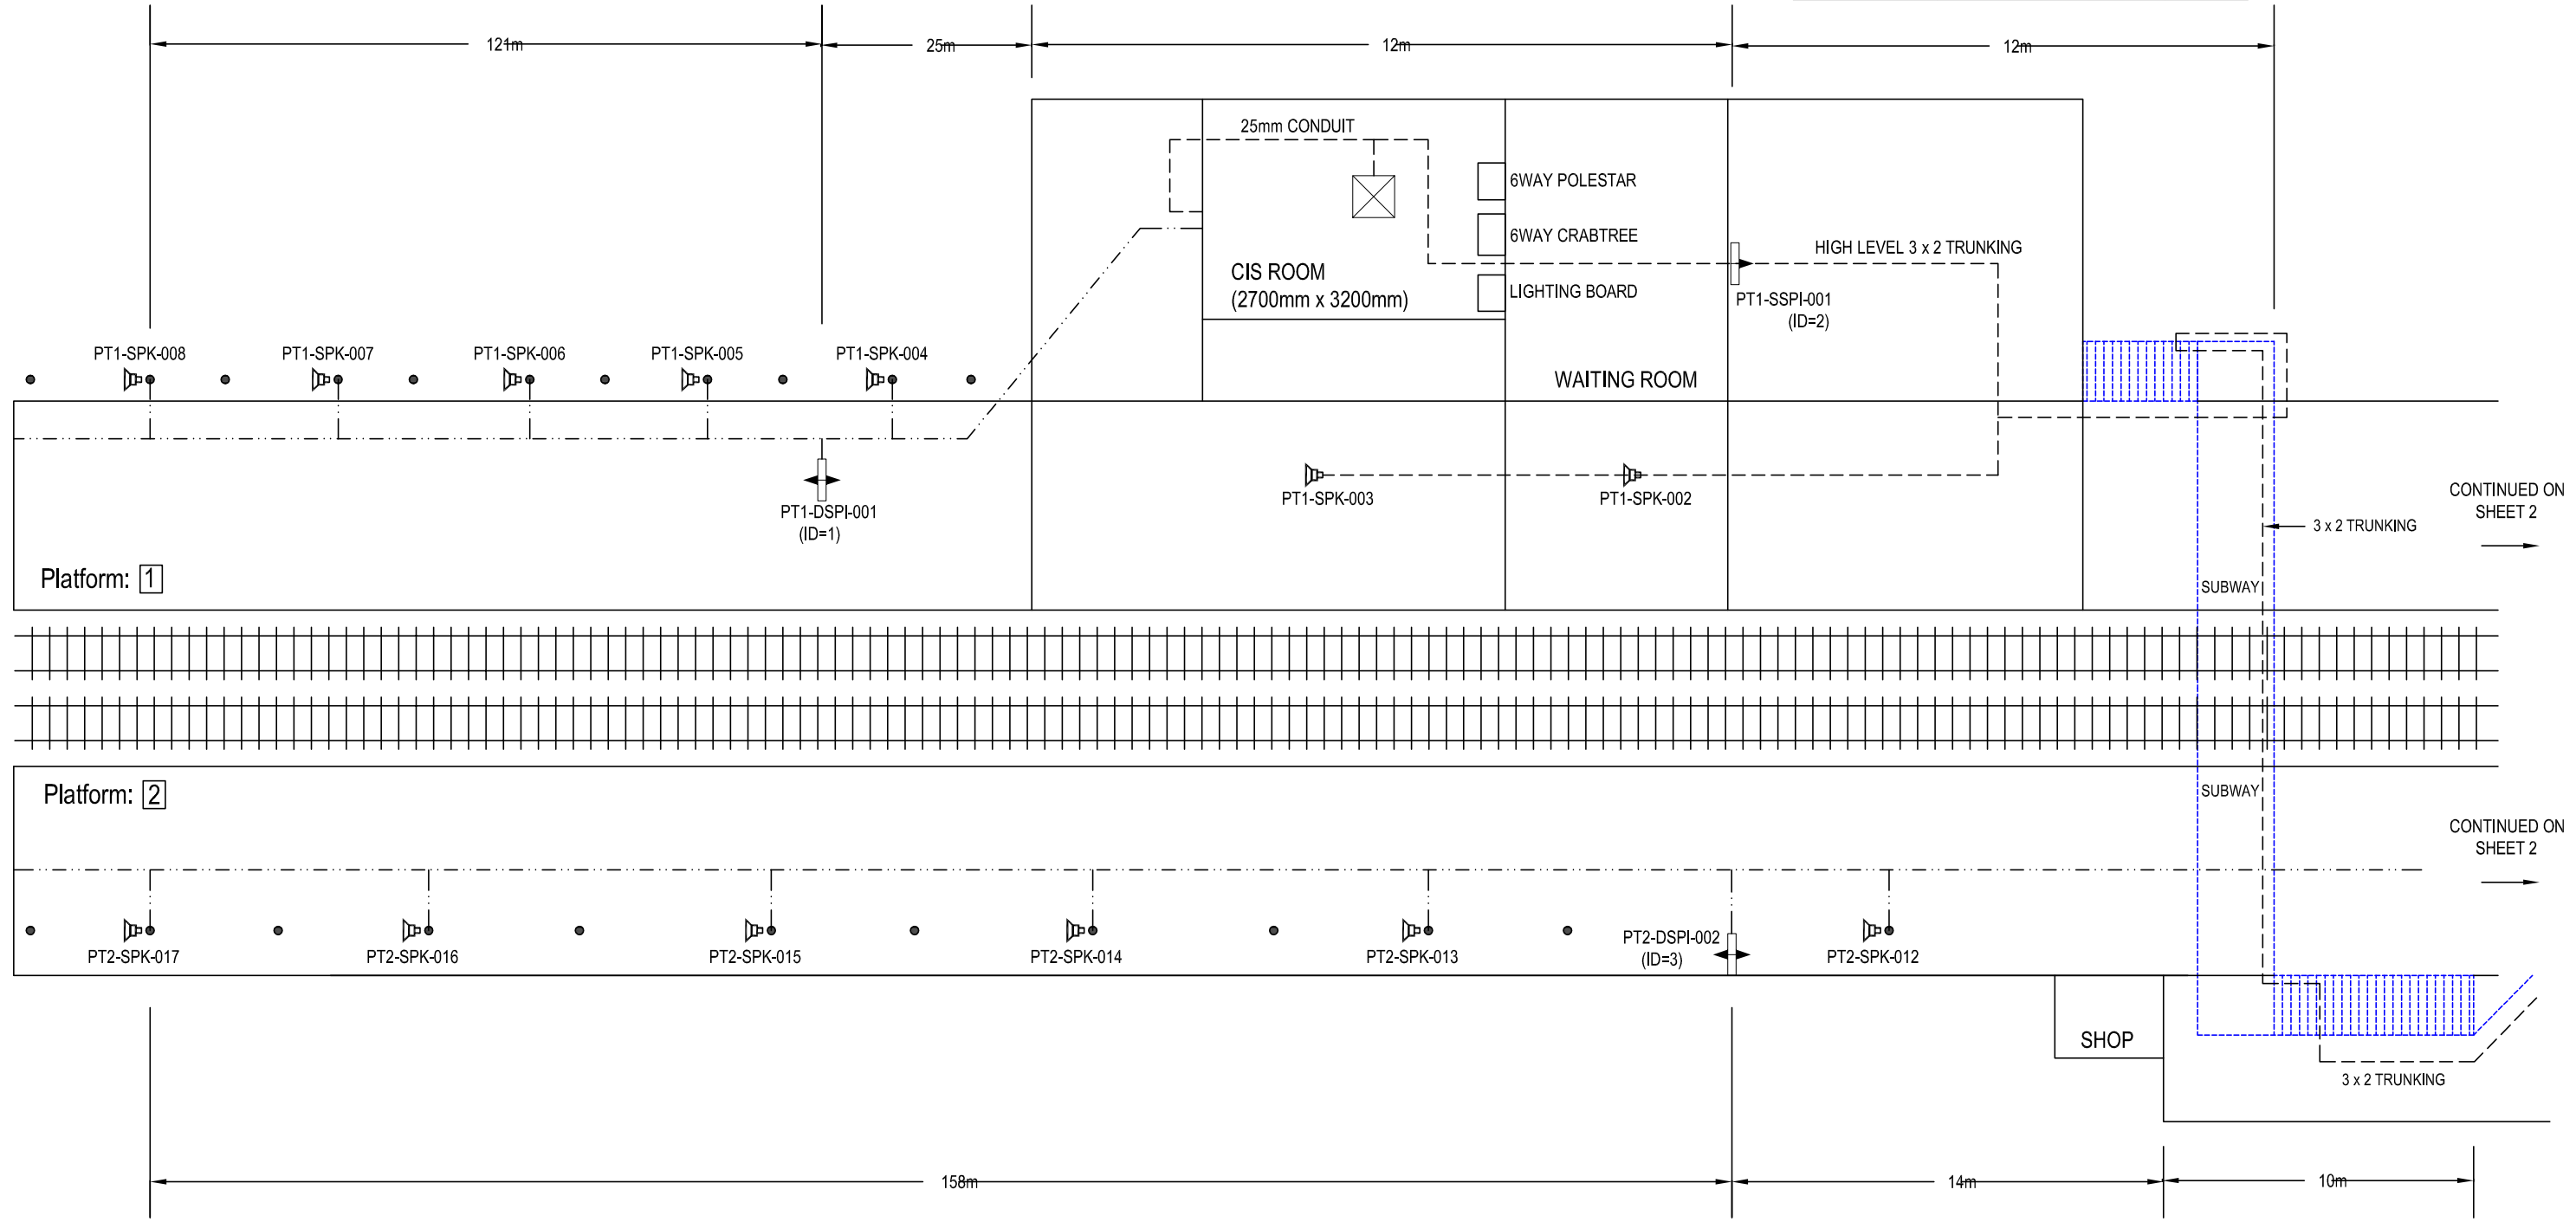

MATERIAL	CONSTRUCTION	NAME	SIGNATURE	DATE
		D GADDU		21-05-2002
		T WONG		
		A SMITH		
FINISH				
		CAD Ref:		
		CONTRACTOR'S Ref:		

IF IN DOUBT ASK!



AMEY DATEL Project
 Offices
 1st Floor, Platform
 2/3
 Eastleigh Station
 Southampton Road
 Eastleigh
 Hants
 SO50 9FL

COPYRIGHT © AMEY Rail
 All rights reserved. Neither this drawing or any of the information it contains may be copied or communicated to third parties without the written permission of the copyright holder


SITE/PROJECT		SOUTH WEST TRAINS CIS PROJECT	
TITLE		PETERSFIELD AS BUILT	
SCALE	DRG No.	ISSUE	SHEET
NTS	SM803-75657	B	1 of 2

DRG No. SM803-75657


WAN	
CIRCUIT ID	KXIP600373
IP ADDRESS	10.227.102.1

"PLATFORM 1 HP ISDN"	01-730-260448
"PLATFORM 2 HP ISDN"	07-730-260470

All Equipment tags to be prefixed with "PTR-"

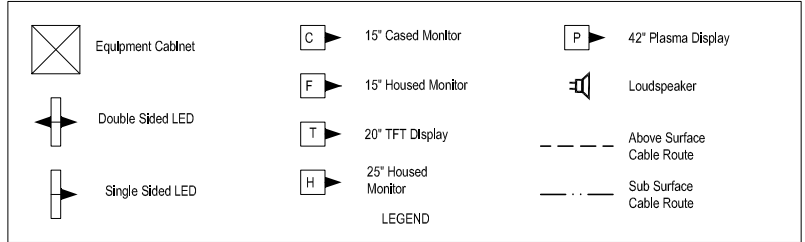

Equipment	Dist Board	
CIS RACK	6WAY POLESTAR CCT4	C16A
PT1-DSPI-001	6WAY CRABTREE CCT2	15A
PT1-DSPI-002	6WAY POLESTAR CCT6	15A
PT2-DSPI-003	GP2 IN T.O. CCT11	16A
TH-FIDU-001	GP2 IN T.O. CCT 10	10A
CHO-CIDU-001	EXISTING SPUR	

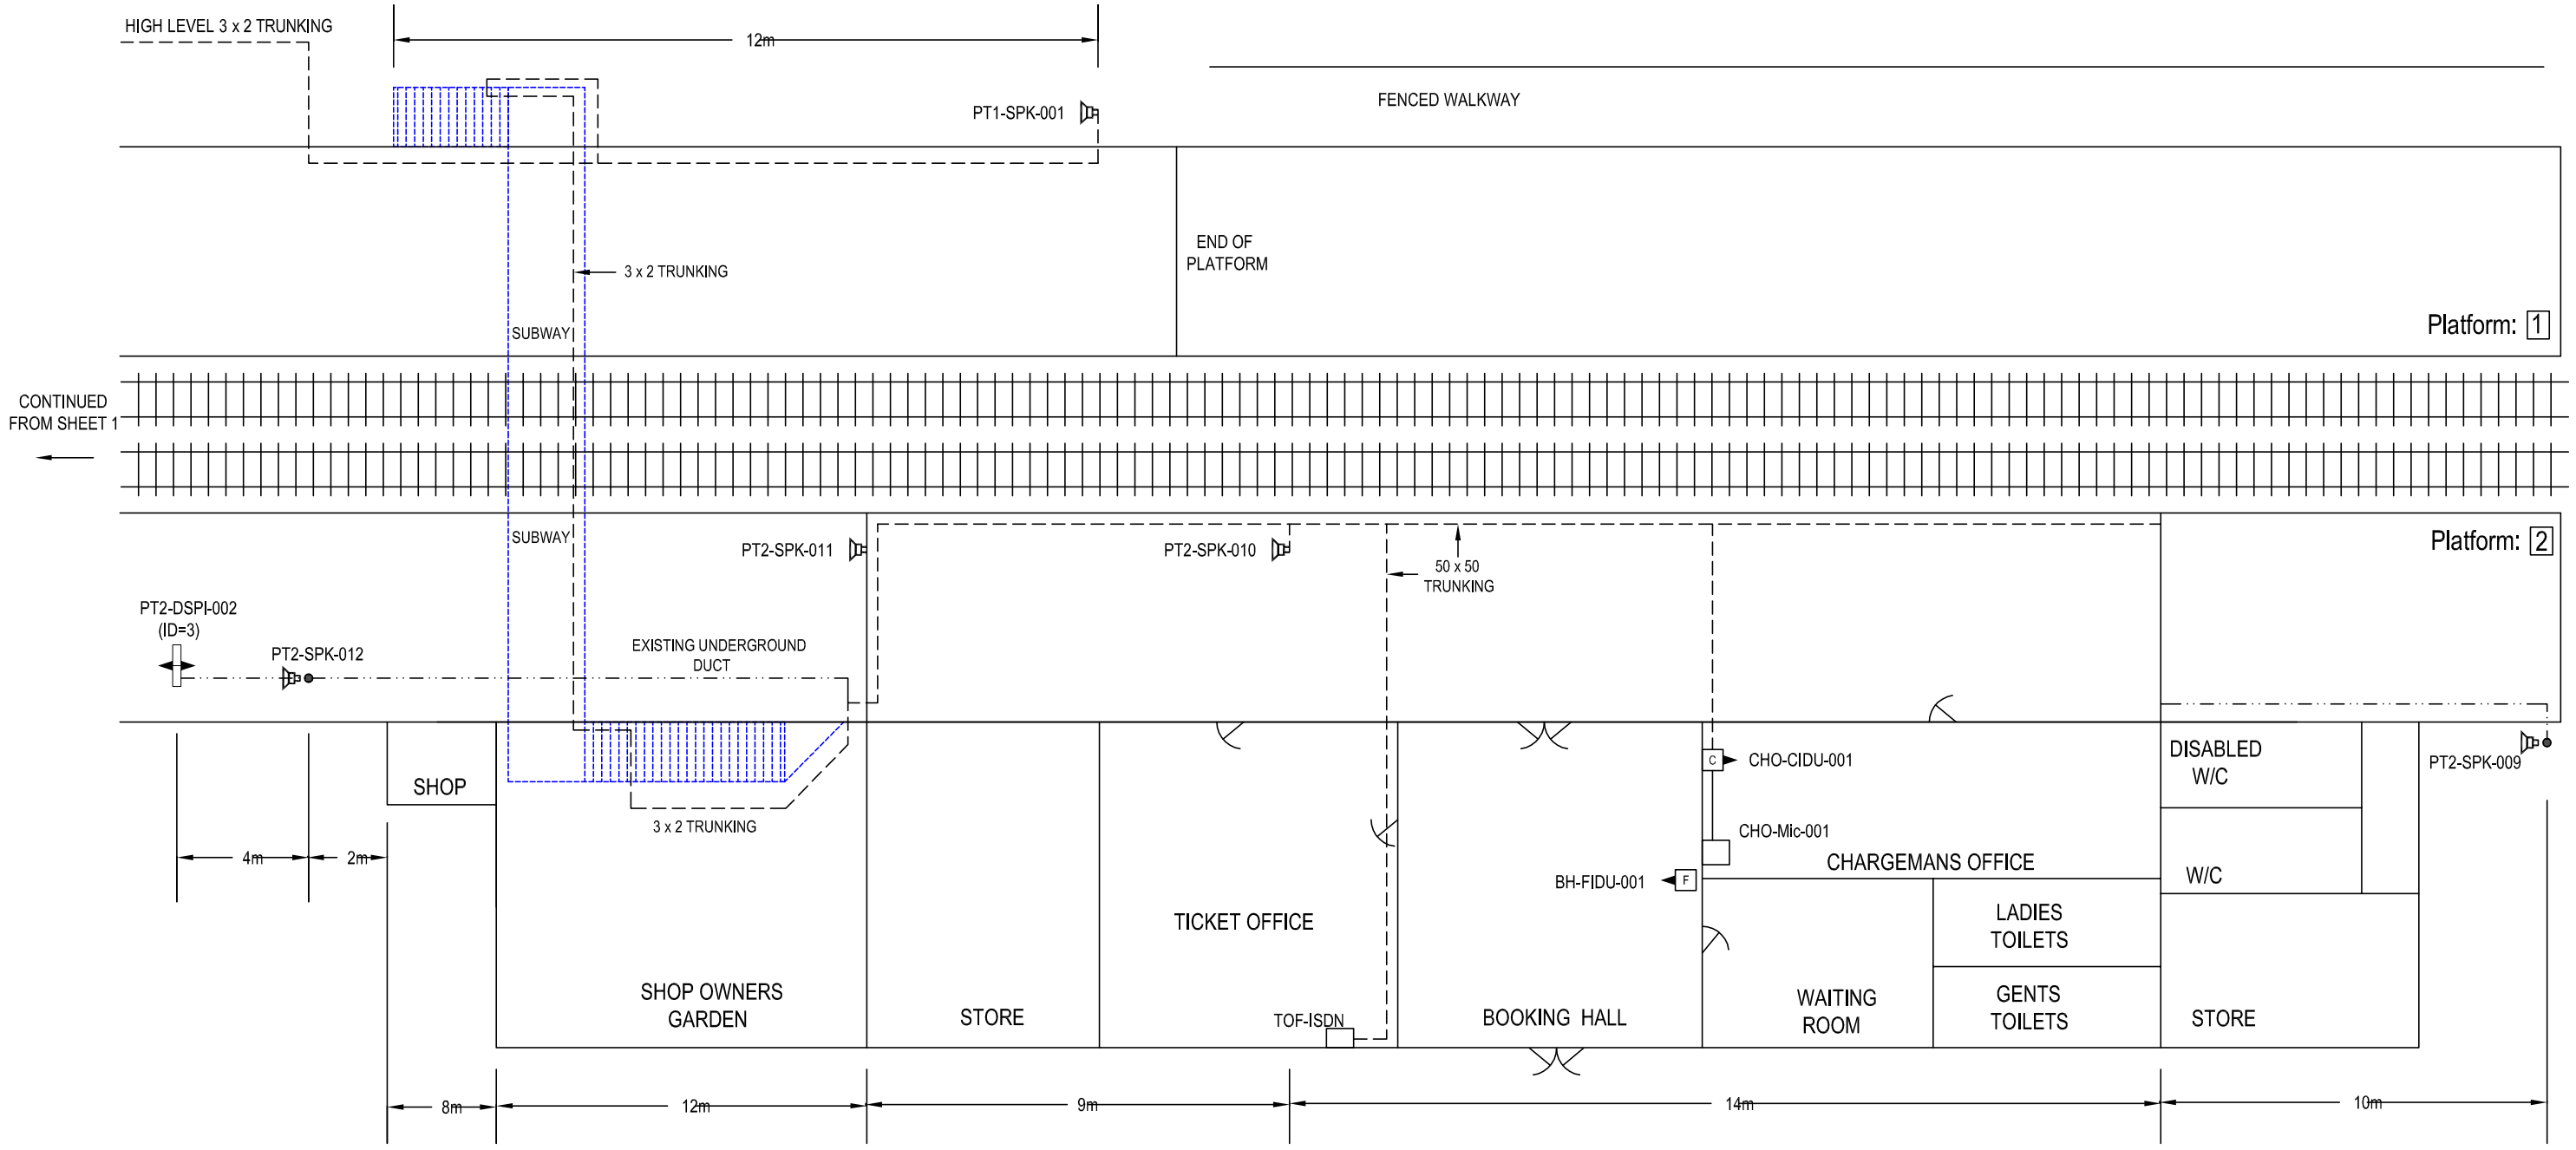

IF IN DOUBT ASK!

MATERIAL	CONSTRUCTION	<table border="1"> <tr> <th>NAME</th> <th>SIGNATURE</th> <th>DATE</th> </tr> <tr> <td>D GADDU</td> <td></td> <td>21-05-2002</td> </tr> <tr> <td>T WONG</td> <td></td> <td></td> </tr> <tr> <td>A SMITH</td> <td></td> <td></td> </tr> </table>	NAME	SIGNATURE	DATE	D GADDU		21-05-2002	T WONG			A SMITH			<p>AMEY DATEL Project Offices 1st Floor, Platform 2/3 Eastleigh Station Southampton Road Eastleigh Hants SO50 9FL</p>	SITE/PROJECT SOUTH WEST TRAINS CIS PROJECT	
		NAME	SIGNATURE	DATE													
D GADDU		21-05-2002															
T WONG																	
A SMITH																	
<table border="1"> <tr> <td>DRAWN BY</td> <td>CHECKED BY</td> <td>APPD BY</td> </tr> <tr> <td></td> <td></td> <td></td> </tr> </table>	DRAWN BY	CHECKED BY	APPD BY				TITLE PETERSFIELD AS BUILT										
DRAWN BY	CHECKED BY	APPD BY															
FINISH		CAD Ref:	<p>COPYRIGHT © AMEY Rail All rights reserved. Neither this drawing or any of the information it contains may be copied or communicated to third parties without the written permission of the copyright holder</p>	SCALE NTS	DRG No. SM803-75657	ISSUE B	SHEET 2 of 2										
		CONTRACTOR'S Ref:															