


SM803-75603


WAN	
CIRCUIT ID	KXIP600379
IP ADDRESS	10.227.9.1

"PLATFORM 1 HP ISDN"
020-8788-0353
"PLATFORM 2/3 HP ISDN"
020-8788-0367
"PLATFORM 4 HP ISDN"
020-8788-0678

All Equipment tags to be prefixed with "PUT-"

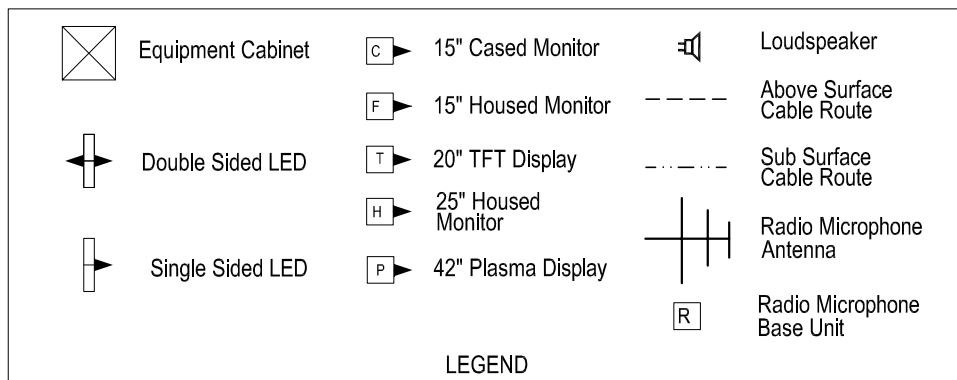

Equipment	Dist Board	
PT1-DSPI-002	DB1A 10A	
EXISTING SUPPLIES USED FOR OTHERS EQUIPMENT		

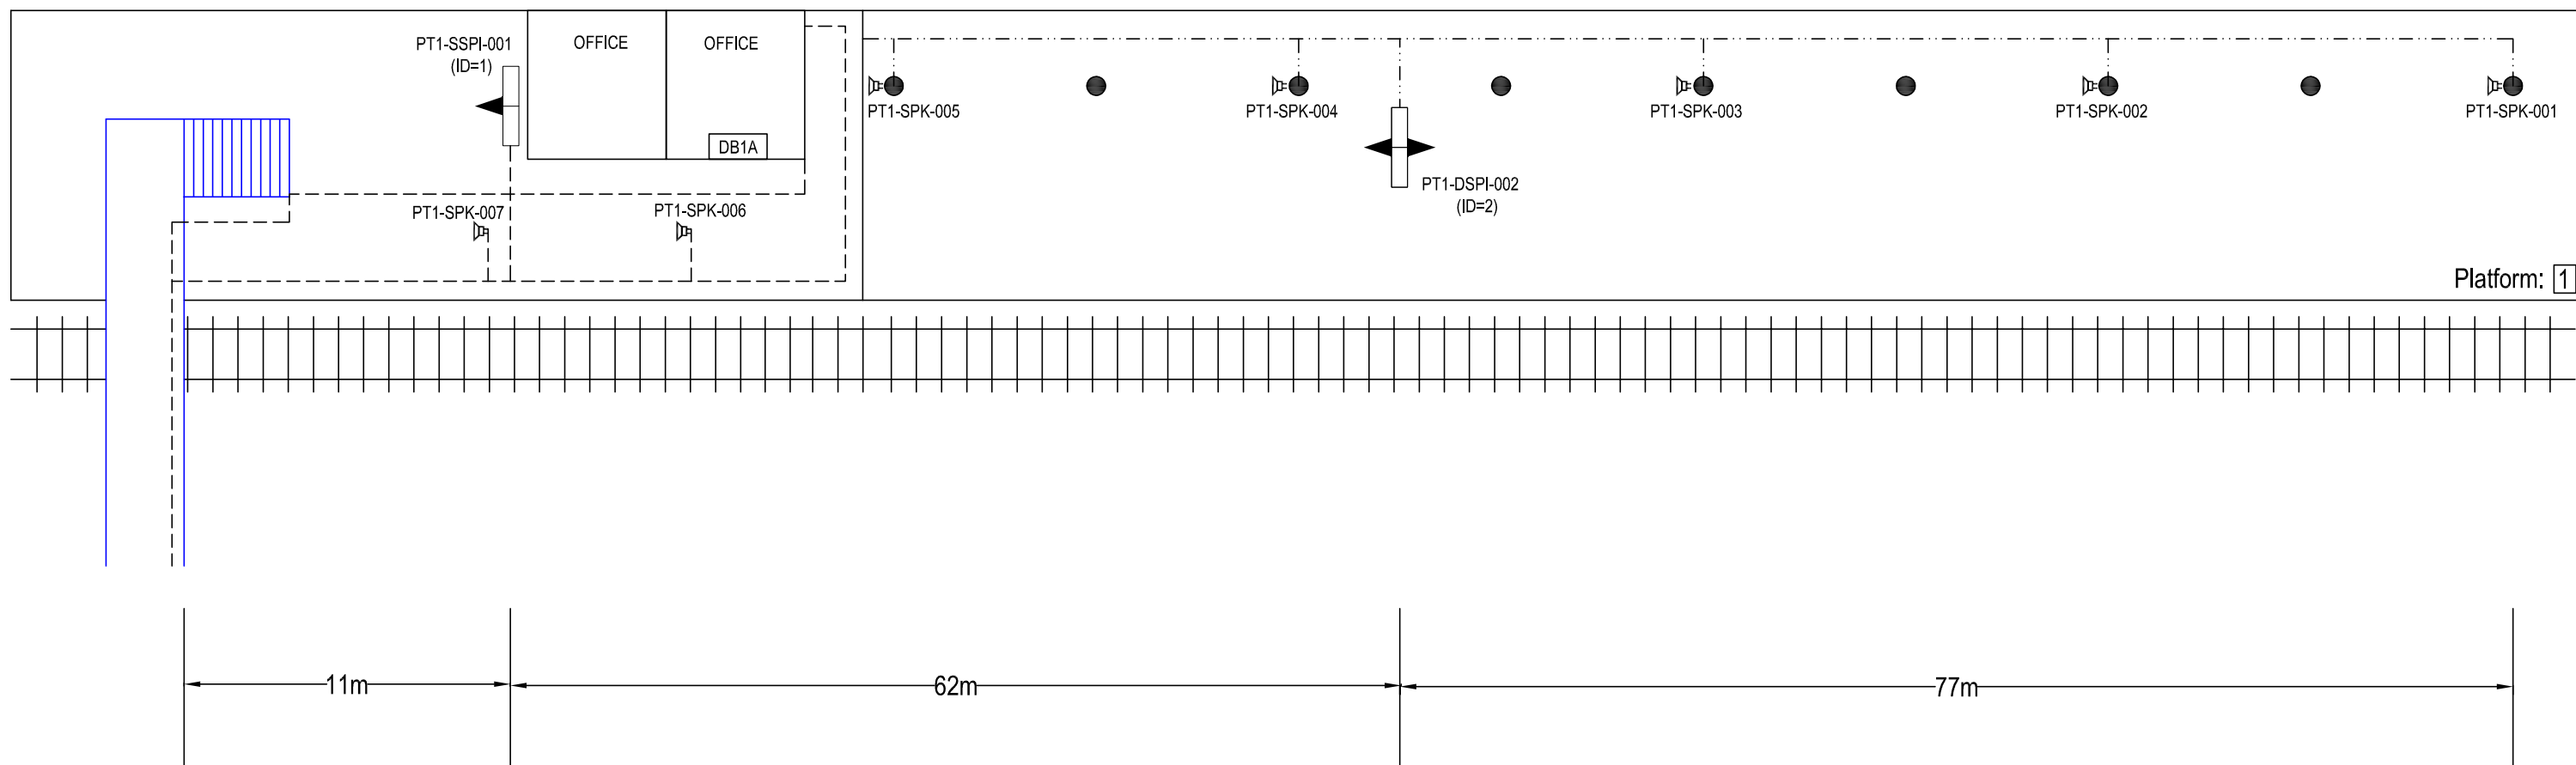


IF IN DOUBT ASK!

MATERIAL	CONSTRUCTION	<table border="1"> <tr> <th></th> <th>NAME</th> <th>SIGNATURE</th> <th>DATE</th> </tr> <tr> <td>DRAWN BY</td> <td>A HATTON</td> <td></td> <td>08-07-2002</td> </tr> <tr> <td>CHECKED BY</td> <td>T WONG</td> <td></td> <td></td> </tr> <tr> <td>APPD BY</td> <td>A SMITH</td> <td></td> <td></td> </tr> <tr> <td>APPD BY</td> <td></td> <td></td> <td></td> </tr> </table>		NAME	SIGNATURE	DATE	DRAWN BY	A HATTON		08-07-2002	CHECKED BY	T WONG			APPD BY	A SMITH			APPD BY				<p>AMEY DATEL Project Offices 1st Floor, Platform 2/3 Eastleigh Station Southampton Road Eastleigh Hants SO50 9FL</p>	SITE/PROJECT SOUTH WEST TRAINS CIS PROJECT	
			NAME	SIGNATURE	DATE																				
DRAWN BY	A HATTON		08-07-2002																						
CHECKED BY	T WONG																								
APPD BY	A SMITH																								
APPD BY																									
FINISH		TITLE PUTNEY AS BUILT		SCALE NTS	DRG No. SM803-75603	ISSUE B	SHEET 1 of 3																		
		CAD Ref:	COPYRIGHT © AMEY Rail All rights reserved. Neither this drawing or any of the information it contains may copied or communicated to third parties without the written permission of the copyright holder																						
		CONTRACTOR'S Ref:																							


WAN	
CIRCUIT ID	KXIP600379
IP ADDRESS	10.227.9.1

"PLATFORM 1 HP ISDN"
020-8788-0353
"PLATFORM 2/3 HP ISDN"
020-8788-0367
"PLATFORM 4 HP ISDN"
020-8788-0678

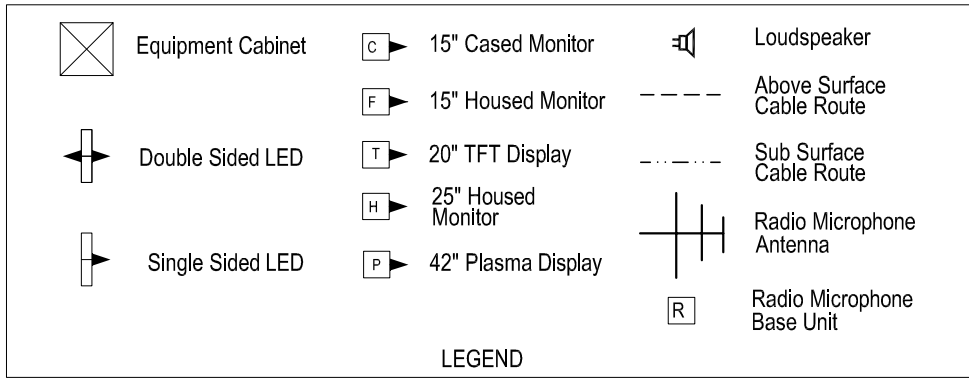

Equipment	Dist Board
EXISTING SPURS USED	

All Equipment tags to be prefixed with "PUT-"

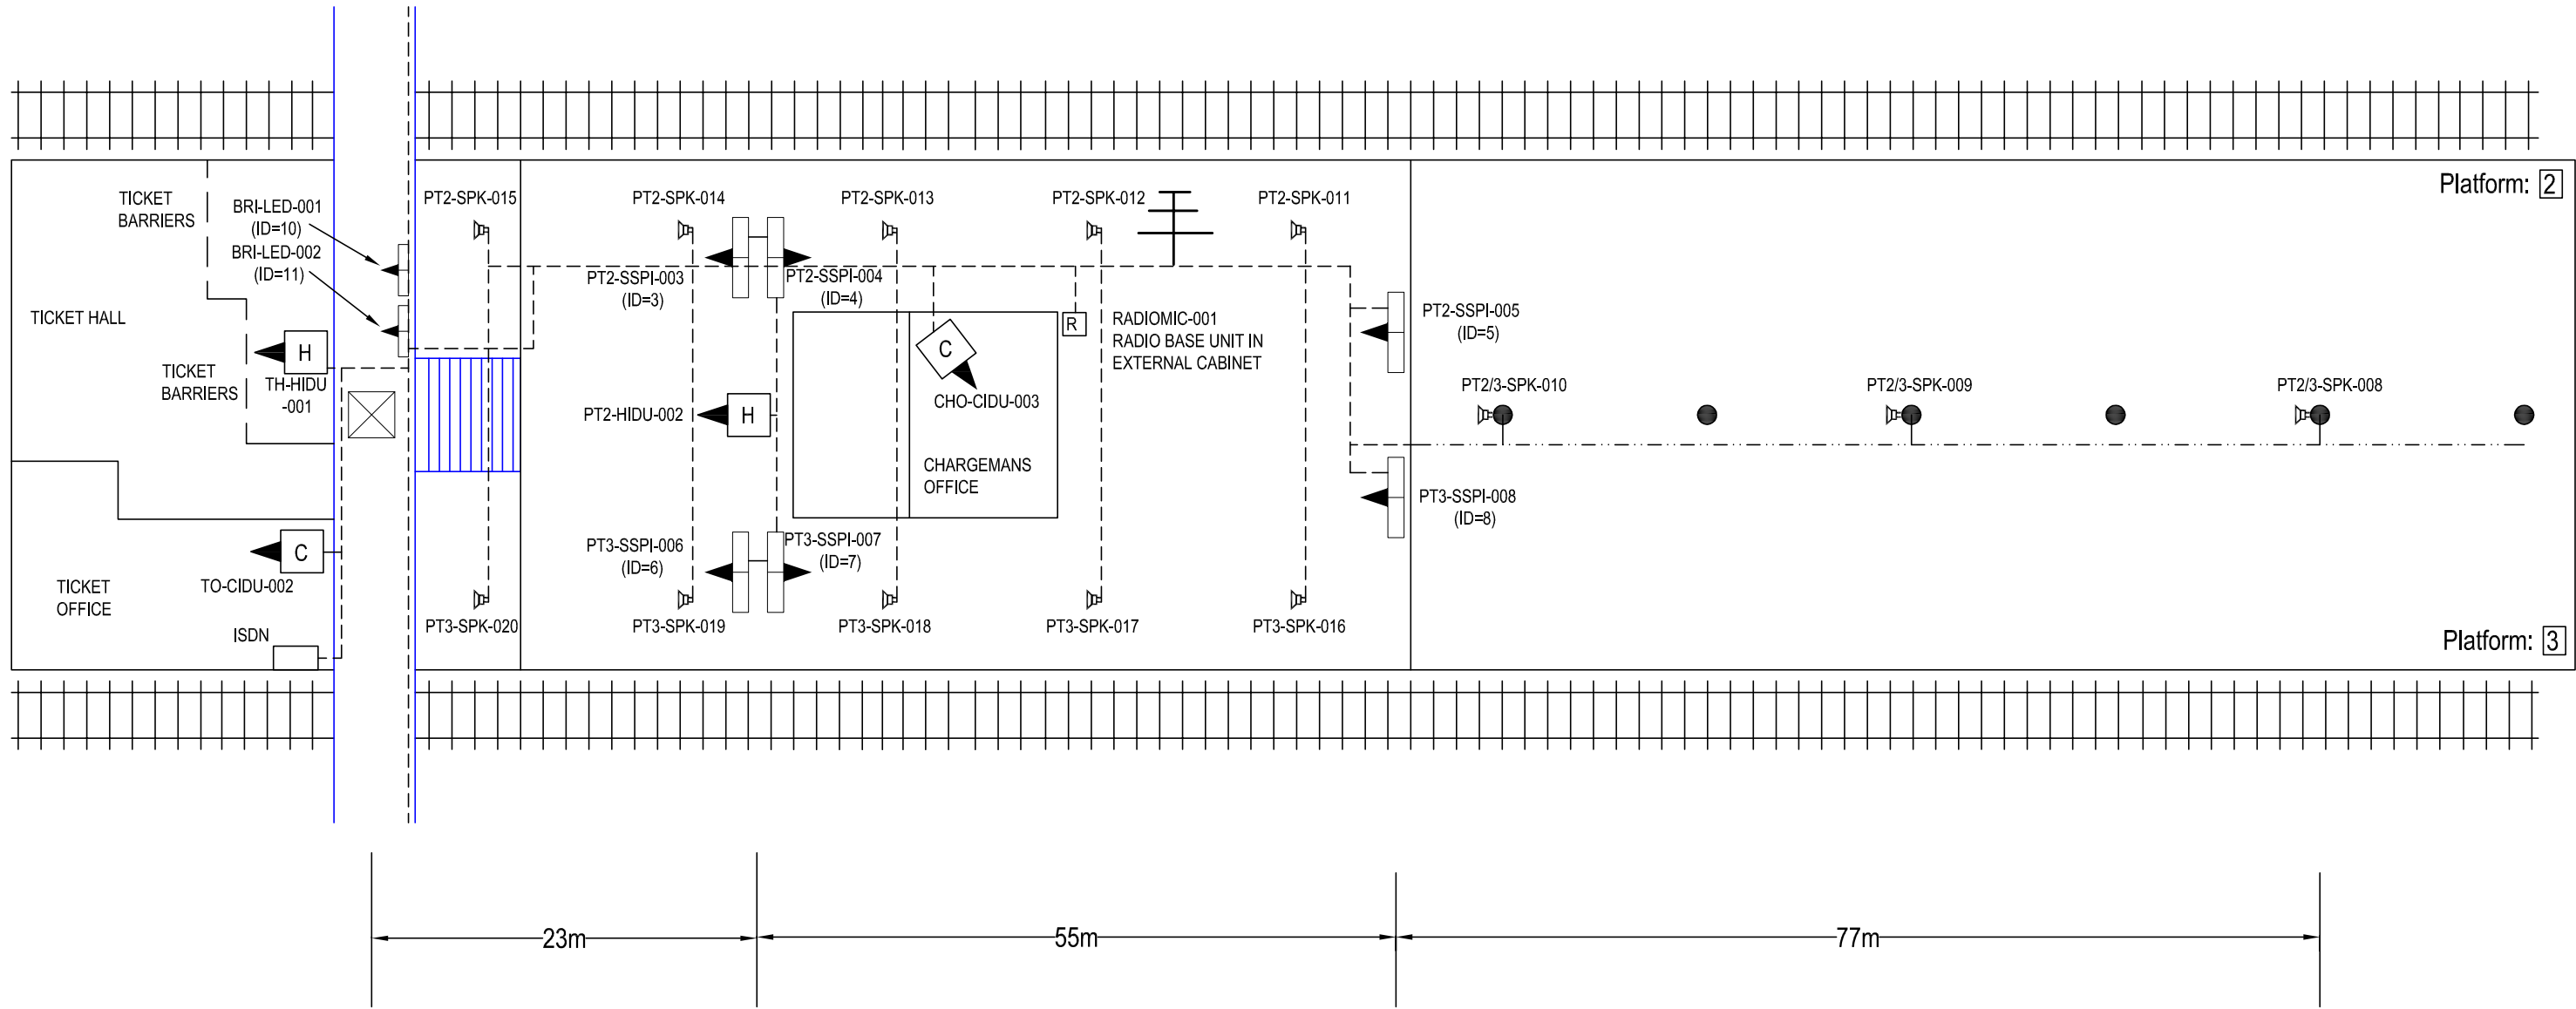

IF IN DOUBT ASK!

MATERIAL	CONSTRUCTION	DRAWN BY	A HATTON	SIGNATURE		AMEY DATEL Project Offices 1st Floor, Platform 2/3 Eastleigh Station Southampton Road Eastleigh Hants SO50 9FL	SITE/PROJECT		SOUTH WEST TRAINS CIS PROJECT	
		CHECKED BY	T WONG	DATE	08-07-2002		TITLE	PUTNEY AS BUILT		
FINISH		APPD BY	A SMITH			COPYRIGHT © AMEY Rail All rights reserved. Neither this drawing or any of the information it contains may copied or communicated to third parties without the written permission of the copyright holder	SCALE	DRG No.	ISSUE	SHEET
		CAD Ref:					NTS	SM803-75603	B	2 of 3
		CONTRACTOR'S Ref:								

DRG No. SM803-75603

WAN	
CIRCUIT ID	KXIP600379
IP ADDRESS	10.227.9.1


"PLATFORM 1 HP ISDN"	020-8788-0353
"PLATFORM 2/3 HP ISDN"	020-8788-0367
"PLATFORM 4 HP ISDN"	020-8788-0678

	Equipment Cabinet		15" Cased Monitor		Loudspeaker
	Double Sided LED		15" Housed Monitor		Above Surface Cable Route
	Single Sided LED		20" TFT Display		Sub Surface Cable Route
			25" Housed Monitor		Radio Microphone Antenna
			42" Plasma Display		Radio Microphone Base Unit

LEGEND

Equipment	Dist Board	
EXISTING SUPPLIES USED		

All Equipment tags to be prefixed with "PUT-"

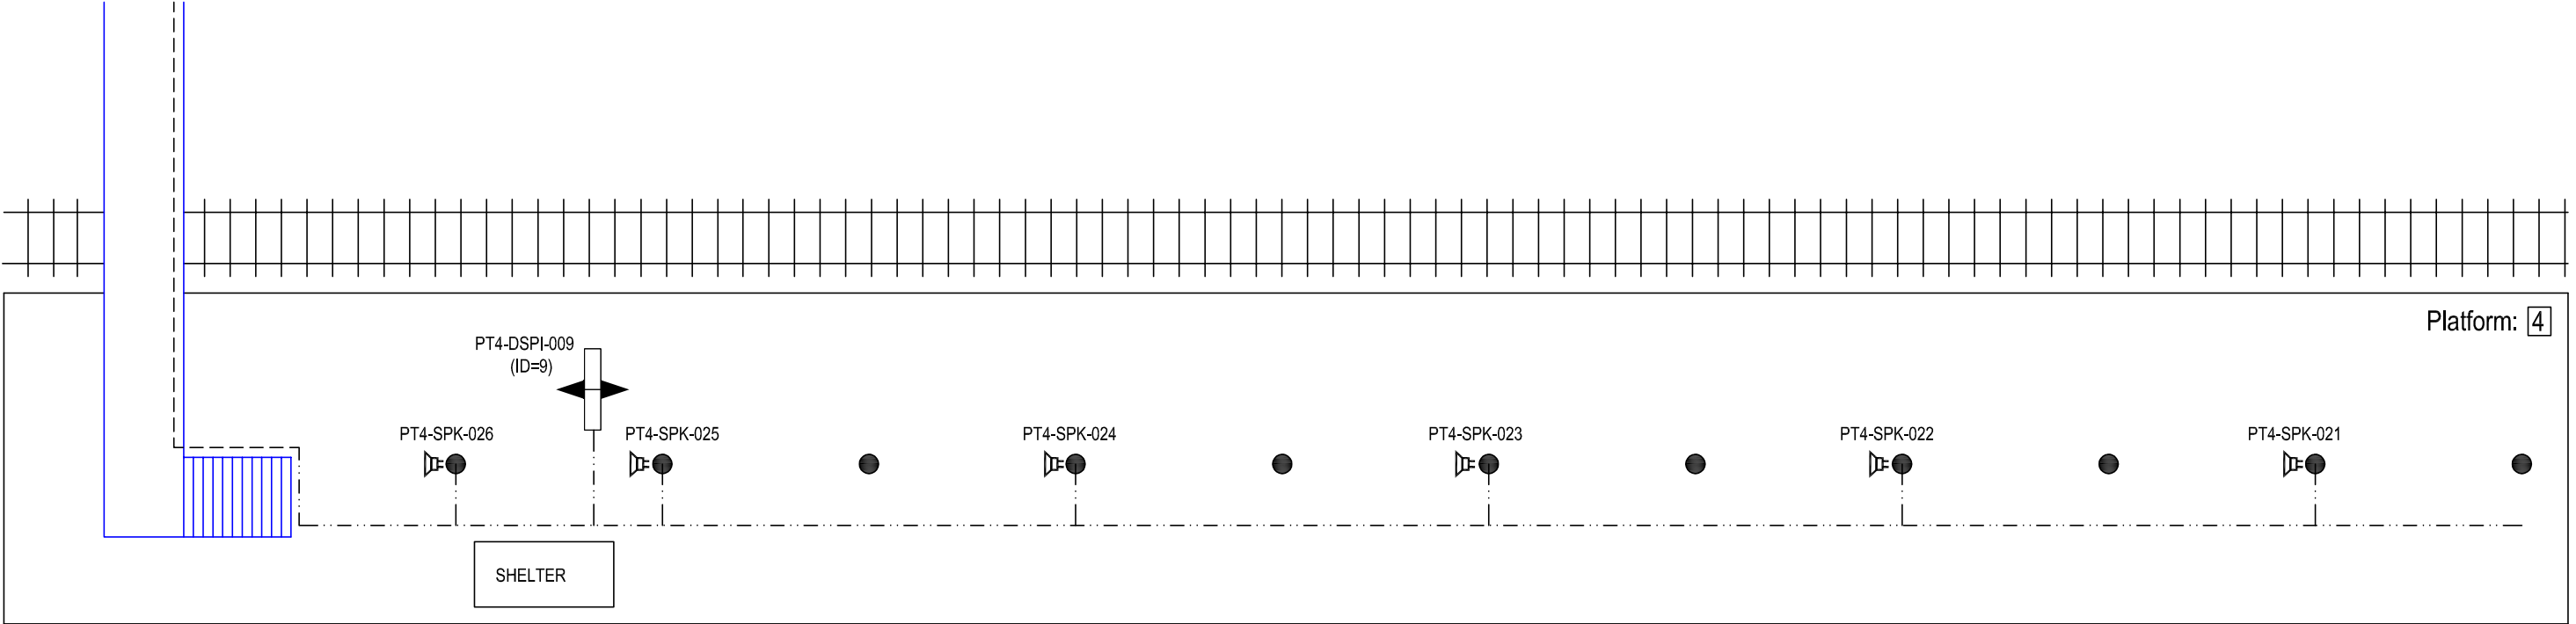

IF IN DOUBT ASK!

MATERIAL	CONSTRUCTION	DRAWN BY	A HATTON	SIGNATURE		AMEY DATEL Project Offices 1st Floor, Platform 2/3 Eastleigh Station Southampton Road Eastleigh Hants SO50 9FL	SITE/PROJECT		SOUTH WEST TRAINS CIS PROJECT	
		CHECKED BY	T WONG	DATE	08-07-2002		TITLE		PUTNEY AS BUILT	
FINISH		APPD BY	A SMITH			COPYRIGHT © AMEY Rail All rights reserved. Neither this drawing or any of the information it contains may be copied or communicated to third parties without the written permission of the copyright holder	SCALE	DRG No.	ISSUE	SHEET
		CAD Ref:					NTS	SM803-75603	B	3 of 3
		CONTRACTOR'S Ref:								