

DRG No. SM803-75569

WAN	
CIRCUIT ID	KXIP 600381
IP ADDRESS	10.227.194.1




"PLATFORMS 1 & 2 HP ISDN"	020-8946-4014
"PLATFORMS 3 & 4 HP ISDN"	020-8946-4036

All Equipment tags to be prefixed with "RAY-"

LEGEND

	Equipment Cabinet		15" Cased Monitor		Loudspeaker
	Double Sided LED		15" Housed Monitor		Above Surface Cable Route
	Single Sided LED		20" TFT Display		Sub Surface Cable Route
			25" Housed Monitor		Radio Microphone Antenna
			42" Plasma Display		Radio Microphone Base Unit

Equipment	Dist Board	
CIS RACK	GP1 B1/A2 CCT11	20A
PT2-DSPI-006	GP1 B1/A2 CCT10	7.5A
PT1-DSPI-005	GP1 B1/A2 CCT10	7.5A
PT1-SSPI-001	GP1 B1/A2 CCT7	7.5A
PT2-SSPI-002	GP1 B1/A2 CCT7	7.5A

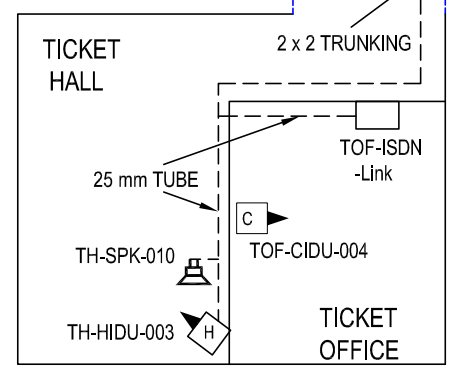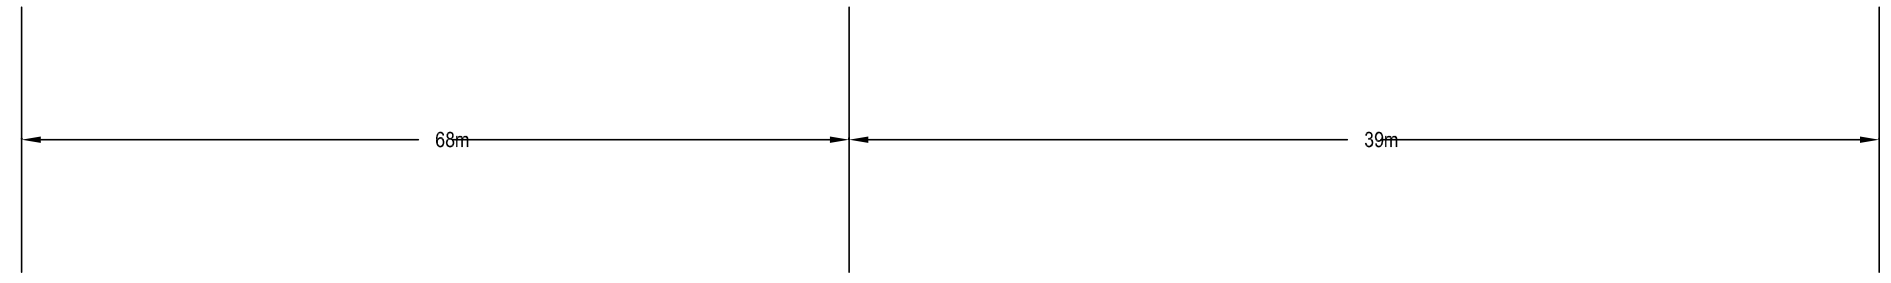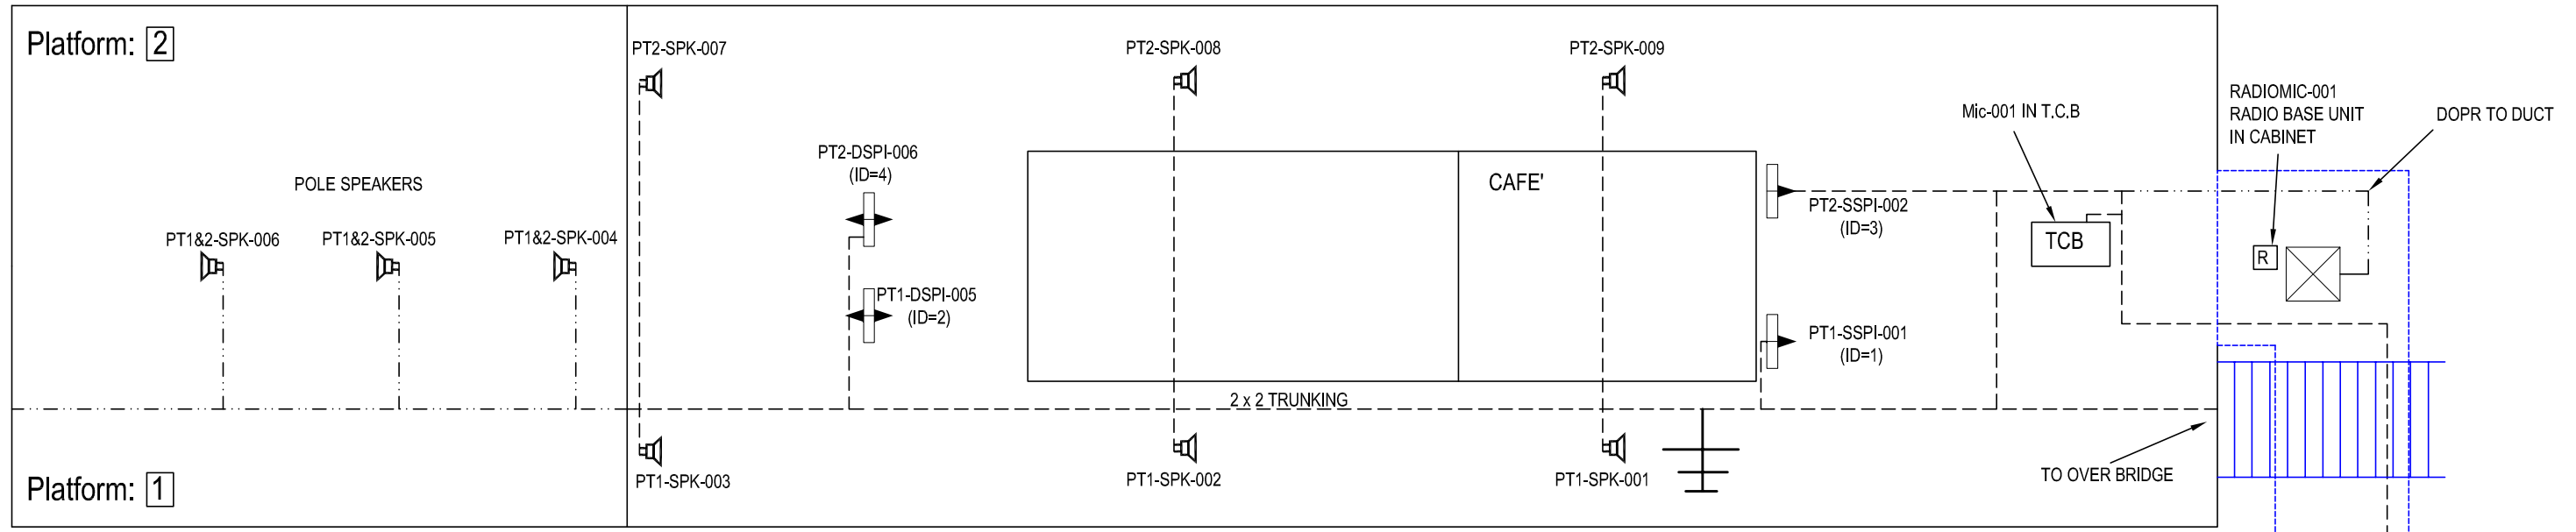

IF IN DOUBT ASK!

MATERIAL	CONSTRUCTION	NAME	SIGNATURE	DATE	 AMEY DATEL Project Offices 1st Floor, Platform 2/3 Eastleigh Station Southampton Road Eastleigh Hants SO50 9FL	SITE/PROJECT		SOUTH WEST TRAINS CIS PROJECT	
		DRAWN BY	D GADDU	20-05-2002		TITLE	RAYNES PARK AS BUILT		
FINISH		CHECKED BY	T WONG		COPYRIGHT © AMEY Rail All rights reserved. Neither this drawing or any of the information it contains may be copied or communicated to third parties without the written permission of the copyright holder	SCALE	DRG No.	ISSUE	SHEET
		APPD BY	A SMITH			NTS	SM803-75569	B	1 of 2
		CONTRACTOR'S Ref:							

WAN	
CIRCUIT ID	KXIP 600381
IP ADDRESS	10.227.194.1



"PLATFORMS 1 & 2 HP ISDN"	020-8946-4014
"PLATFORMS 3 & 4 HP ISDN"	020-8946-4036

All Equipment tags to be prefixed with "RAY-"

LEGEND

	Equipment Cabinet		15" Cased Monitor		Loudspeaker
	Double Sided LED		15" Housed Monitor		Above Surface Cable Route
	Single Sided LED		20" TFT Display		Sub Surface Cable Route
			25" Housed Monitor		Radio Microphone Antenna
			42" Plasma Display		Radio Microphone Base Unit

Equipment	Dist Board	
PT3-DSPI-003	GP1 CCT 6	RCCB 20MA 32A
PT4-DSPI-004	GP1 CCT 6	RCCB 20MA 32A
PT3&4-CIDU-006	GP1 CCT 6	RCCB 20MA 32A

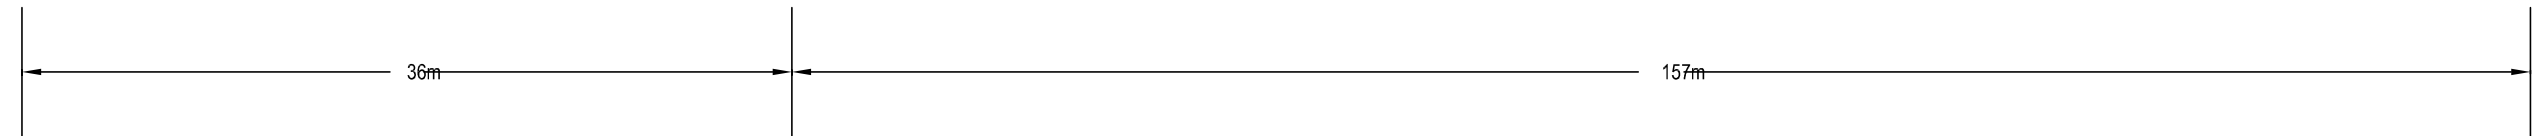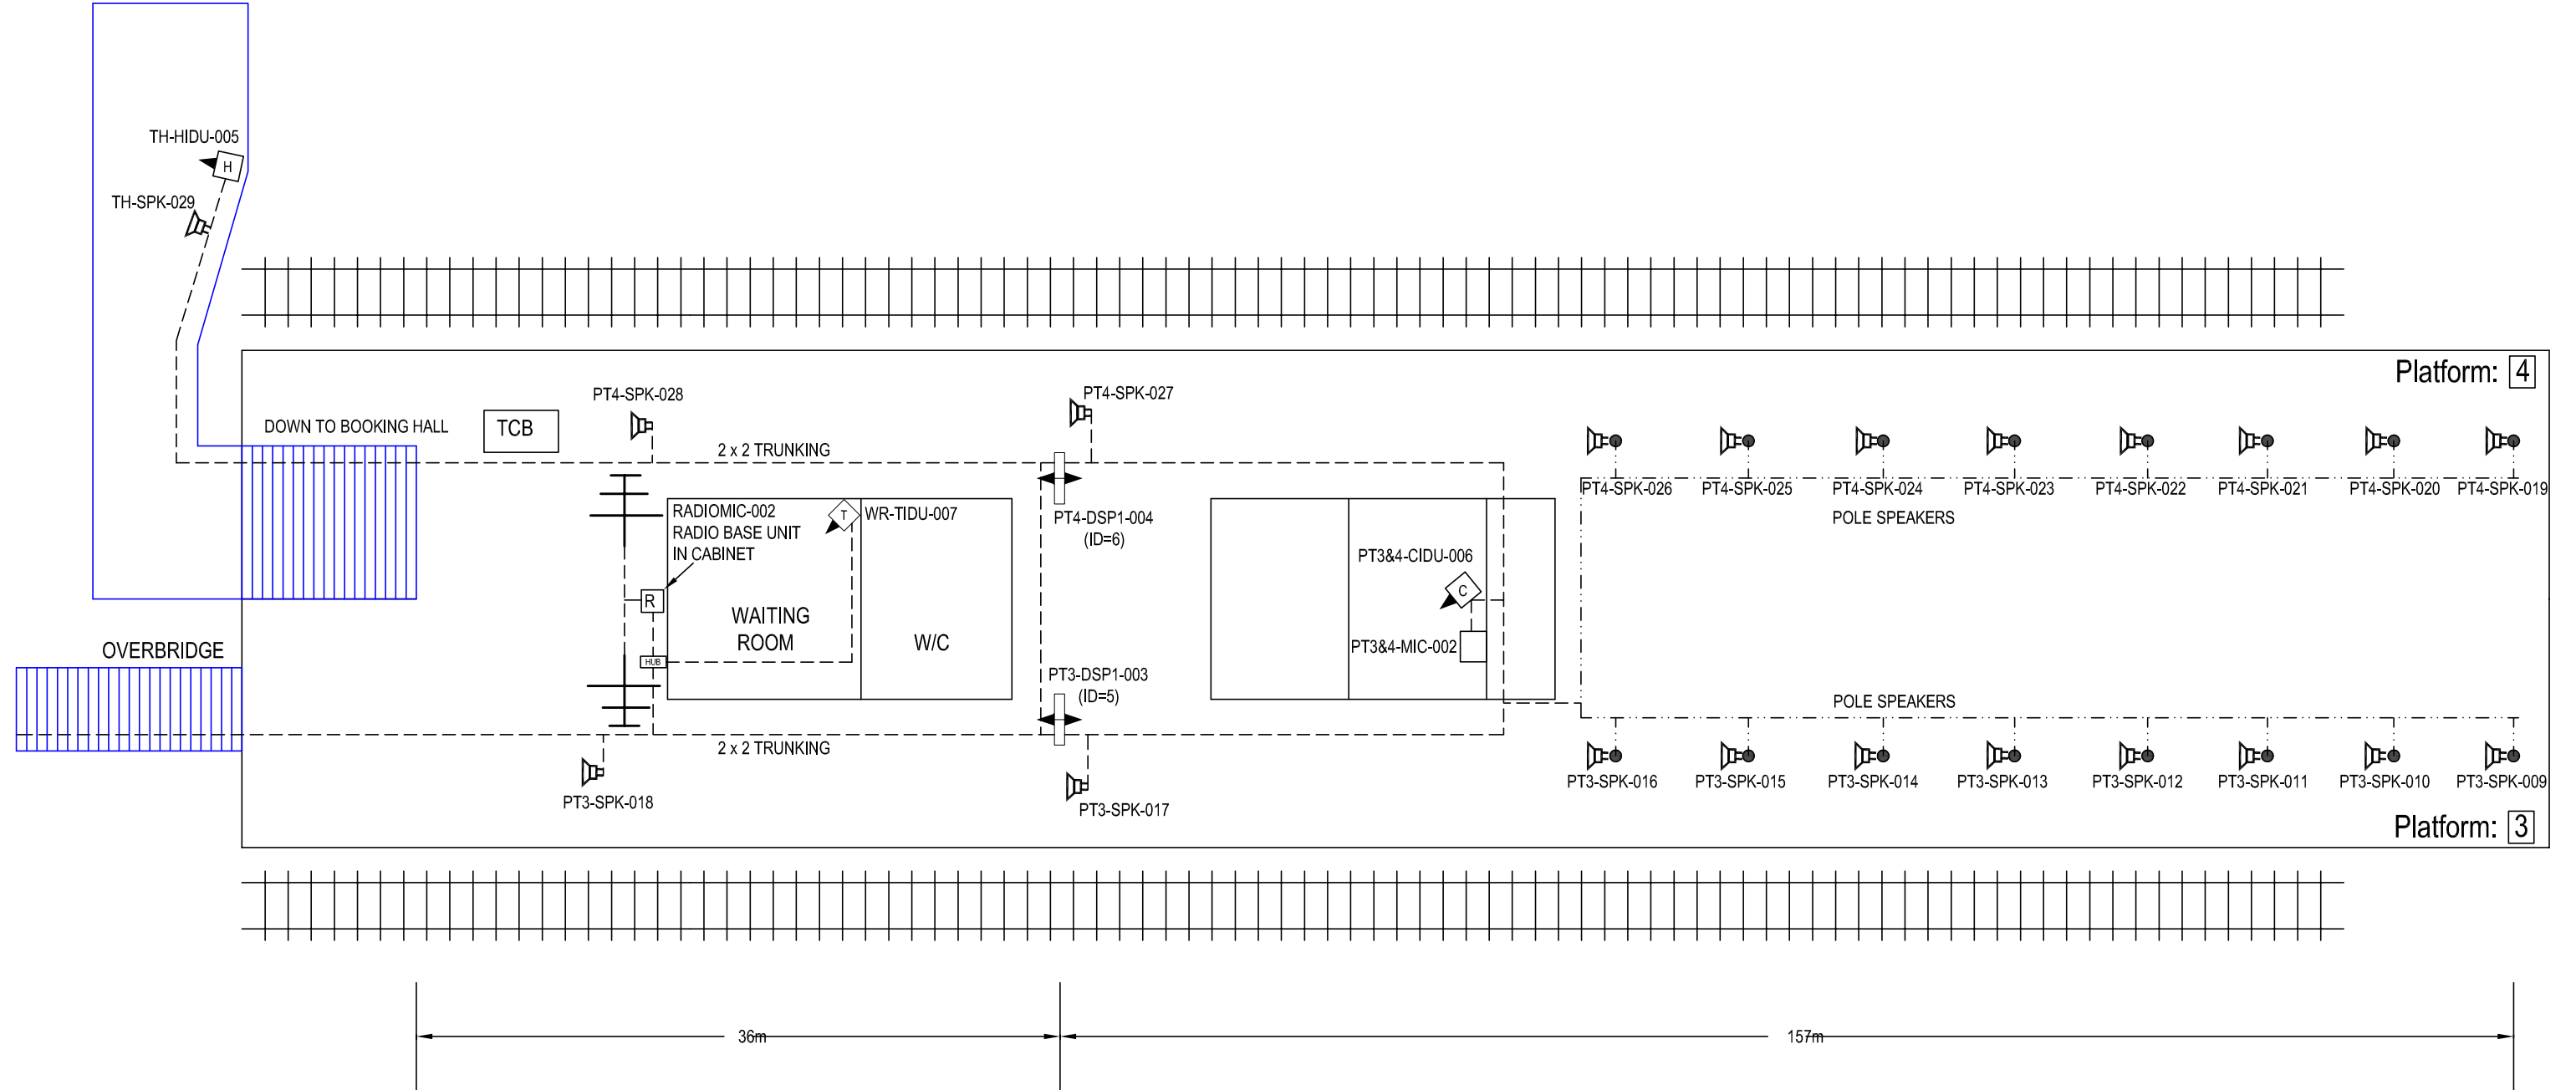

		IF IN DOUBT ASK!				AMEY DATEL Project Offices 1st Floor, Platform 2/3 Eastleigh Station Southampton Road Eastleigh Hants SO50 9FL	SITE/PROJECT		
MATERIAL	CONSTRUCTION	DRAWN BY	D GADDU	SIGNATURE	DATE		SOUTH WEST TRAINS CIS PROJECT		
		CHECKED BY	T WONG			TITLE			
		APPD BY	A SMITH			RAYNES PARK AS BUILT			
FINISH		CAD Ref:				SCALE	DRG No.	ISSUE	SHEET
		CONTRACTOR'S Ref:				NTS	SM803-75569	C	2 of 2



COPYRIGHT © AMEY Rail
All rights reserved. Neither this drawing or any of the information it contains may be copied or communicated to third parties without the written permission of the copyright holder