


DRG No. SM803-75912


"PLATFORM 1 HP ISDN"
02380-866124
"PLATFORM 2 HP ISDN"
02380-866184

WAN	
CIRCUIT ID	KXIP 600383
IP ADDRESS	10.227.195.1


All Equipment tags to be prefixed with "RDB-"

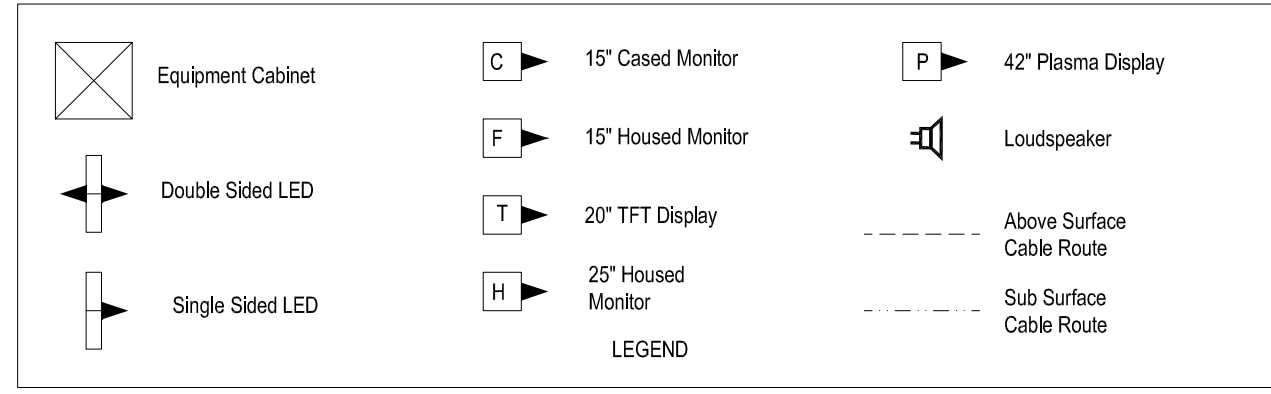

Equipment	Dist Board
CIS CAB	CCT NO.1
HEATHER	CCT NO.2
13A TWIN	CCT NO.3
EXTRACT FAN	CCT NO.4
PT1 LED	CCT NO.5
PT2 LED	CCT NO.6

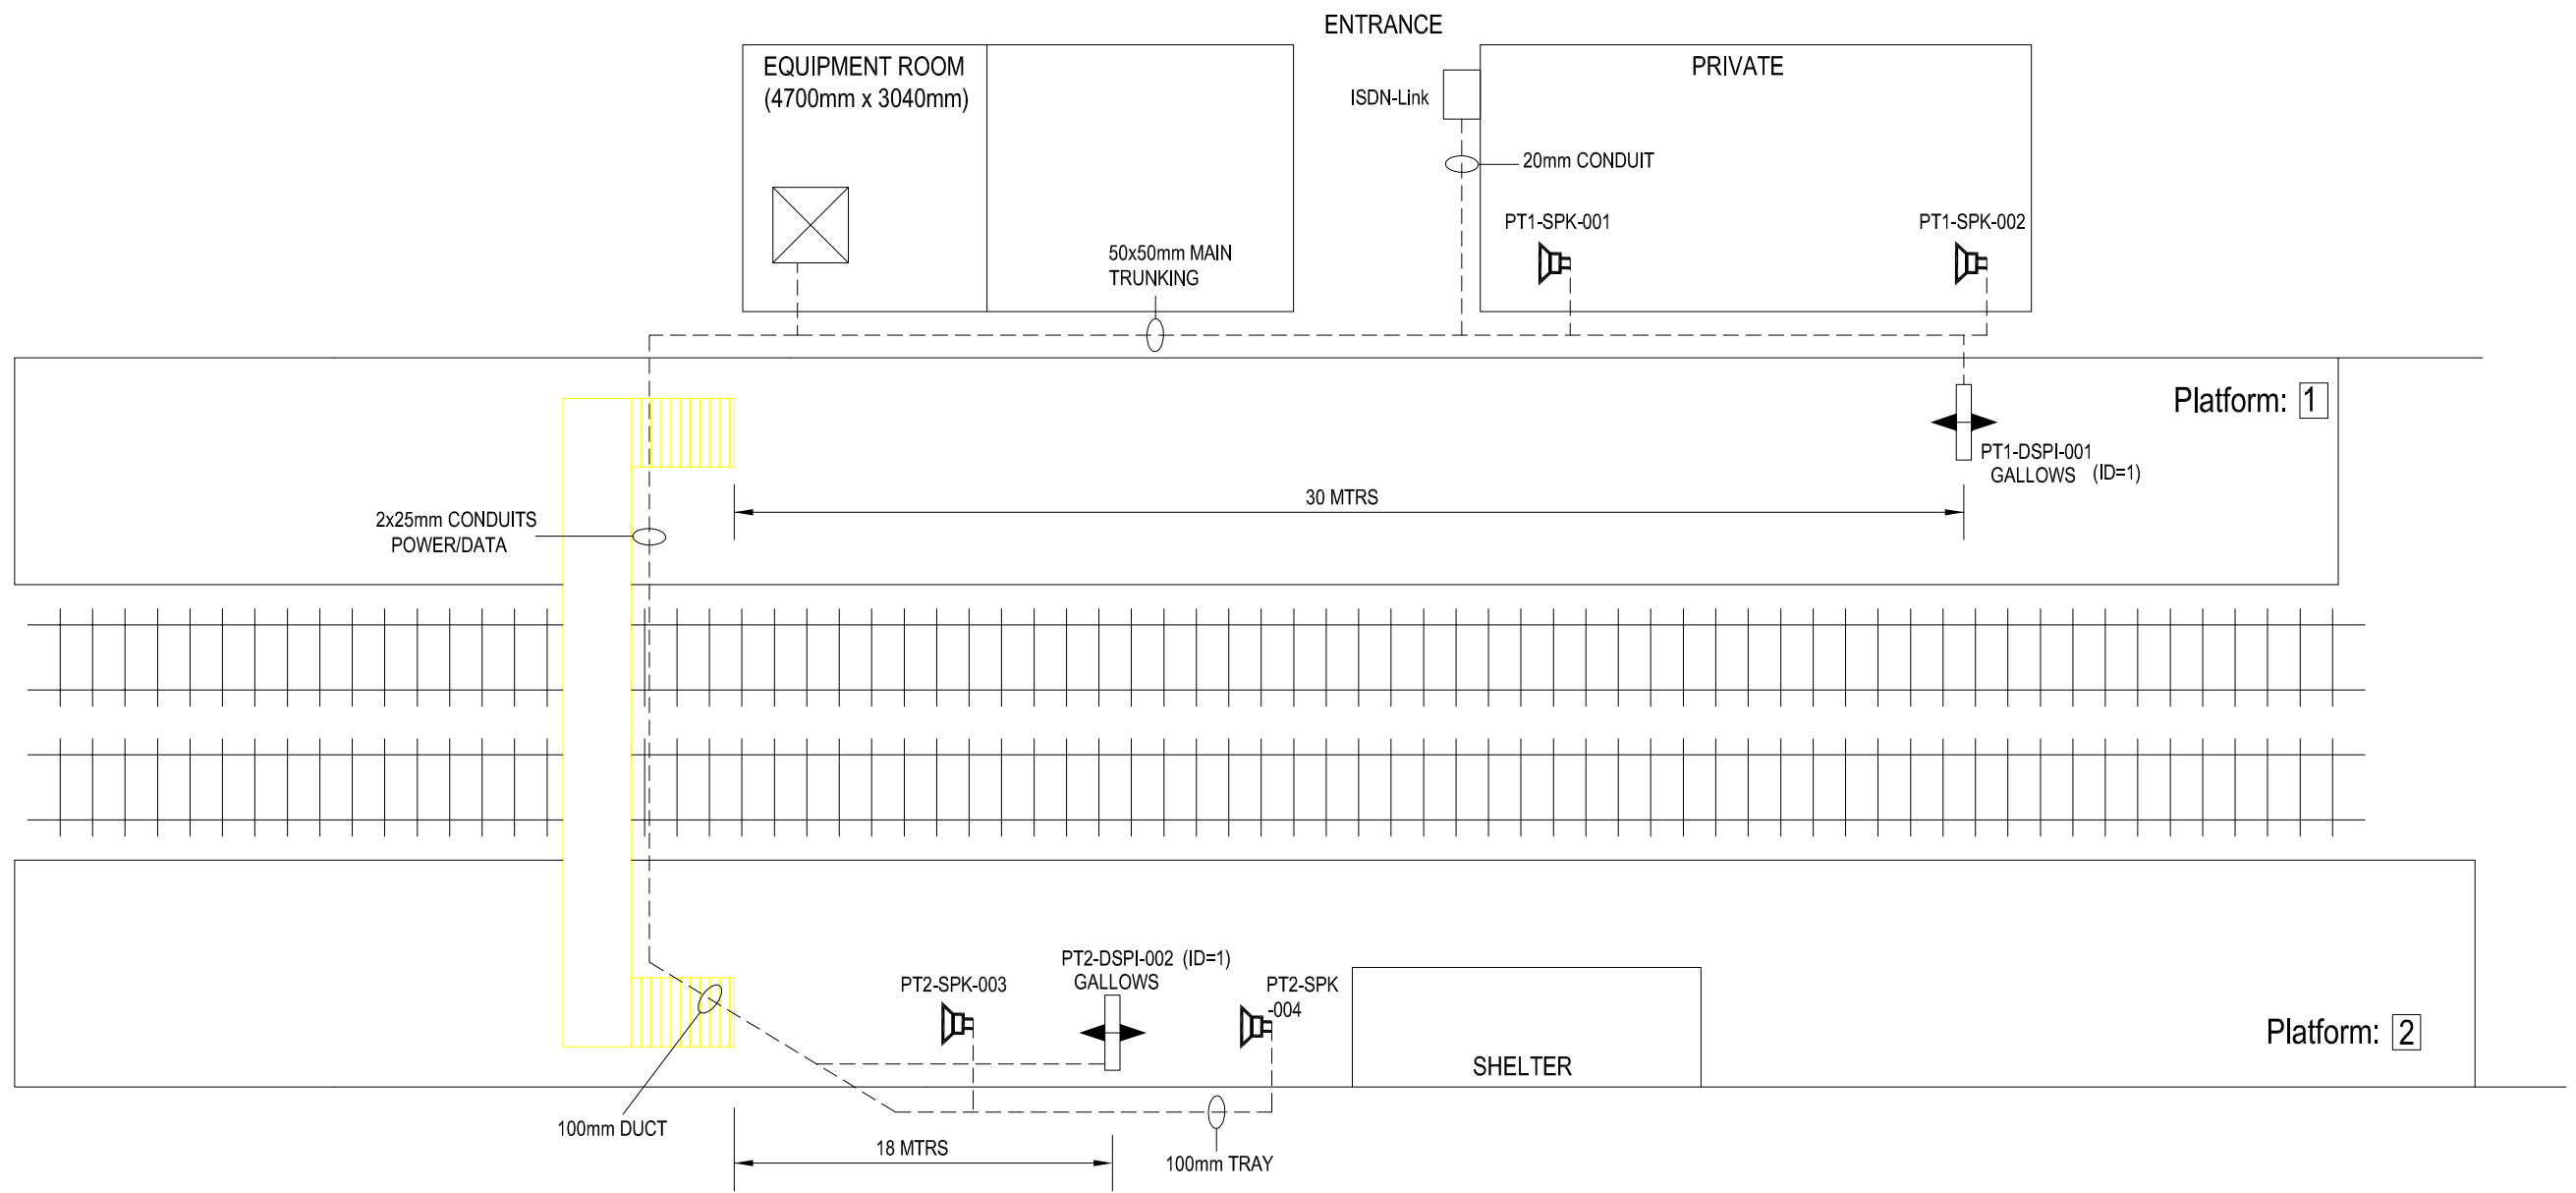

IF IN DOUBT ASK!

MATERIAL	CONSTRUCTION	NAME	SIGNATURE	DATE	 AMEY DATEL Project Offices 1st Floor, Platform 2/3 Eastleigh Station Southampton Road Eastleigh Hants SO50 9FL	SITE/PROJECT		SOUTH WEST TRAINS CIS PROJECT	
		DRAWN BY	D GADDU	24-01-2002		TITLE	REDBRIDGE AS BUILT		
FINISH		CHECKED BY			COPYRIGHT © AMEY Rail All rights reserved. Neither this drawing or any of the information it contains may be copied or communicated to third parties without the written permission of the copyright holder	SCALE	DRG No.	ISSUE	SHEET
		APPD BY				NTS	SM803-75912	B	1 of 1
		CONTRACTOR'S Ref:							