






WAN	
CIRCUIT ID	KXIP600389
IP ADDRESS	10.227.196.1

"PLATFORM 1 HP ISDN"	02392-412105
"PLATFORM 2 HP ISDN"	02392-412107

All Equipment tags to be prefixed with "RLN-"

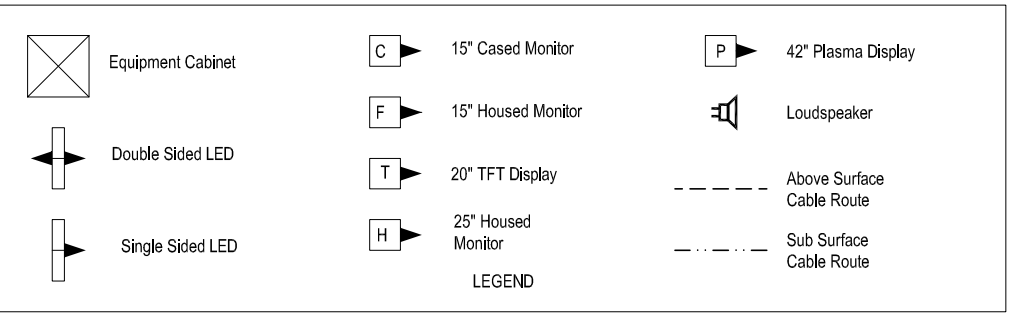

Equipment	Dist Board	
CIS RACK	9 WAY CRABTREE CCT6	20A
PT1-DSPI-001	GP2 CCT 7	16A
PT2-SSPI-002	GP2 CCT8	16A
PT2-SSPI-003	GP2 CCT8	16A
TOF-CIDU-001	EXISTING	

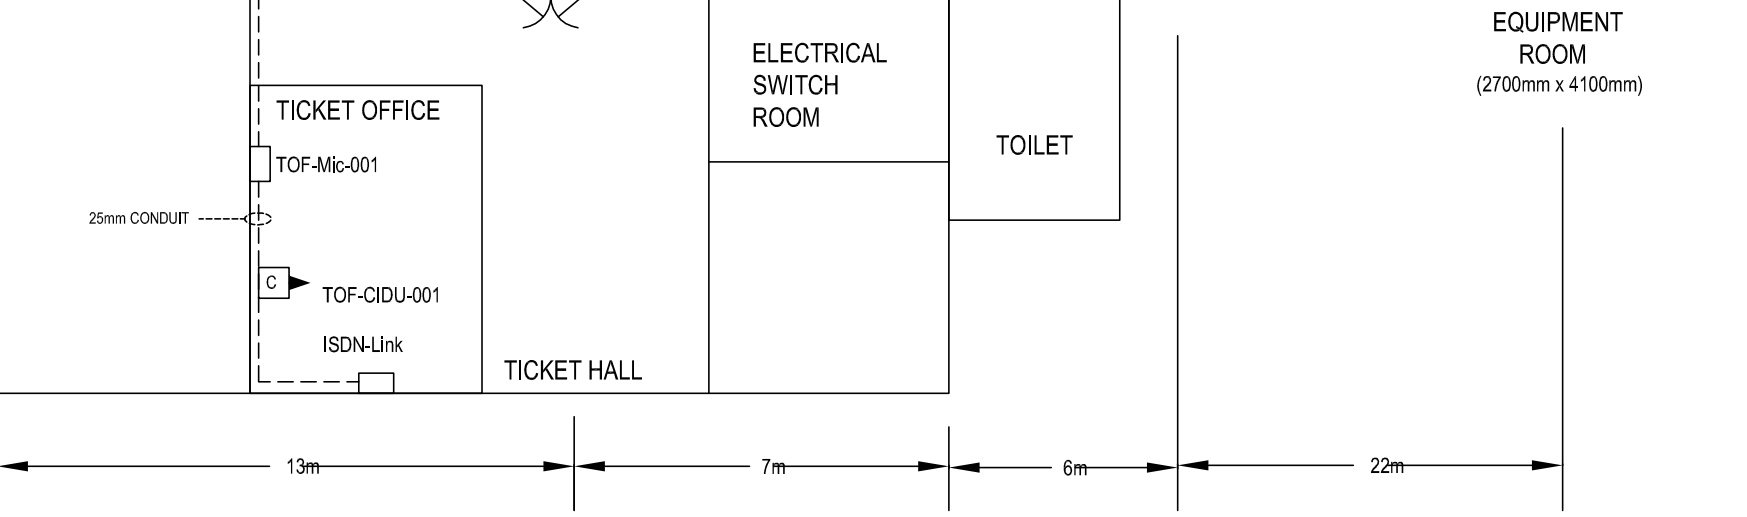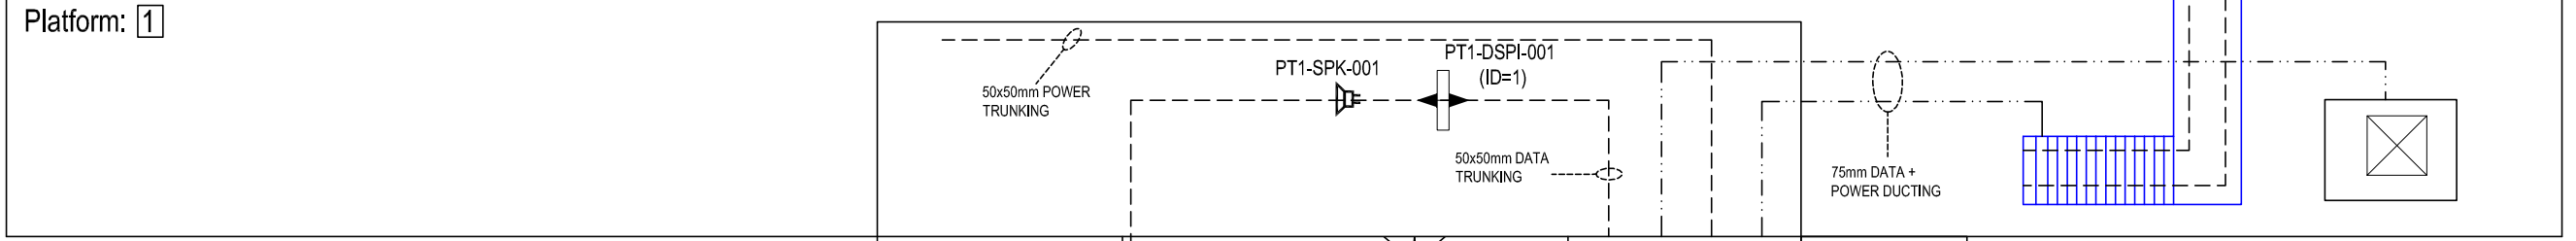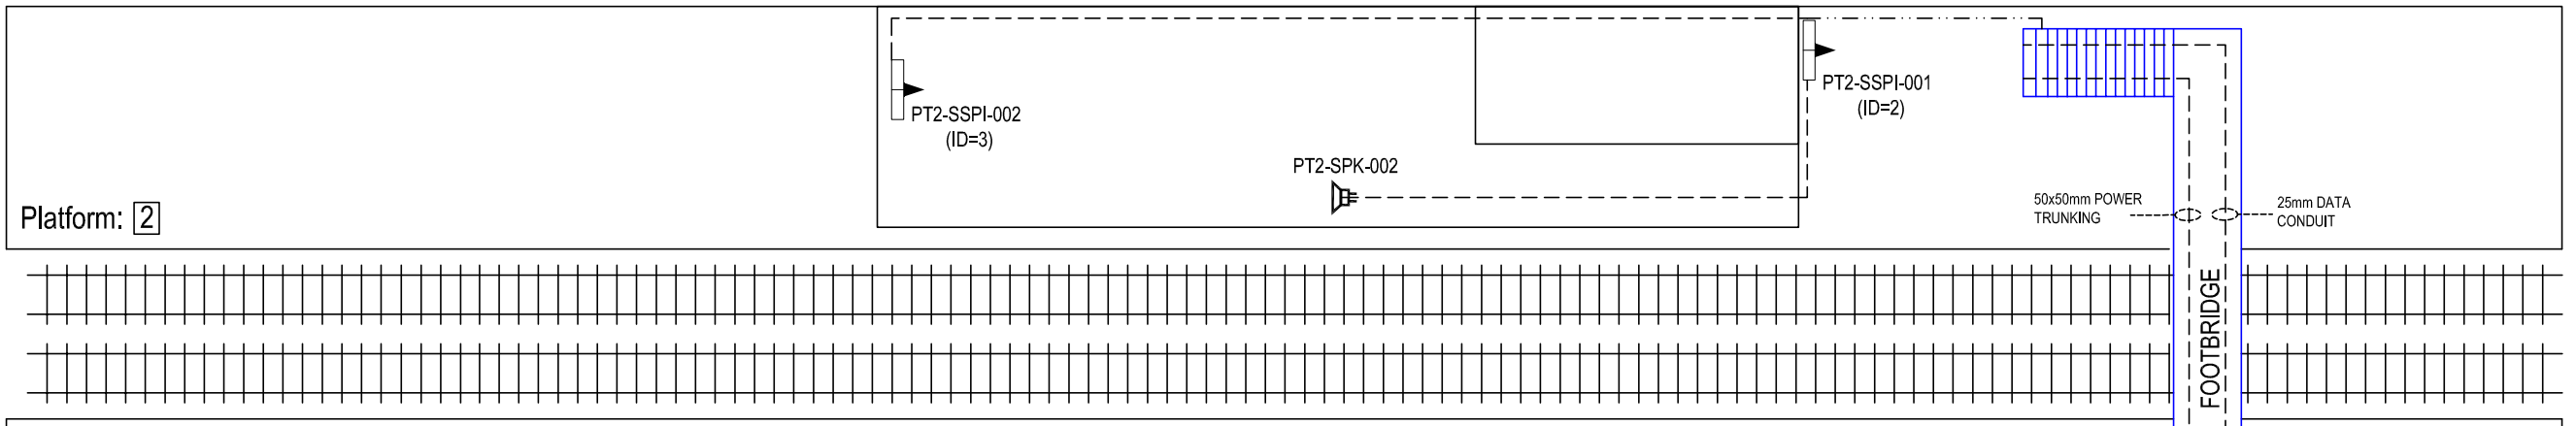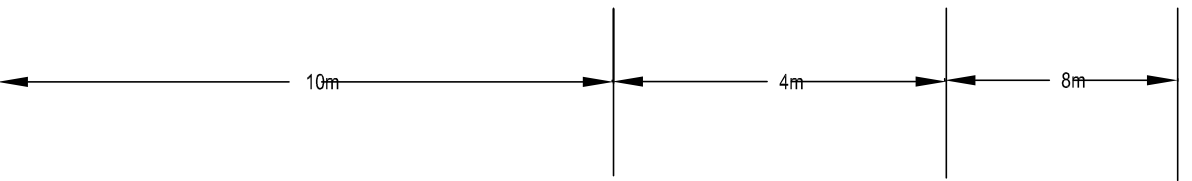

IF IN DOUBT ASK!

MATERIAL	CONSTRUCTION	DRAWN BY	A HATTON	SIGNATURE		AMEY DATEL Project Offices 1st Floor, Platform 2/3 Eastleigh Station Southampton Road Eastleigh Hants SO50 9FL	SITE/PROJECT		SOUTH WEST TRAINS CIS PROJECT	
		CHECKED BY	T WONG	DATE	24-04-2002		TITLE	ROWLANDS CASTLE AS BUILT		
FINISH	CONSTRUCTION	APPD BY	A SMITH				SCALE	DRG No.	ISSUE	SHEET
		CAD Ref:					NTS	SM803-75658	B	1 of 1
		CONTRACTOR'S Ref:				COPYRIGHT © AMEY Rail All rights reserved. Neither this drawing or any of the information it contains may be copied or communicated to third parties without the written permission of the copyright holder				