

DRG No.


SM803-75663

WAN	
CIRCUIT ID	MXIP201560
IP ADDRESS	10.227.67.1


"PLATFORM 1A HP ISDN"	01-344-874803
"PLATFORM 1B/2 HP ISDN"	01-344-874236
"PLATFORM 3 HP ISDN"	01-344-874109

All Equipment tags to be prefixed with "SAL-"

Note 1 - Loop through cable attached to Chargemens Office monitor (COF-CIDU-001) going to first floor training room.

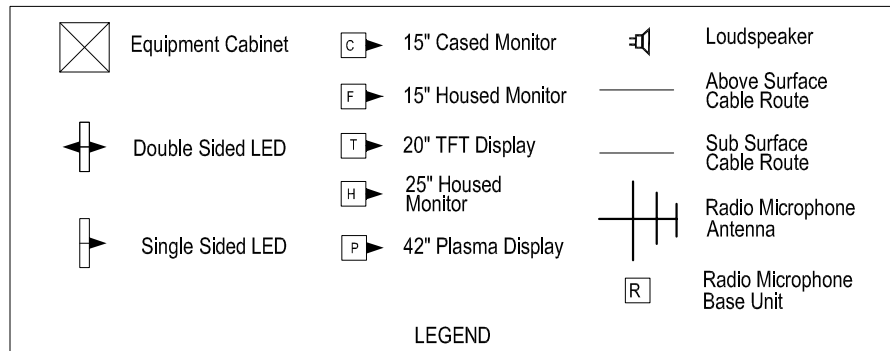

Equipment	Dist Board	
EXISTING		
CIRCUITS USED		

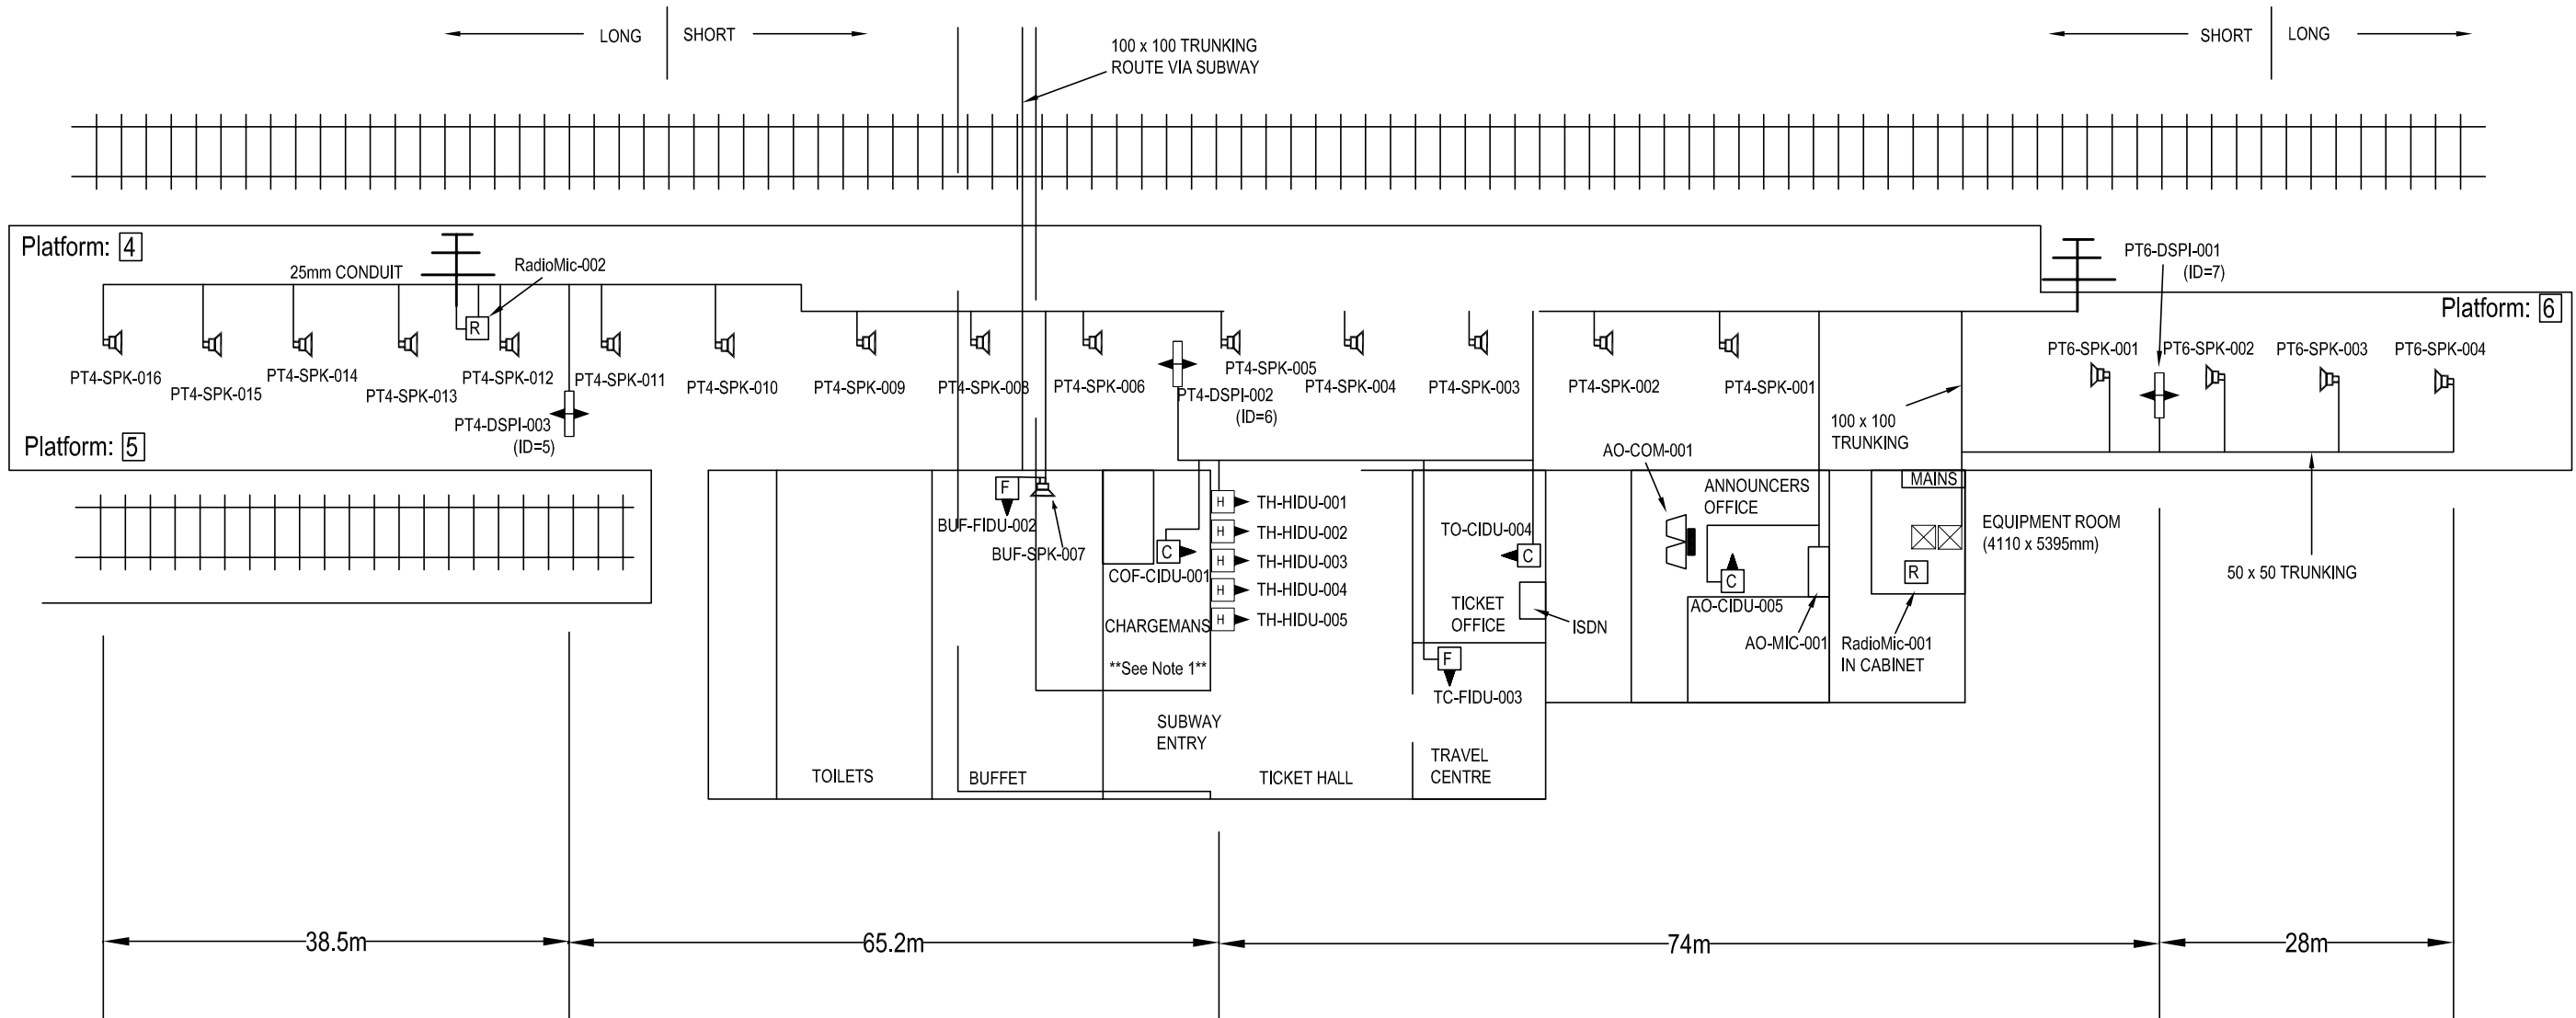


IF IN DOUBT ASK!

MATERIAL	CONSTRUCTION	DRAWN BY	A HATTON	SIGNATURE		AMEY DATEL Project Offices 1st Floor, Platform 2/3 Eastleigh Station Southampton Road Eastleigh Hants SO50 9FL	SITE/PROJECT			SOUTH WEST TRAINS CIS PROJECT	
		CHECKED BY	T WONG	DATE	28-04-2002		TITLE		SALISBURY AS BUILT		
FINISH		APPD BY	A SMITH				SCALE	DRG No.	ISSUE	SHEET	
		CAD Ref:					NTS	SM803-75663	C	1 of 2	
		CONTRACTOR'S Ref:				COPYRIGHT © AMEY Rail All rights reserved. Neither this drawing or any of the information it contains may be copied or communicated to third parties without the written permission of the copyright holder.					


WAN	
CIRCUIT ID	MXIP201560
IP ADDRESS	10.227.67.1

All Equipment tags to be prefixed with "SAL-"


"PLATFORM 1A HP ISDN"
01-344-874803
"PLATFORM 1B/2 HP ISDN"
01-344-874236
"PLATFORM 3 HP ISDN"
01-344-874109

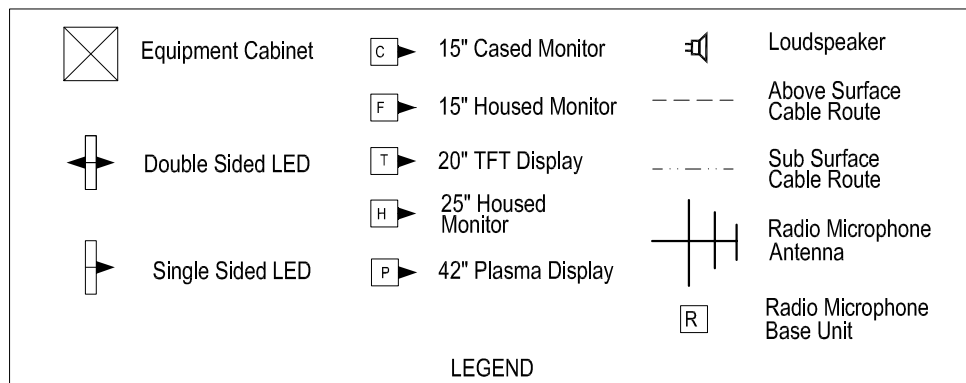

Equipment	Dist Board	
EXISTING		
CIRCUITS USED		

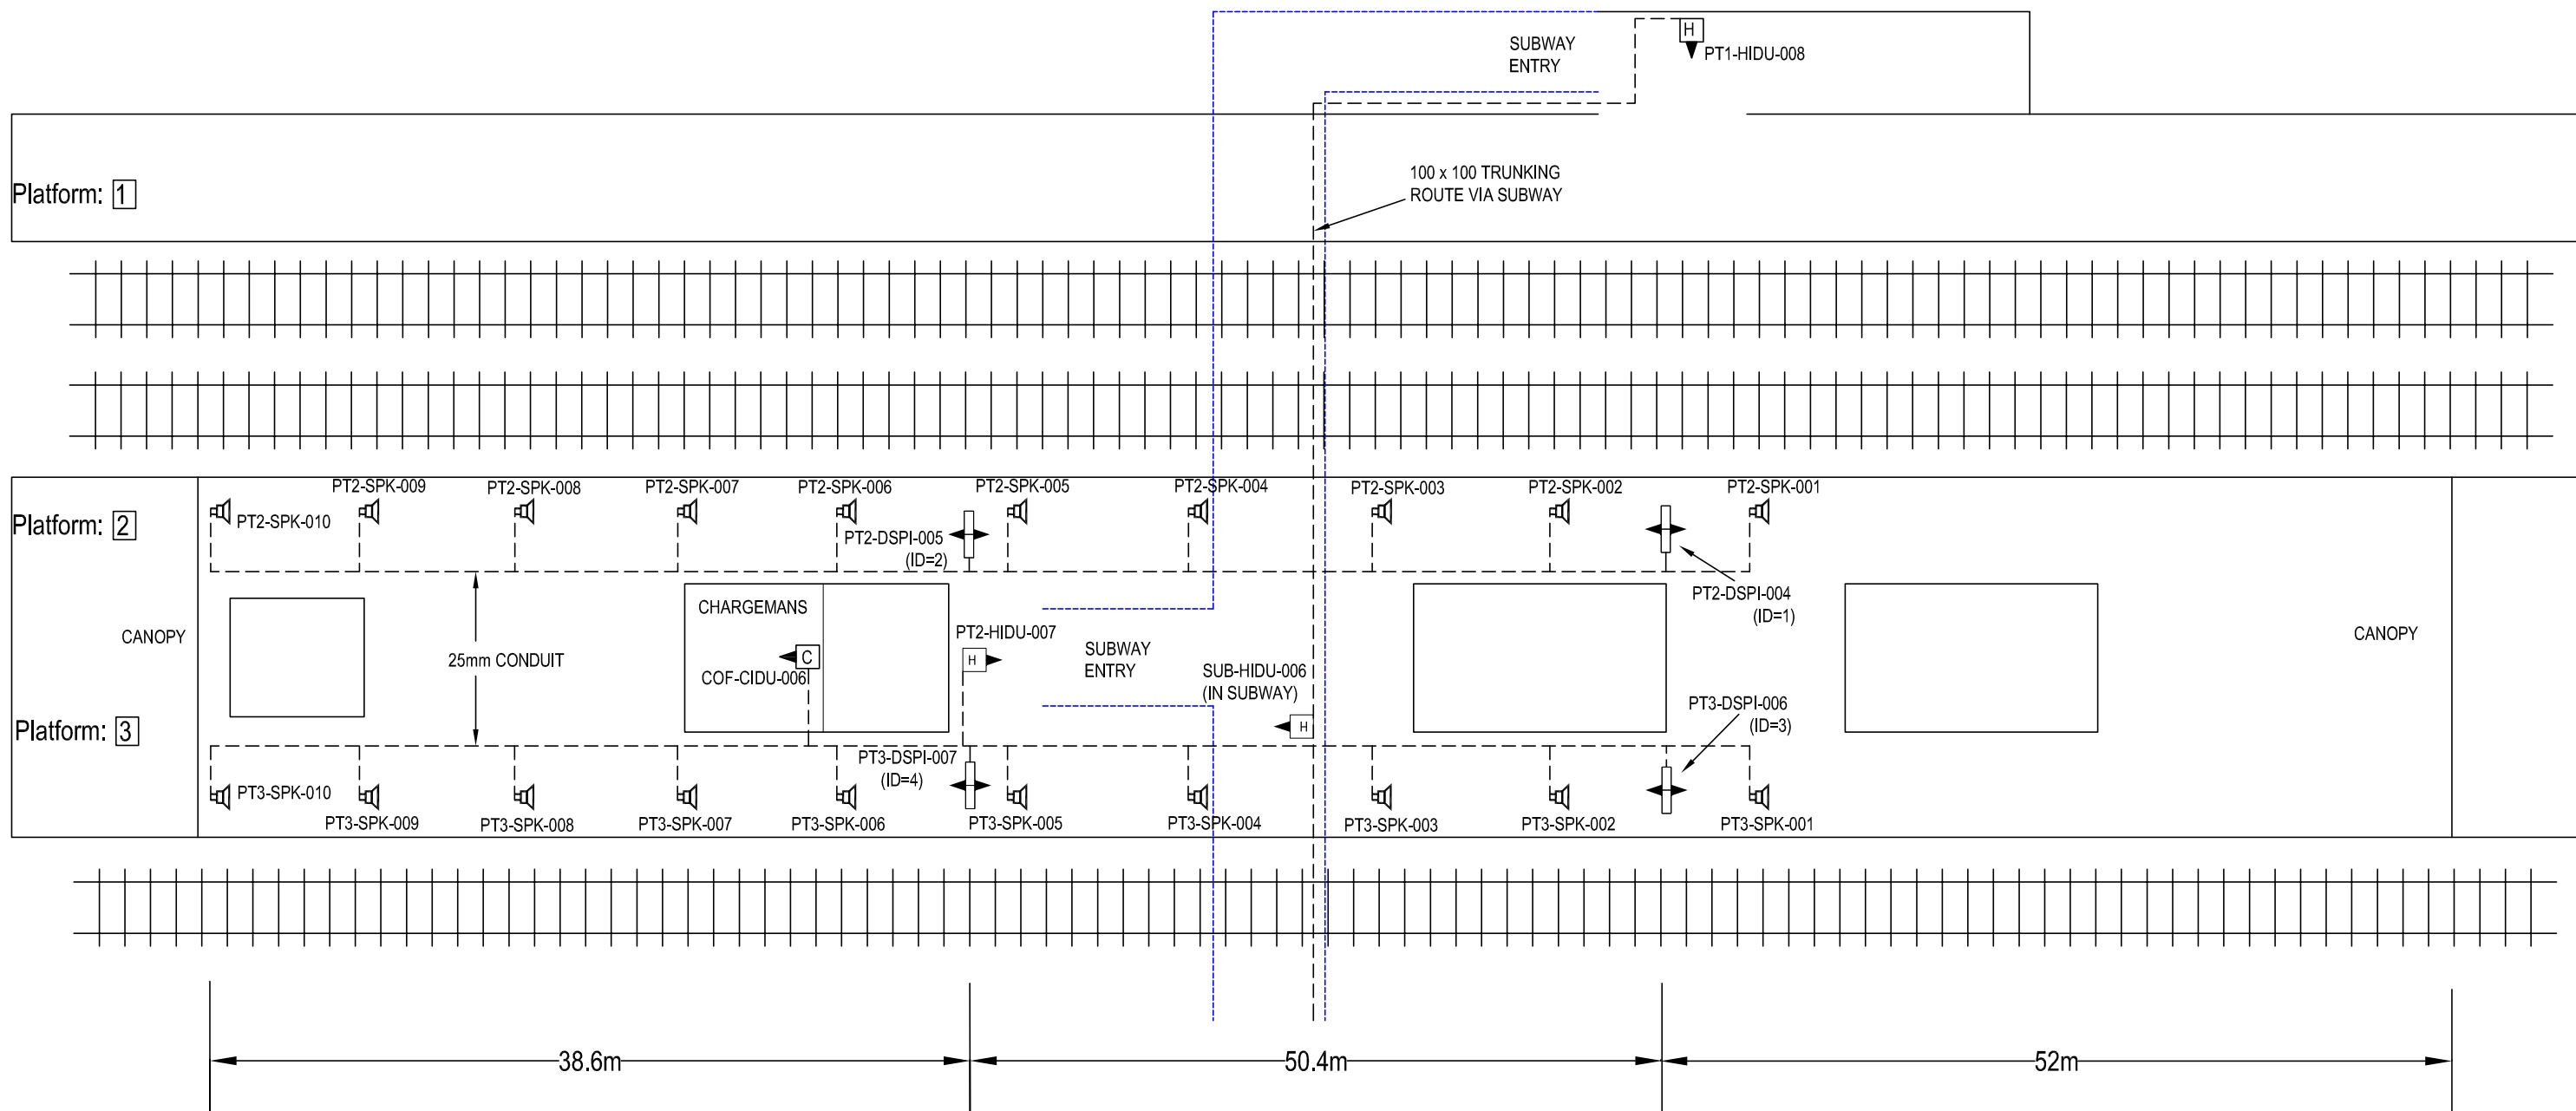

IF IN DOUBT ASK!

MATERIAL	CONSTRUCTION	NAME	SIGNATURE	DATE	 AMEY DATEL Project Offices 1st Floor, Platform 2/3 Eastleigh Station Southampton Road Eastleigh Hants SO50 9FL	SITE/PROJECT			
		DRAWN BY	A HATTON	29-04-2002		SOUTH WEST TRAINS CIS PROJECT			
FINISH	CONSTRUCTION	CHECKED BY	T WONG		COPYRIGHT © AMEY Rail All rights reserved. Neither this drawing or any of the information it contains may be copied or communicated to third parties without the written permission of the copyright holder	TITLE			
		APPD BY	A SMITH			SALISBURY AS BUILT			
		APPD BY				SCALE	DRG No.	ISSUE	SHEET
		CAD Ref:				NTS	SM803-75663	B	2 of 2
		CONTRACTOR'S Ref:							