



WAN	
CIRCUIT ID	KXIP600397
IP ADDRESS	10.227.202.1

"PLATFORM 1 HP ISDN"
02380-676617
"PLATFORM 2 HP ISDN"
02380-676629

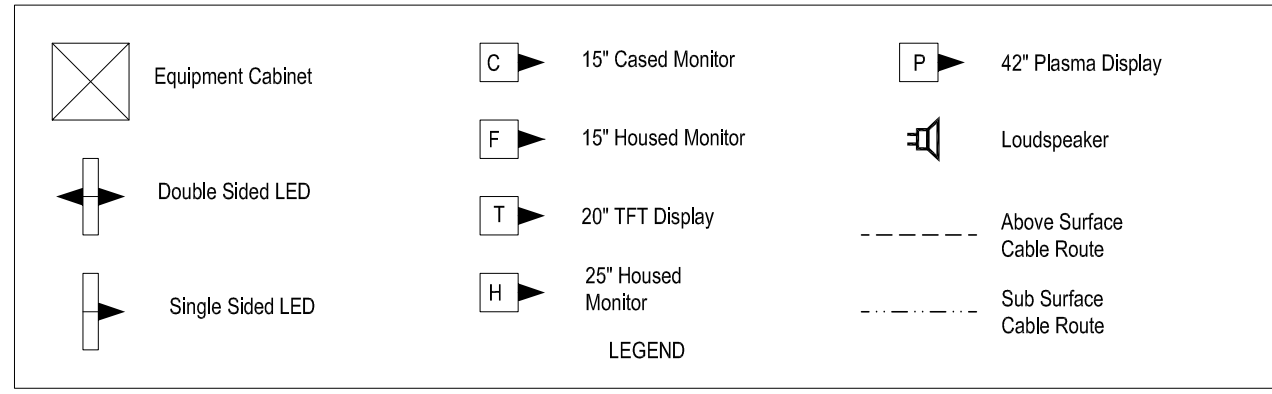

Equipment	Dist Board
CIS RACK	CCT 1
PT4-DSPI-004	CCT 2
EXISTING SPURS USED FOR OTHERS	

All Equipment tags to be prefixed with "SDN-"

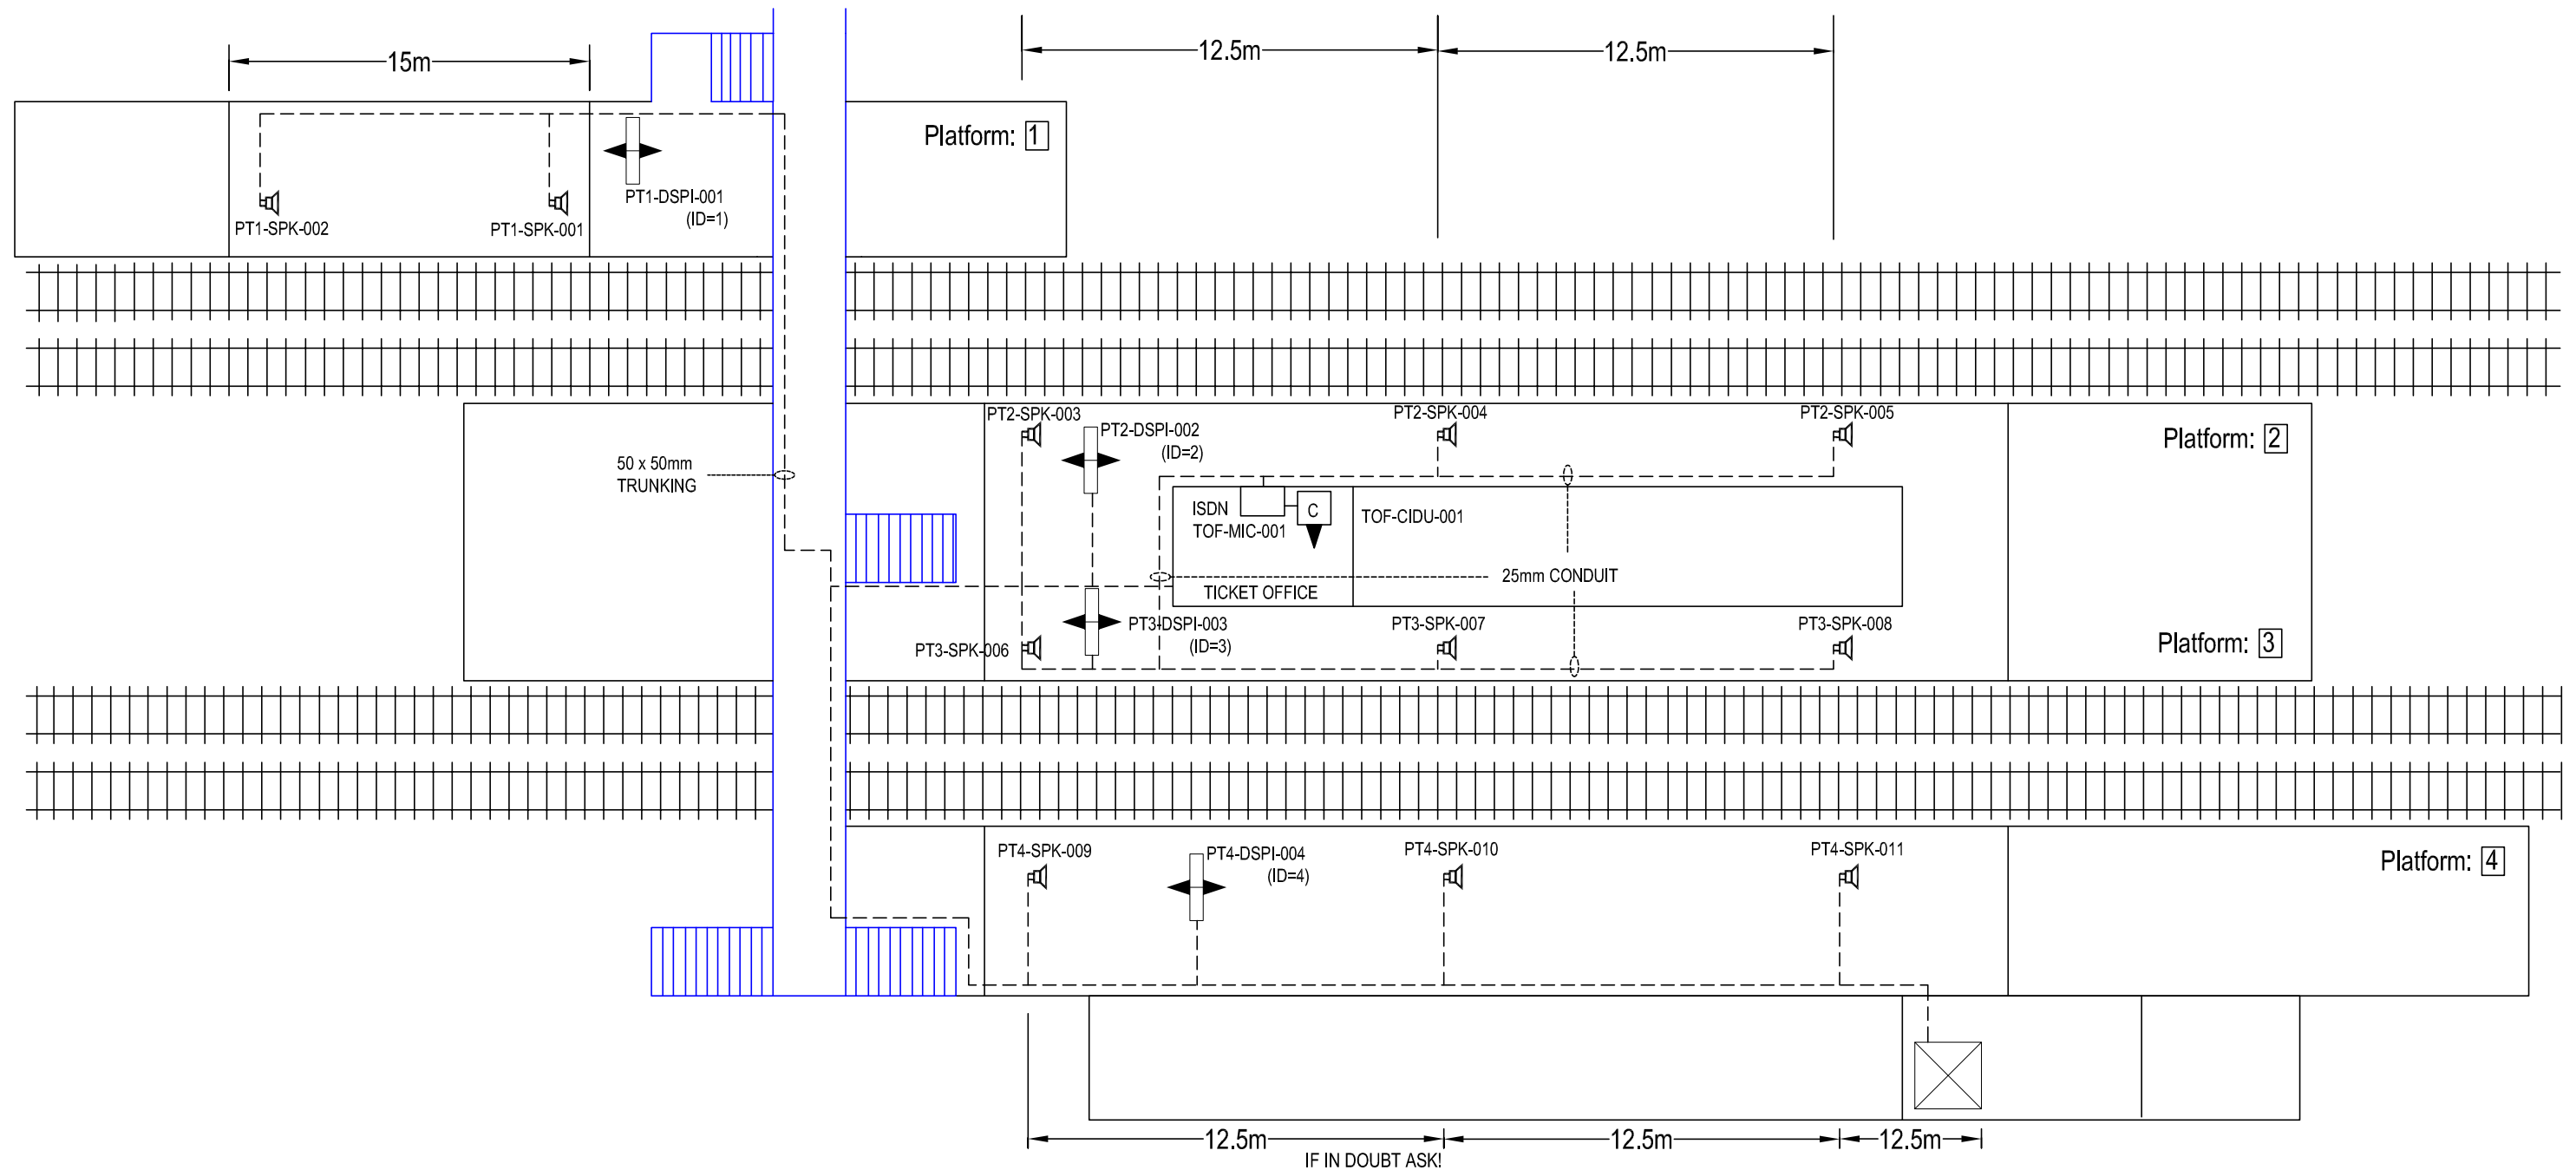

MATERIAL	CONSTRUCTION	DRAWN BY	A HATTON	SIGNATURE		AMEY DATEL Project Offices 1st Floor, Platform 2/3 Eastleigh Station Southampton Road Eastleigh Hants SO50 9FL	SITE/PROJECT		SOUTH WEST TRAINS CIS PROJECT	
		CHECKED BY	T WONG	DATE	30-04-2002		TITLE		ST DENYS AS BUILT	
FINISH		APPD BY	A SMITH				SCALE	DRG No.	ISSUE	SHEET
		CAD Ref:					NTS	SM803-75914	B	1 of 1
		CONTRACTOR'S Ref:				COPYRIGHT © AMEY Rail All rights reserved. Neither this drawing or any of the information it contains may be copied or communicated to third parties without the written permission of the copyright holder				