



FORM 1 HP ISDN"
935-814163
FORM 2 HP ISDN"
935-814168

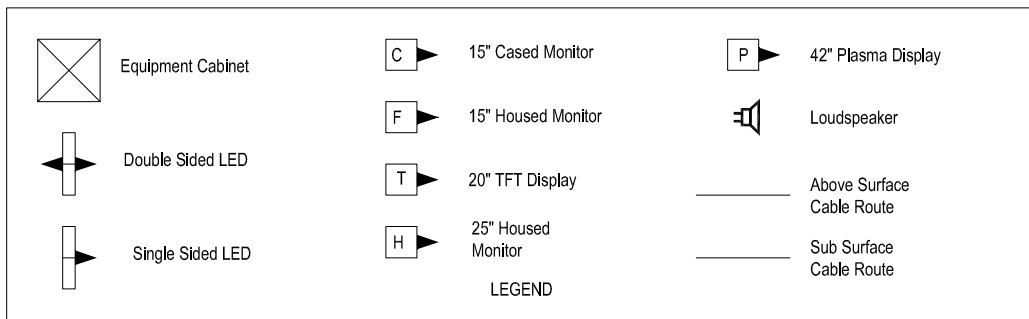

Equipment	Dist Board	
CIS RACK	CCT NO. 1	
HEATER	CCT NO. 2	
13 AMP TWIN SKT	CCT NO. 3	
LIGHT	CCT NO. 4	
STAT + FAN	CCT NO. 5	
SPARE	CCT NO. 6/7/8 & 9	

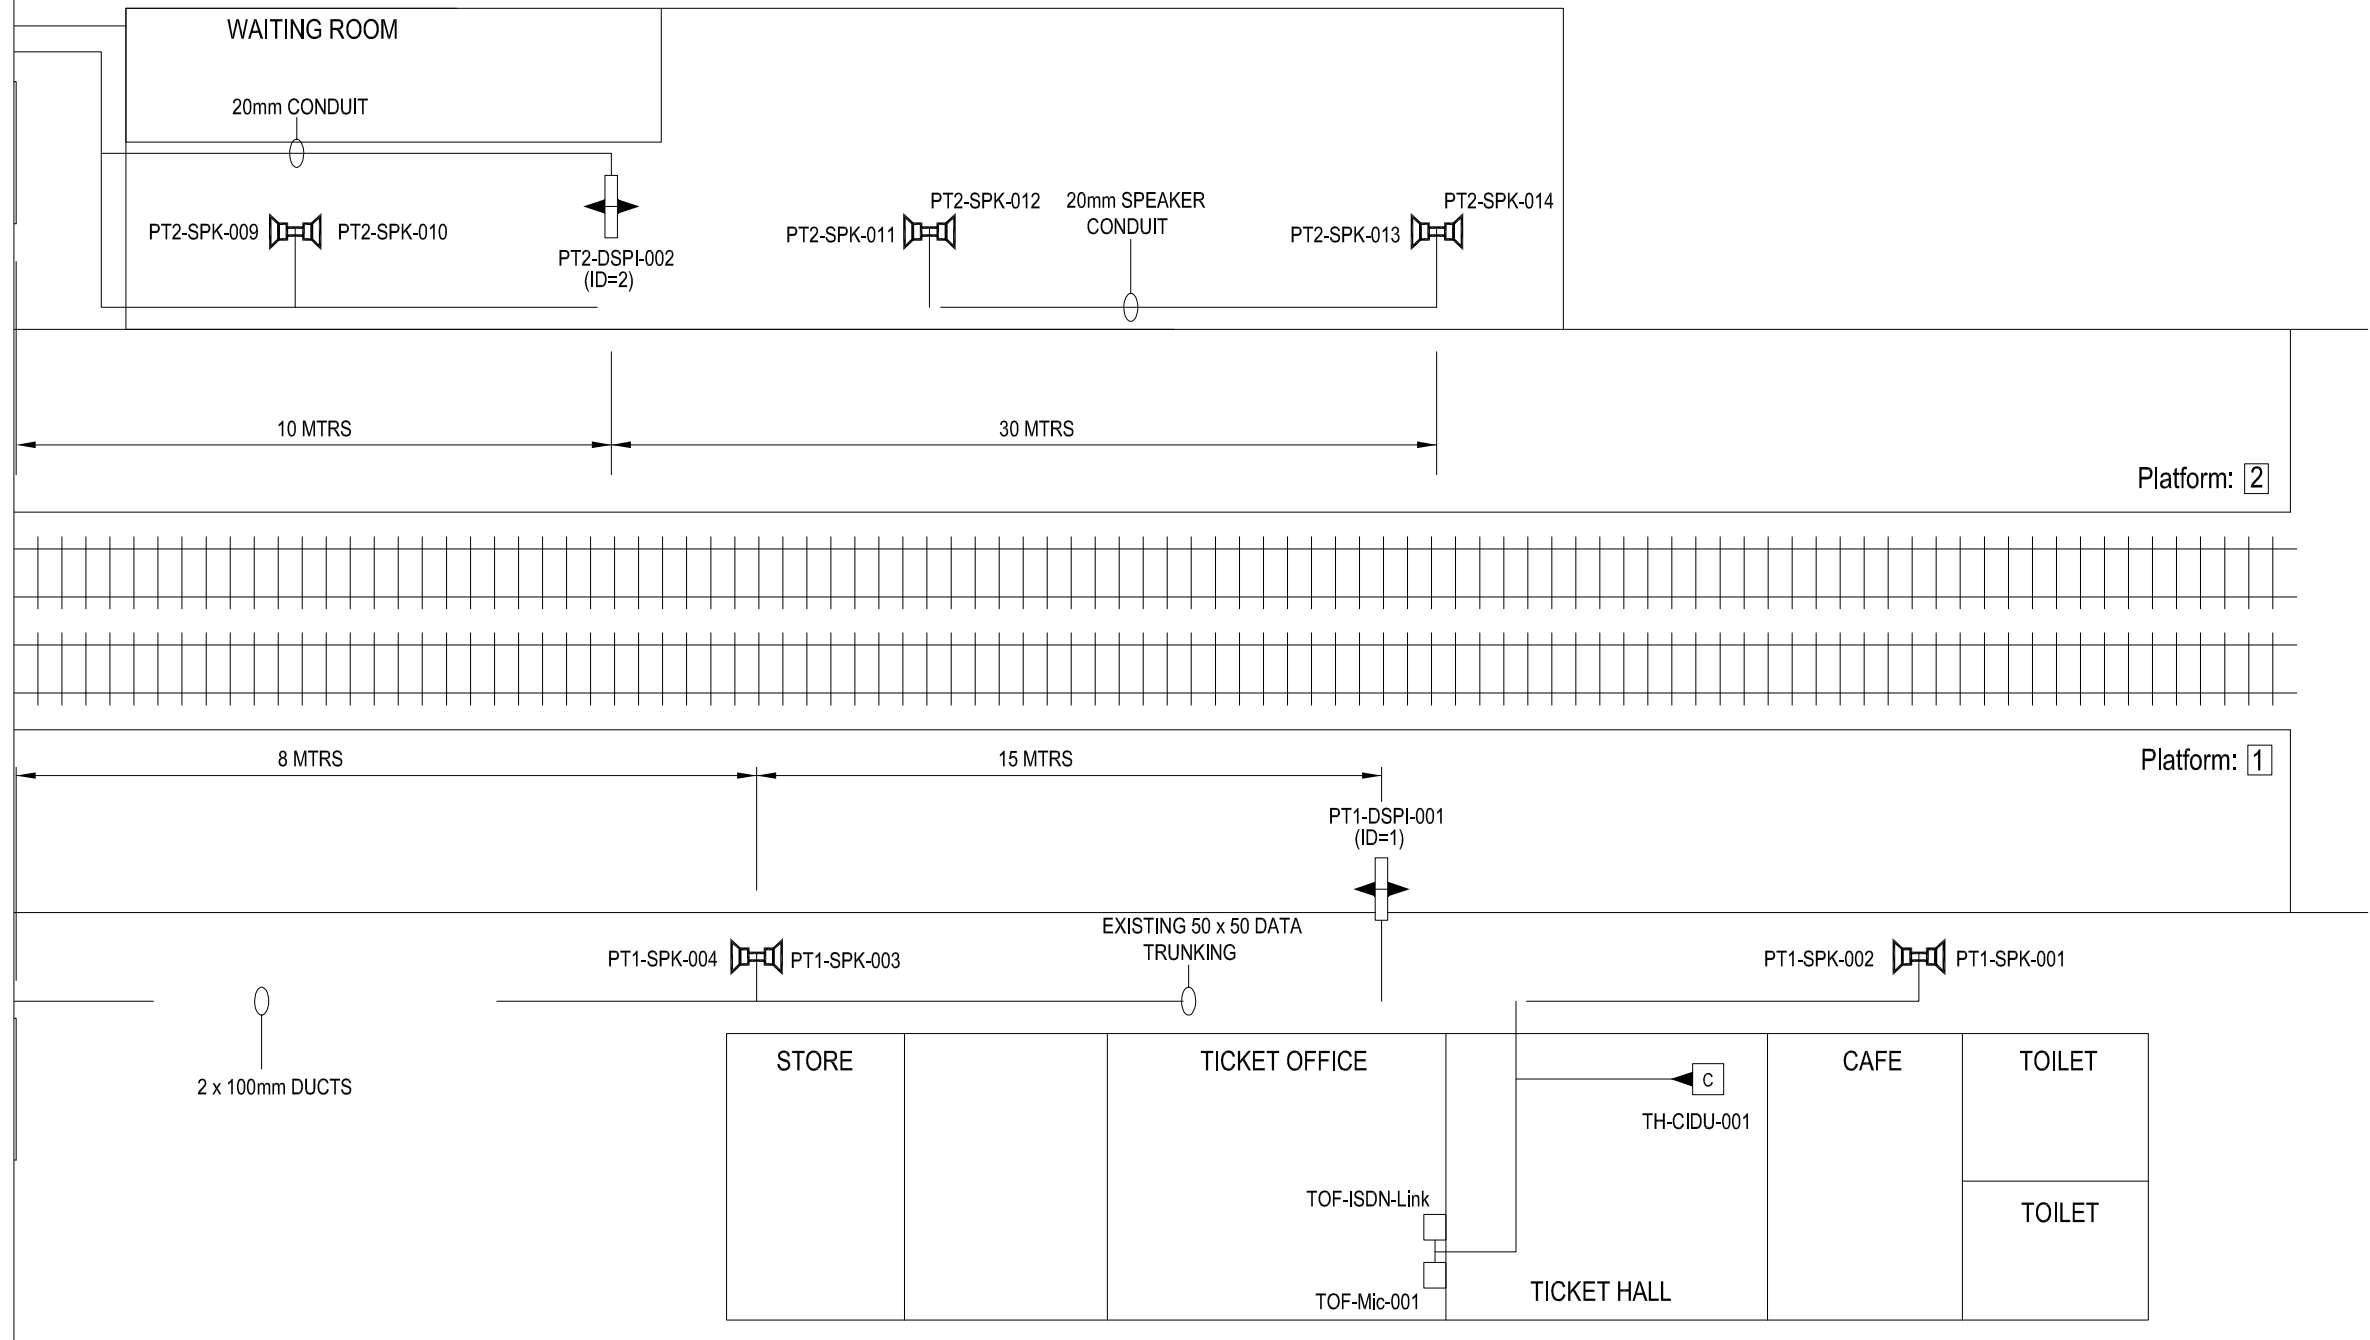

IF IN DOUBT ASK!

NAME	SIGNATURE	DATE
DRAWN BY D GADDU		15-03-2002
CHECKED BY T WONG		
APPD BY		
APPD BY		
CAD Ref:		
CONTRACTOR'S Ref:		



AMEY DATEL Project
Offices
1st Floor, Platform
2/3
Eastleigh Station
Southampton Road
Eastleigh
Hants
SO50 9FL

COPYRIGHT © AMEY Rail
All rights reserved. Neither this drawing or any of the information it contains may be copied or communicated to third parties without the written permission of the copyright holder

SITE/PROJECT SOUTH WEST TRAINS CIS PROJECT		TITLE SHERBORNE AS BUILT	
SCALE NTS	DRG No. SM803-75835	ISSUE B	SHEET 1 of 1