



WAN	
CIRCUIT ID	KXIP 600390
IP ADDRESS	10.227.197.1

"PLATFORM 1 HP ISDN"
01962-711737
"PLATFORM 2 HP ISDN"
01962-711738

All Equipment tags to be prefixed with "SHW-"

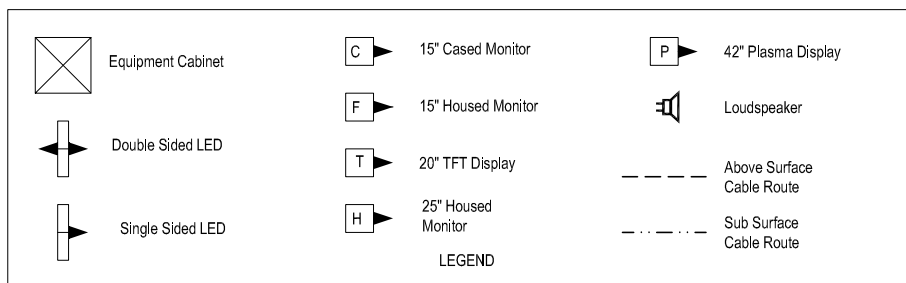


Equipment	Dist Board
LIGHTING	BREAKER NO.1
CIS	BREAKER NO.2
LED	BREAKER NO.3

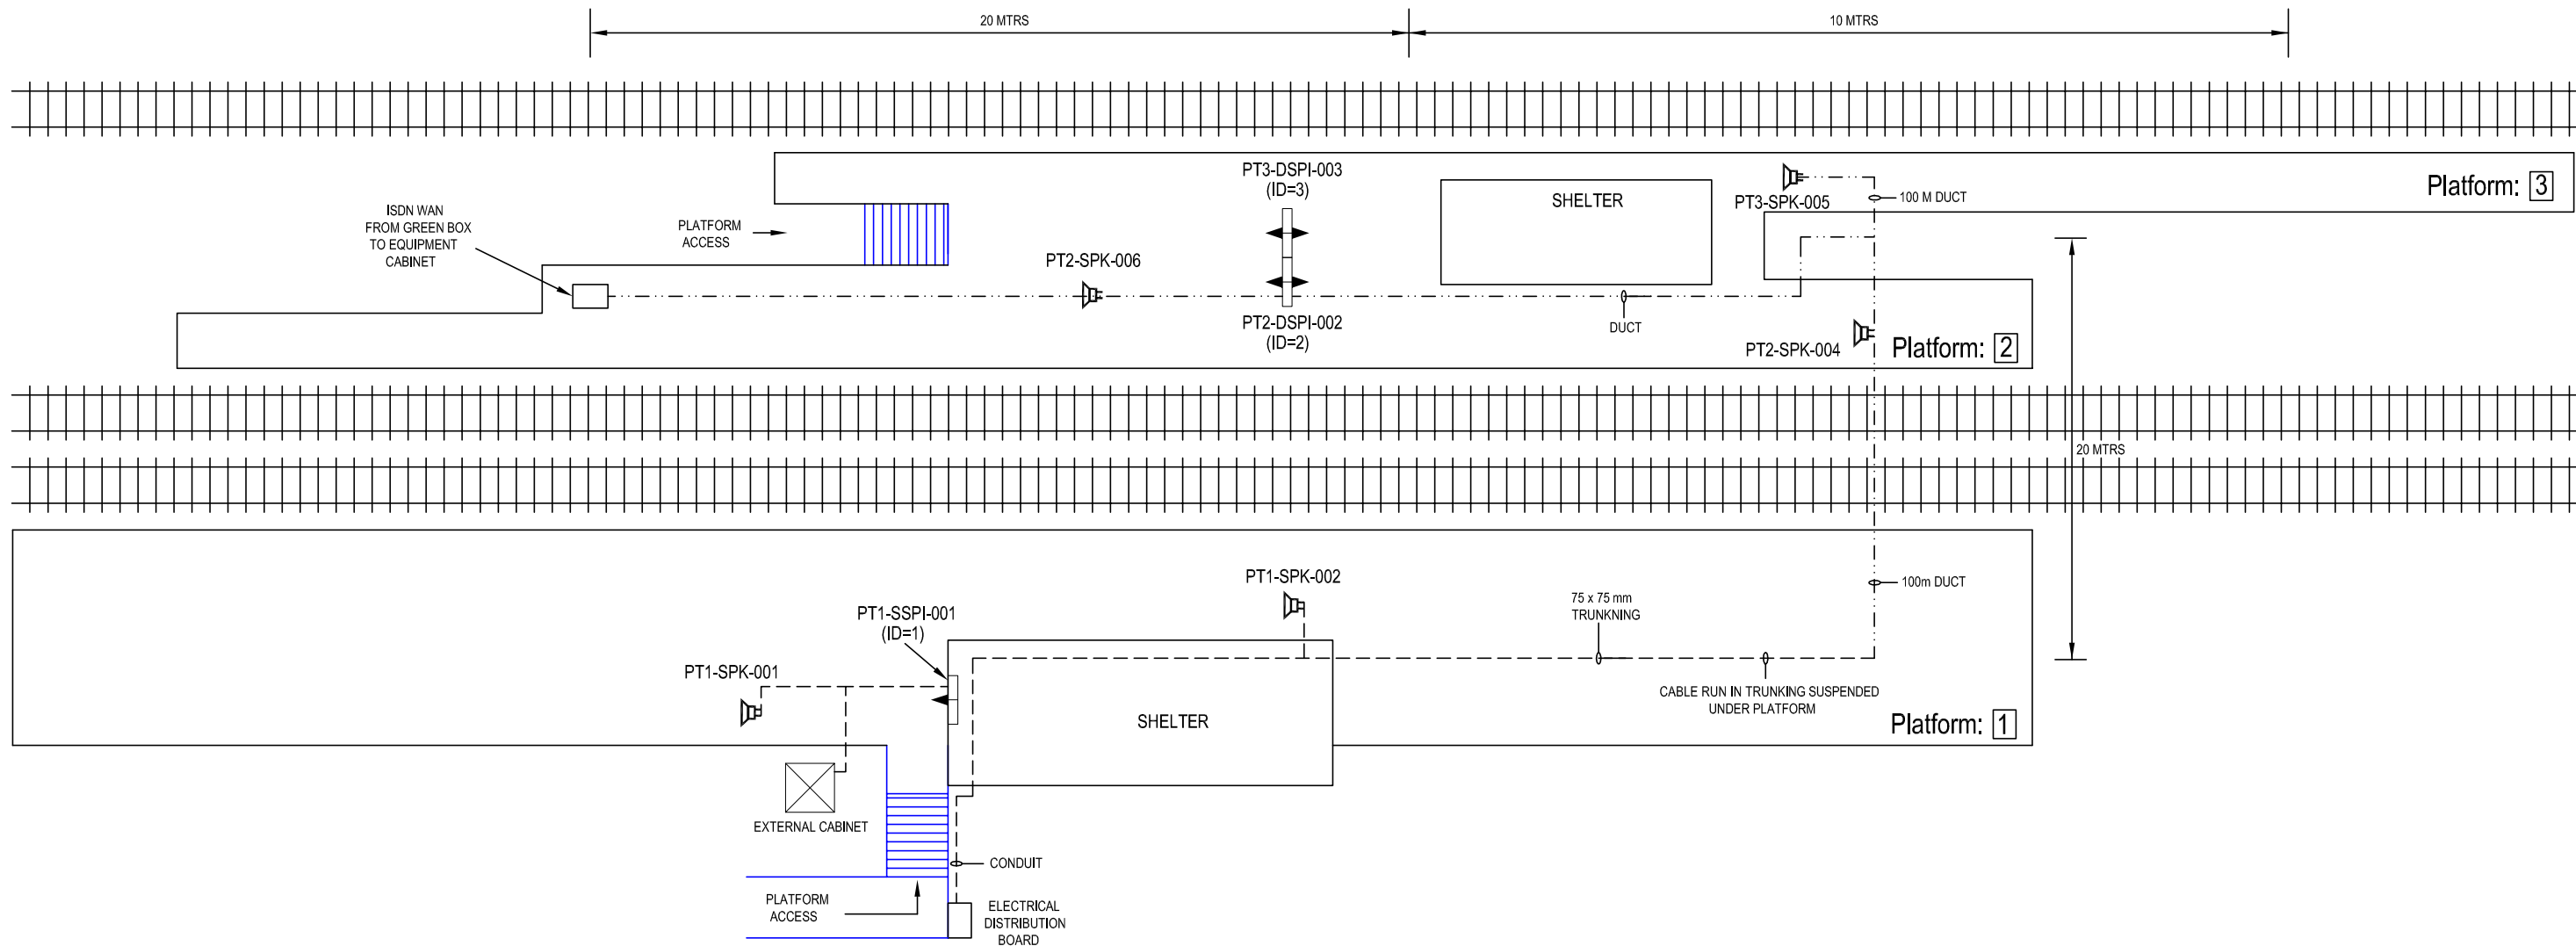

IF IN DOUBT ASK!

MATERIAL	CONSTRUCTION
FINISH	

	NAME	SIGNATURE	DATE
DRAWN BY	D GADDU		10-05-2002
CHECKED BY	T WONG		
APPD BY	A SMITH		
APPD BY			
CAD Ref:			
CONTRACTOR'S Ref:			



AMEY DATEL Project Offices  
1st Floor, Platform 2/3  
Eastleigh Station  
Southampton Road  
Eastleigh  
Hants  
SO50 9FL

COPYRIGHT © AMEY Rail  
All rights reserved. Neither this drawing or any of the information it contains may be copied or communicated to third parties without the written permission of the copyright holder

SITE/PROJECT		SOUTH WEST TRAINS CIS PROJECT	
TITLE		SHAWFORD AS BUILT	
SCALE	DRG No.	ISSUE	SHEET
NTS	SM803-75929	B	1 of 1