

WAN	
CIRCUIT ID	KXIP600395
IP ADDRESS	10.227.203.1


"PLATFORM 1 HP ISDN"
020-8744-9146
"PLATFORM 2 HP ISDN"
020-8744-9698

All Equipment tags to be prefixed with "SMG-"

**LEGEND**

	Equipment Cabinet		15" Cased Monitor		42" Plasma Display
	Double Sided LED		15" Housed Monitor		Loudspeaker
	Single Sided LED		20" TFT Display		Above Surface Cable Route
			25" Housed Monitor		Sub Surface Cable Route

Equipment	Dist Board
CIS RACK	NEW BOARD
PT1-DSPI-001	C50 BOARD
PT2-DSPI-002	GP1 CCT 5
PT3-DSPI-003	GP1 CCT6
TH-HIDU-001	EXISTING

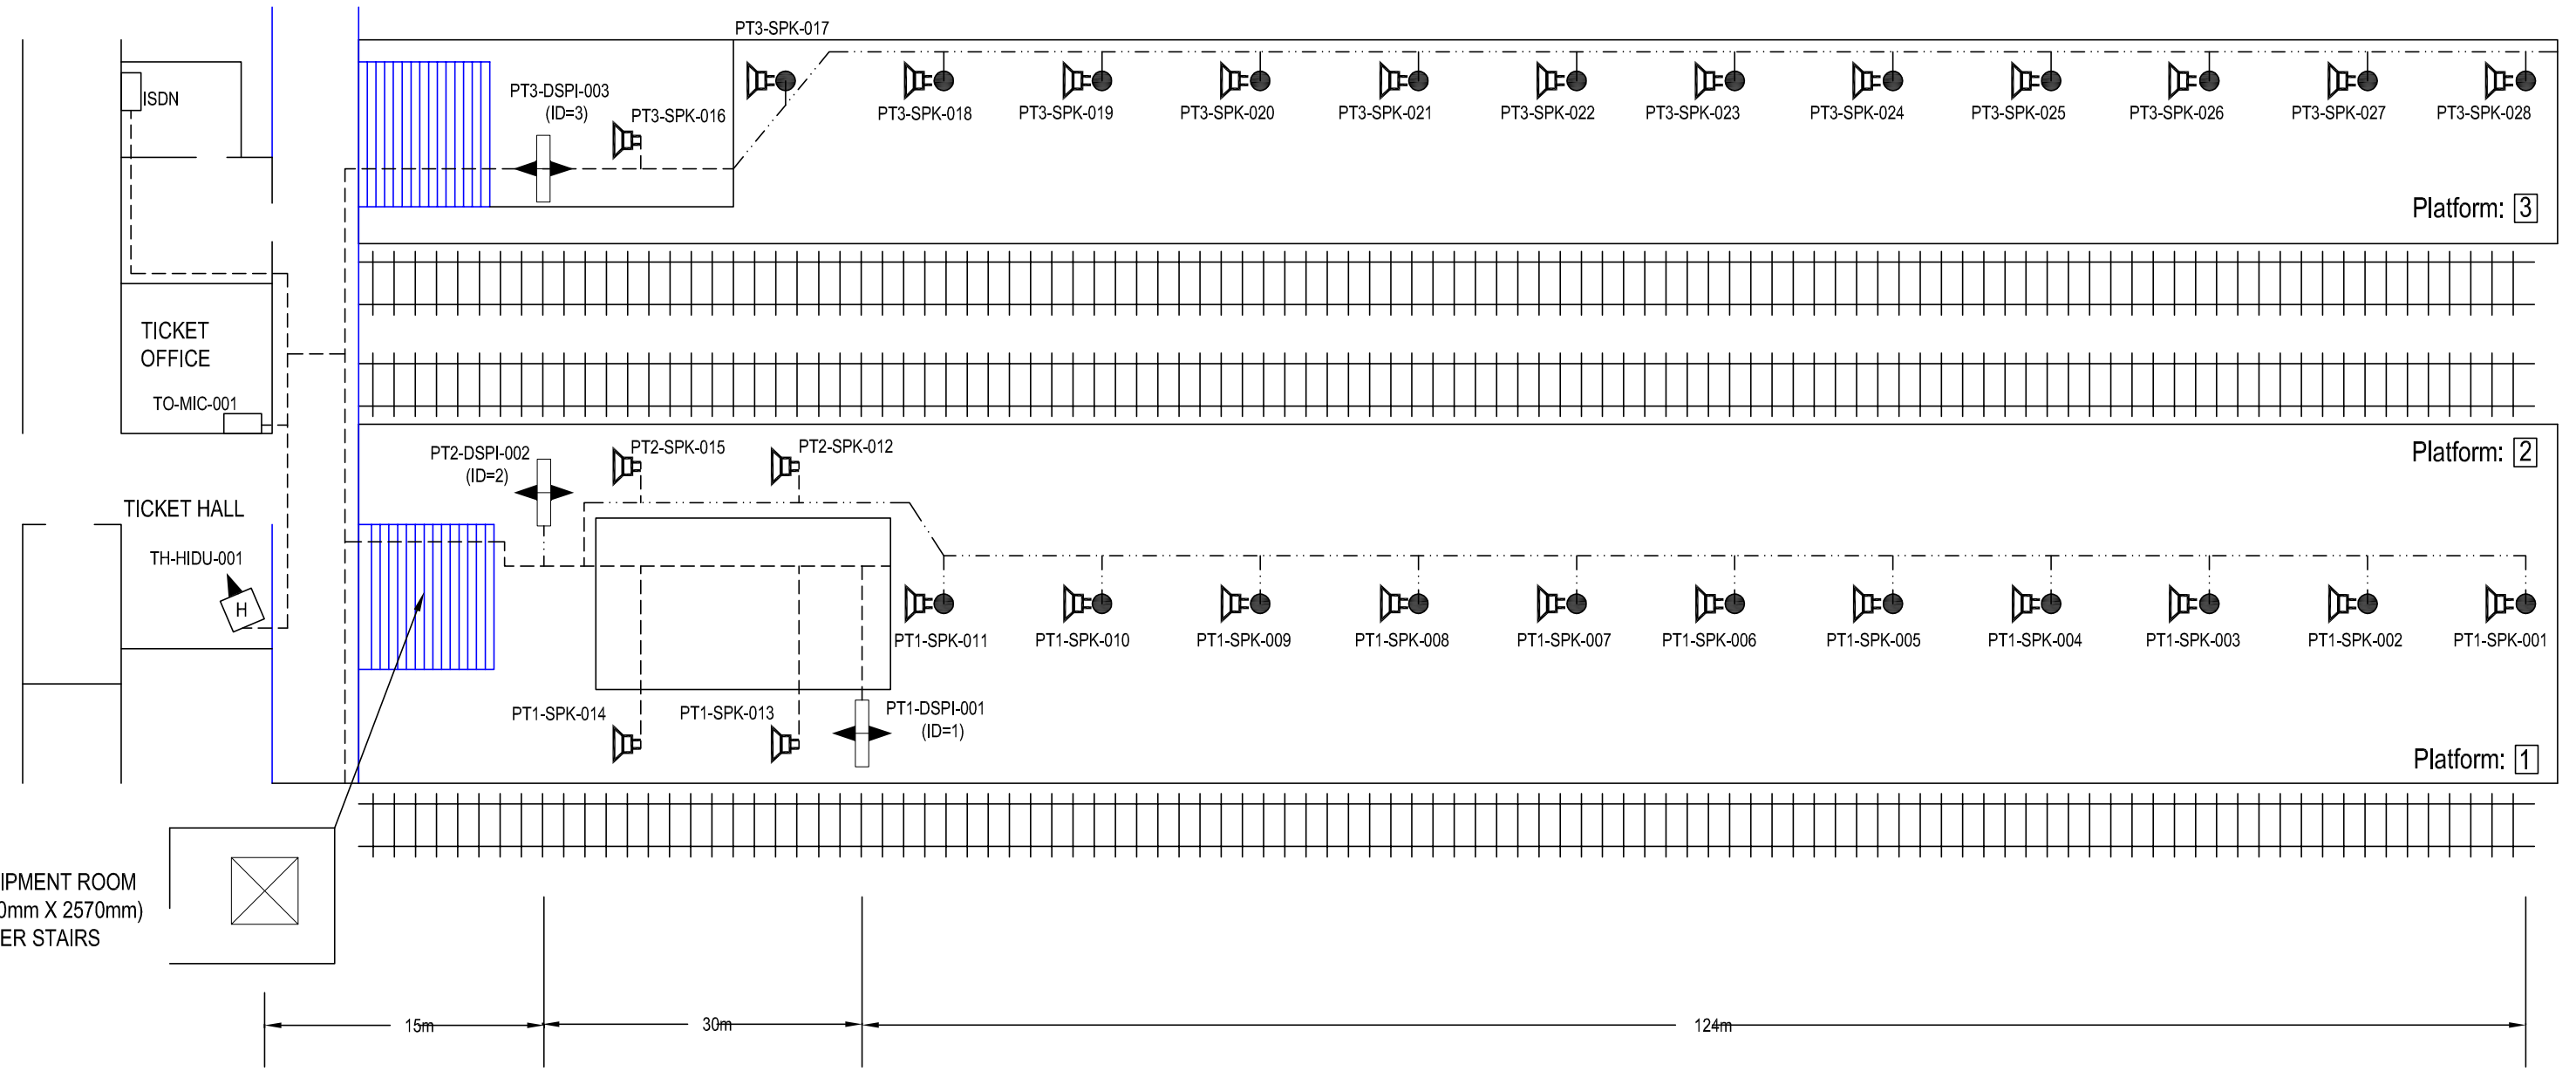

IF IN DOUBT ASK!

MATERIAL	CONSTRUCTION	DRAWN BY	A HATTON	SIGNATURE		AMEY DATEL Project Offices 1st Floor, Platform 2/3 Eastleigh Station Southampton Road Eastleigh Hants SO50 9FL	SITE/PROJECT		SOUTH WEST TRAINS CIS PROJECT	
		CHECKED BY	T WONG	DATE	20-08-2002		TITLE	ST MARGARETS AS BUILT		
FINISH		APPD BY	A SMITH				SCALE	DRG No.	ISSUE	SHEET
		CAD Ref:					NTS	SM803-75604	B	1 of 1
							COPYRIGHT © AMEY Rail PT1-SPK-006 All rights reserved. Neither this drawing or any of the information it contains may be copied or communicated to third parties without the written permission of the copyright holder			
CONTRACTOR'S Ref:										