



WAN	
CIRCUIT ID	KXIP600398
IP ADDRESS	10.227.204.1

"PLATFORM 1 HP ISDN"
01-590-681824
"PLATFORM 2 HP ISDN"
01-590-681851

All Equipment tags to be prefixed with "SNL-"

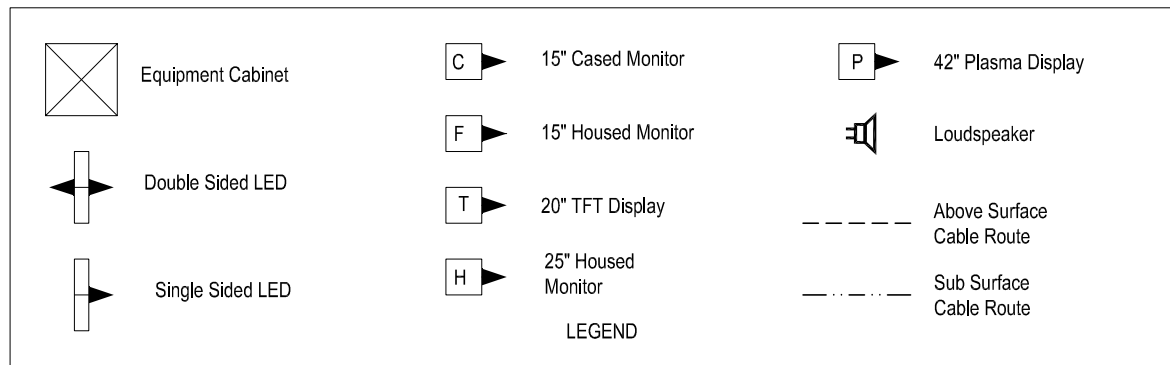

Equipment	Dist Board
CIS RACK	GP3 CCT3
PT1-DSPI-001	GP3 CCT 3
PT2-DSPI-002	GP3 CCT 3
TH-FIDU-002	GP1 CCT 6
TOF-CIDU-001	GP1 CCT 6

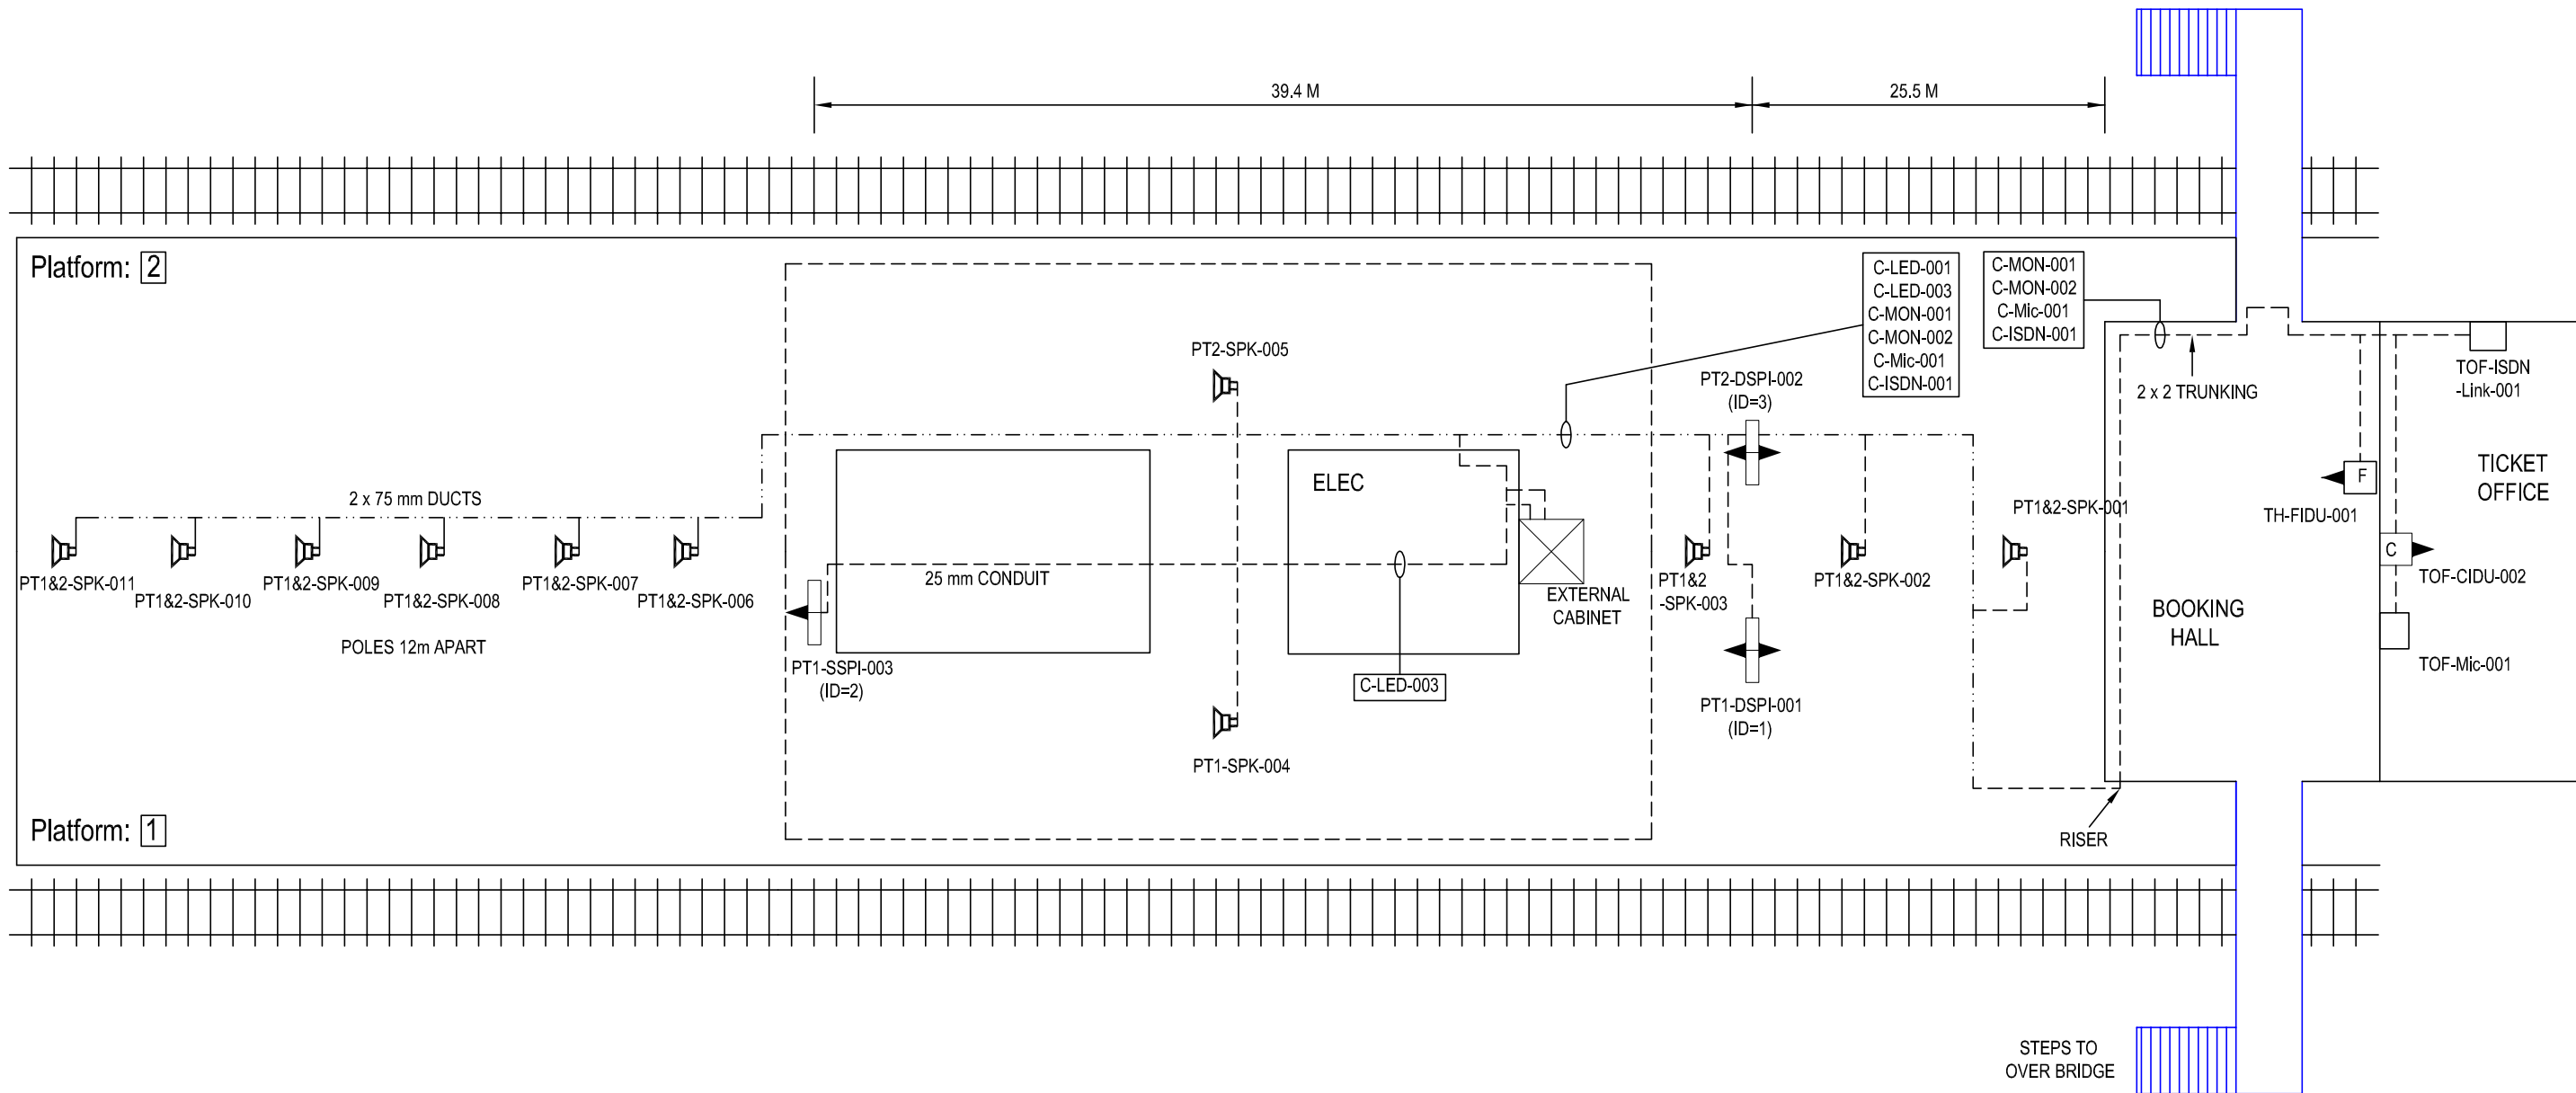

IF IN DOUBT ASK!

MATERIAL	CONSTRUCTION
FINISH	

NAME	SIGNATURE	DATE
D GADDU		22-05-2002
T WONG		
A SMITH		
CAD Ref:		
CONTRACTOR'S Ref:		



AMEY DATEL Project Offices  
1st Floor, Platform 2/3  
Eastleigh Station  
Southampton Road  
Eastleigh  
Hants  
SO50 9FL

COPYRIGHT © AMEY Rail  
All rights reserved. Neither this drawing or any of the information it contains may be copied or communicated to third parties without the written permission of the copyright holder

SITE/PROJECT		SOUTH WEST TRAINS CIS PROJECT	
TITLE		STONELEIGH AS BUILT	
SCALE	DRG No.	ISSUE	SHEET
NTS	SM803-75606	B	1 of 1