


DRG No. SM803-75920



"PLATFORM 1 HP ISDN"
01-489-564067
"PLATFORM 2 HP ISDN"
01-489-564068

WAN	
CIRCUIT ID	KXIP 600404
IP ADDRESS	10.227.208.1

All Equipment tags to be prefixed with "SNW-"

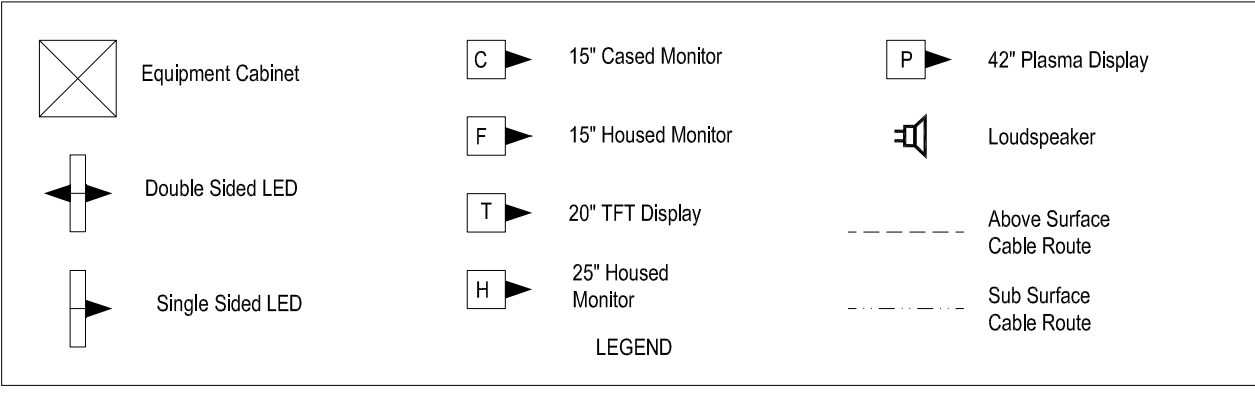

Equipment	Dist Board
CIS RACK	CCT NO. 1
13 AMP TWIN	CCT NO. 2
HEATER	CCT NO. 3
FAN + STAT	CCT NO.4
LIGHT	CCT NO. 5
LED PT1	CCT NO. 6
LED PT2	CCT NO. 7

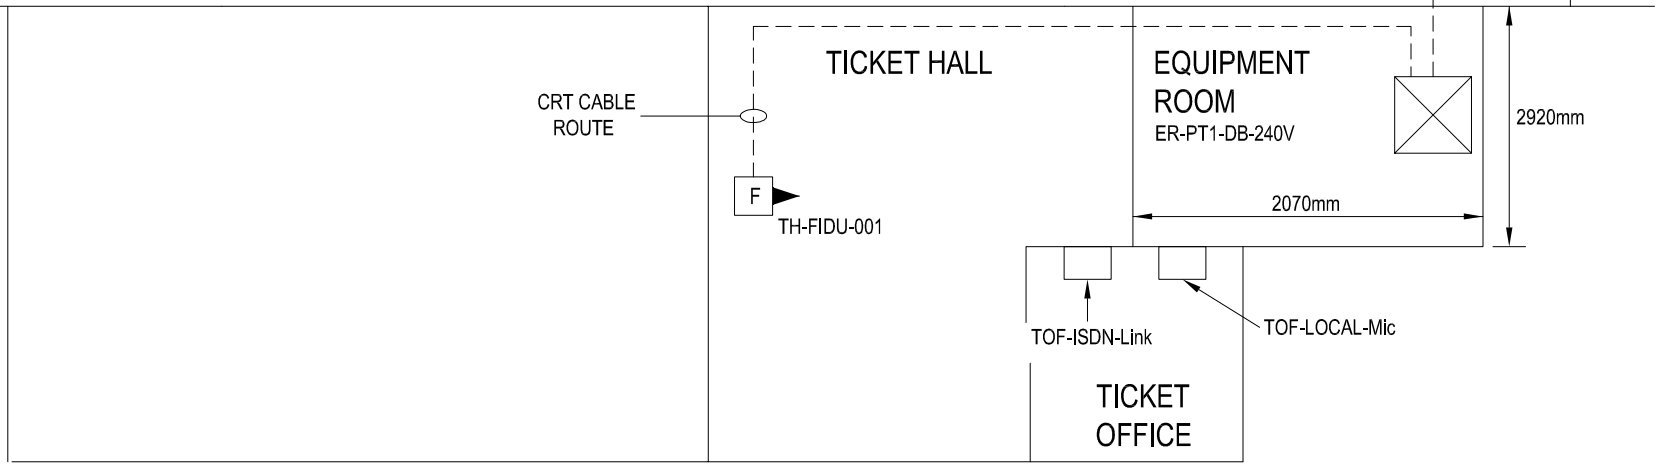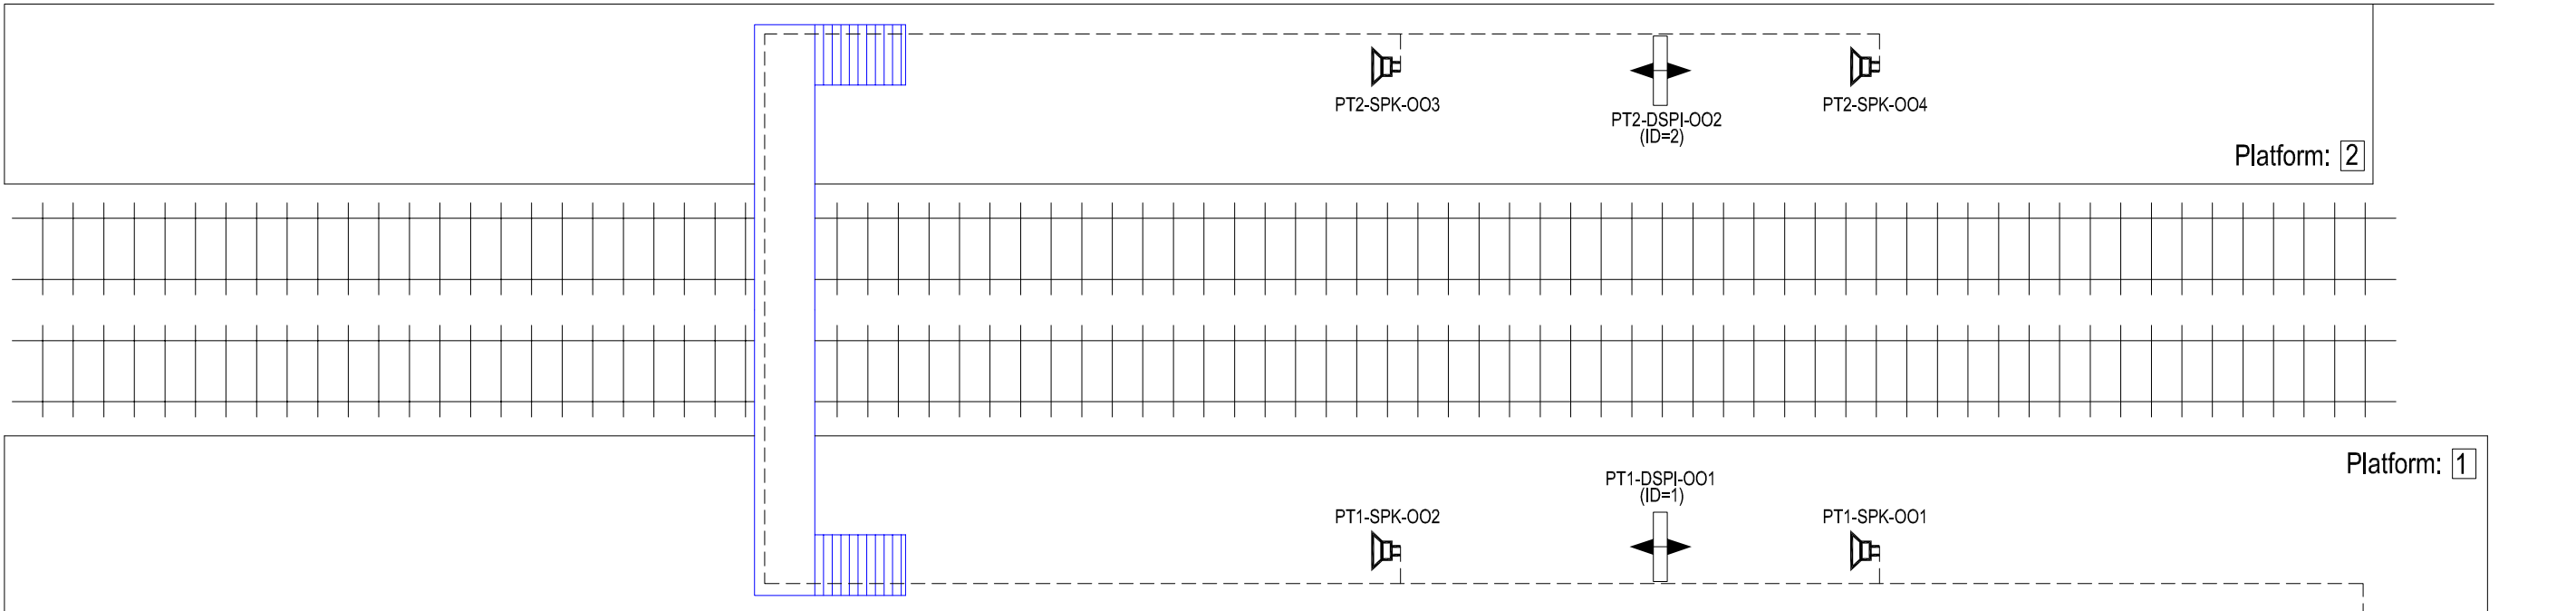

IF IN DOUBT ASK!

MATERIAL	CONSTRUCTION
FINISH	

	NAME	SIGNATURE	DATE
DRAWN BY	D GADDU		19-03-2002
CHECKED BY	T WONG		
APPD BY	A SMITH		
APPD BY			
CAD Ref:			
CONTRACTOR'S Ref:			

AMEY DATEL Project  
Offices  
1st Floor, Platform  
2/3  
Eastleigh Station  
Southampton Road  
Eastleigh  
Hants  
SO50 9FL

COPYRIGHT © AMEY Rail  
All rights reserved. Neither this drawing or any of the information it contains may be copied or communicated to third parties without the written permission of the copyright holder

SITE/PROJECT		SOUTH WEST TRAINS CIS PROJECT	
TITLE		SWANWICK AS BUILT	
SCALE	DRG No.	ISSUE	SHEET
NTS	SM803-75920	B	1 of 1