



WAN	
CIRCUIT ID	KXIP600402
IP ADDRESS	10.227.207.1

"PLATFORM 1 HP ISDN"
01-784-488034

All Equipment tags to be prefixed with "SNY-"

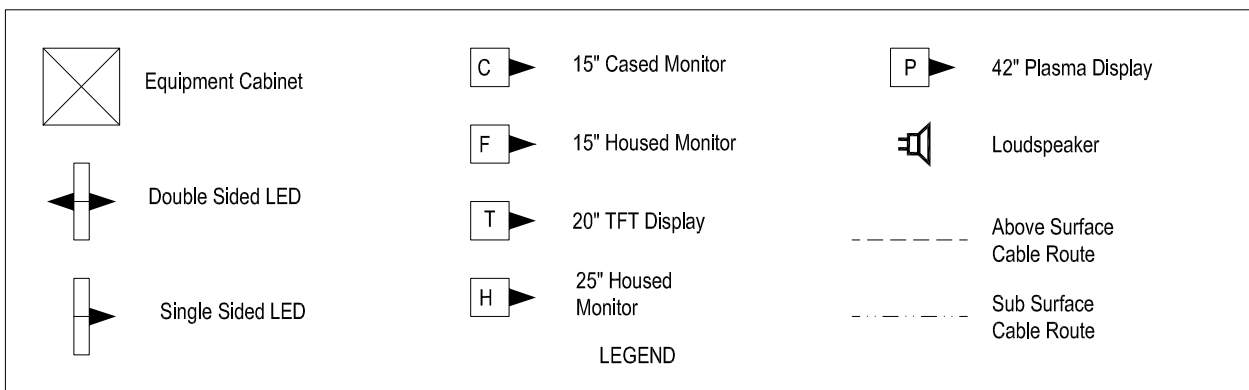

Equipment	Dist Board	
CIS RACK	OLD T.O.	CCT 3
PT1-DSPI-001	CIS RACK	
PT1-DSPI-002	CIS RACK	

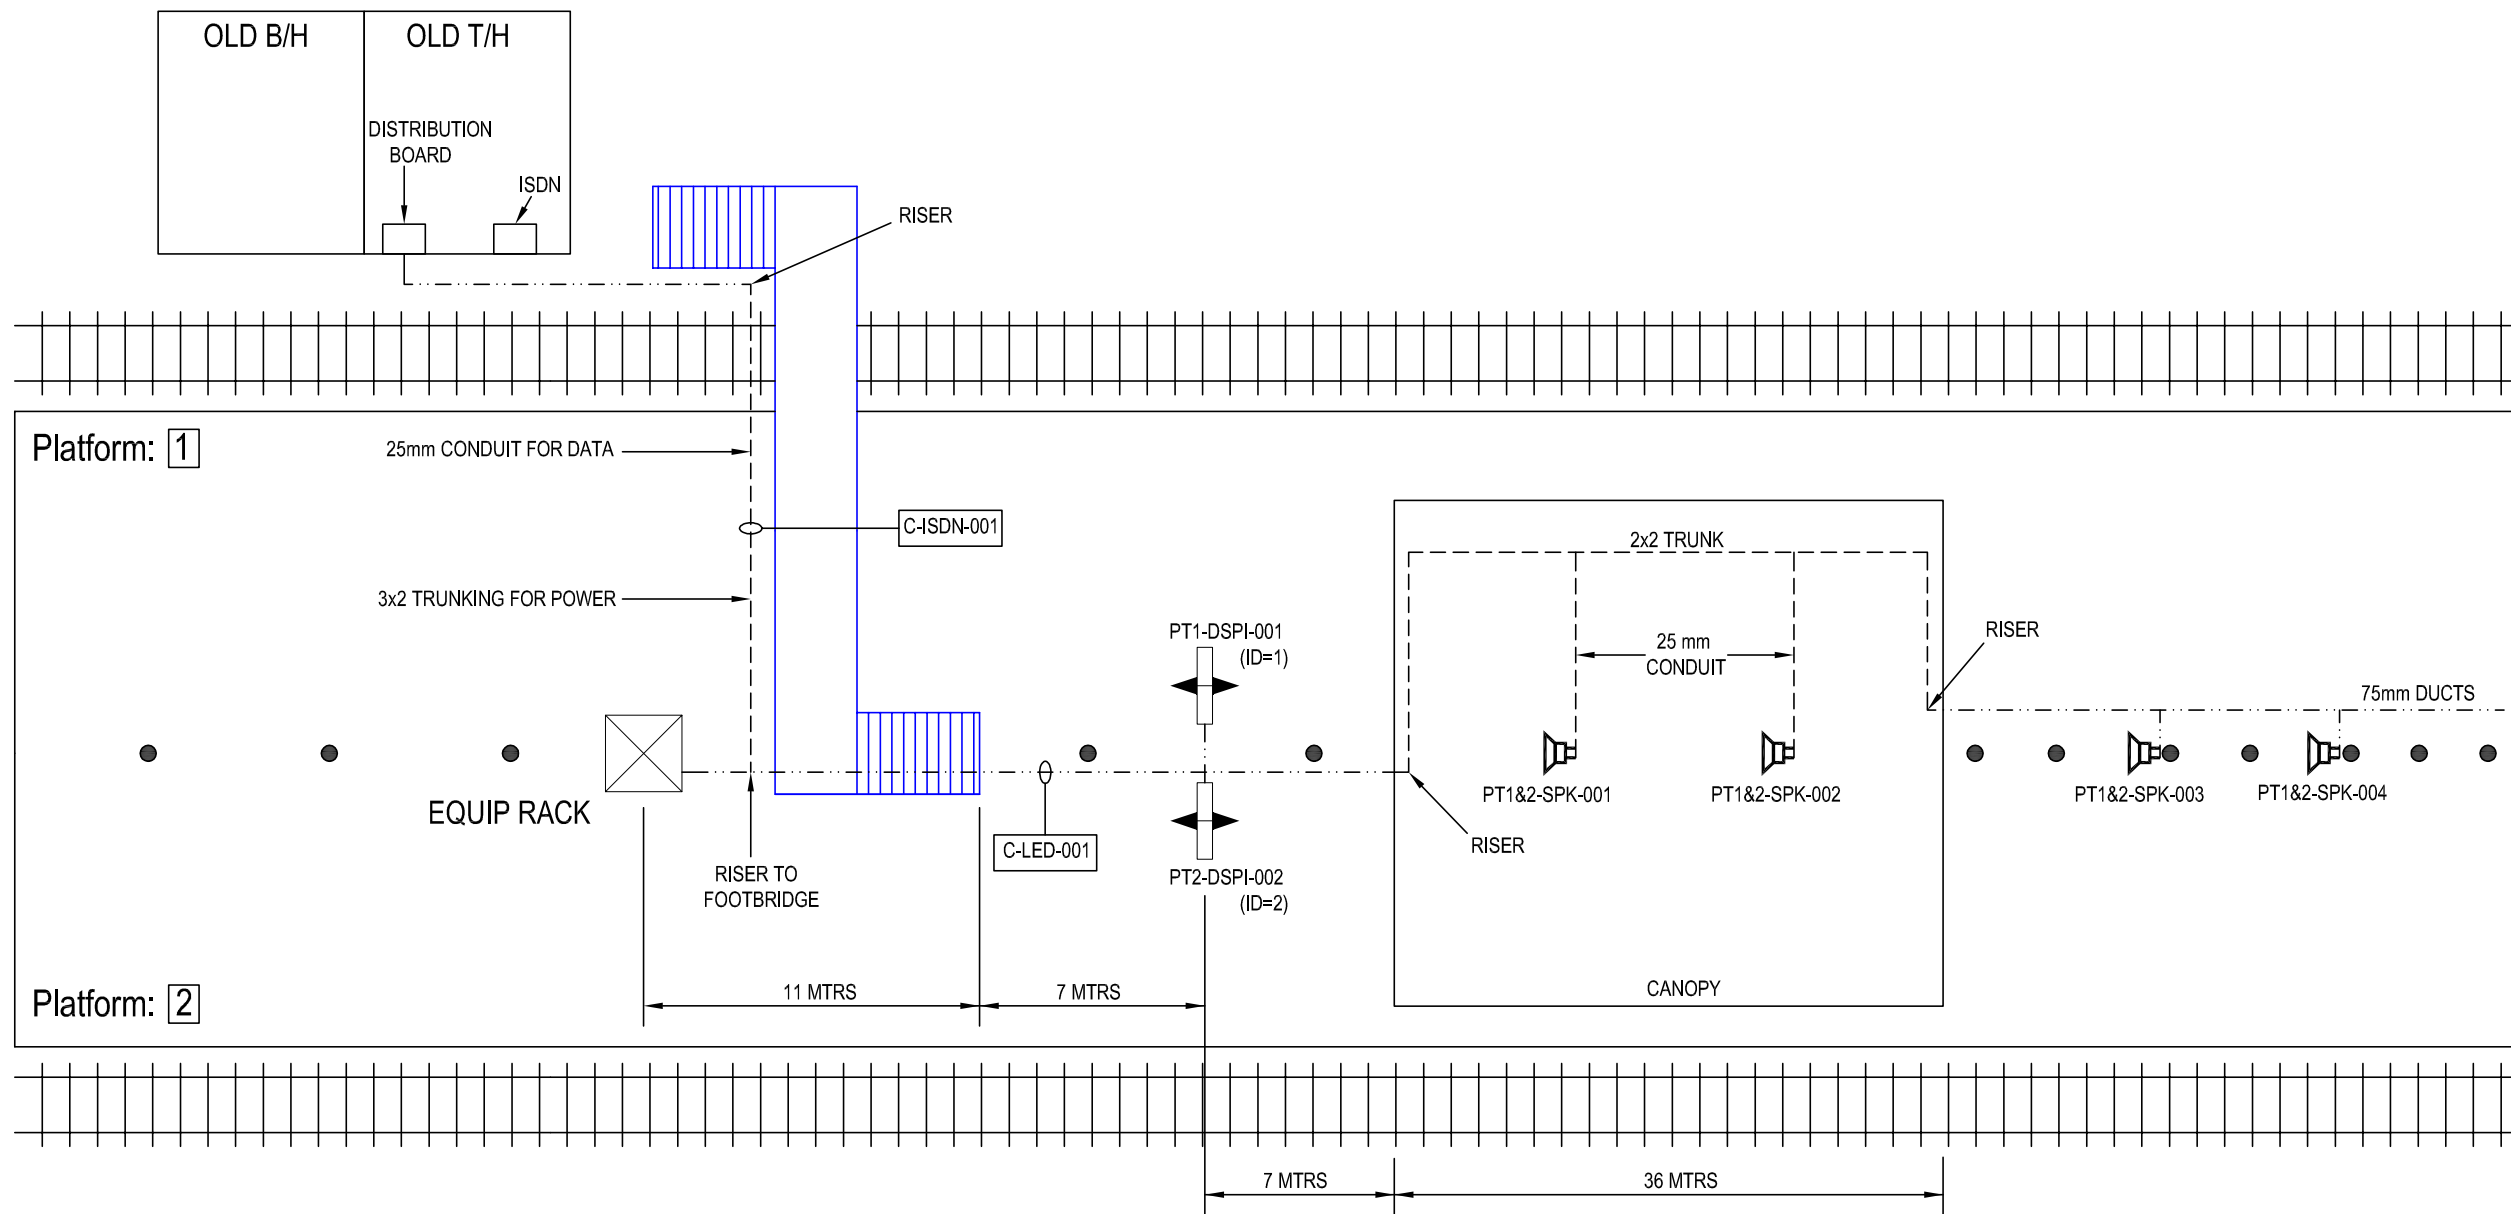

IF IN DOUBT ASK!

MATERIAL	CONSTRUCTION
FINISH	

NAME	SIGNATURE	DATE
D GADDU		11-02-2002
T WONG		
A SMITH		
CAD Ref:		
CONTRACTOR'S Ref:		

AMEY DATEL Project Offices
1st Floor, Platform 2/3
Eastleigh Station
Southampton Road
Eastleigh
Hants
SO50 9FL

COPYRIGHT © AMEY Rail
All rights reserved. Neither this drawing or any of the information it contains may be copied or communicated to third parties without the written permission of the copyright holder

SITE/PROJECT		SOUTH WEST TRAINS CIS PROJECT	
TITLE		SUNNYMEADS AS BUILT	
SCALE	DRG No.	ISSUE	SHEET
NTS	SM803-75675	B	1 of 1