

DRG No.


SM803-75932

WAN	
CIRCUIT ID	KXIP600394
IP ADDRESS	10.227.101.1


"PLATFORM 1 HP ISDN"
02380-611484
"PLATFORM 2 HP ISDN"
02380-611485

All Equipment tags to be prefixed with "SOA-"
 NOTE VDA Unit is feeding 3 monitors.
 2 No. 15" Cased Monitors
 1 No. C-CIDU-002

PATHWAY TO AIRPORT

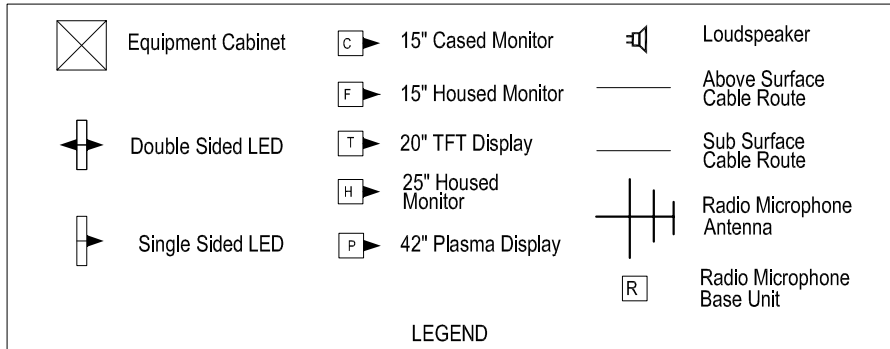

Equipment	Dist Board
EXISTING SPURS USED	

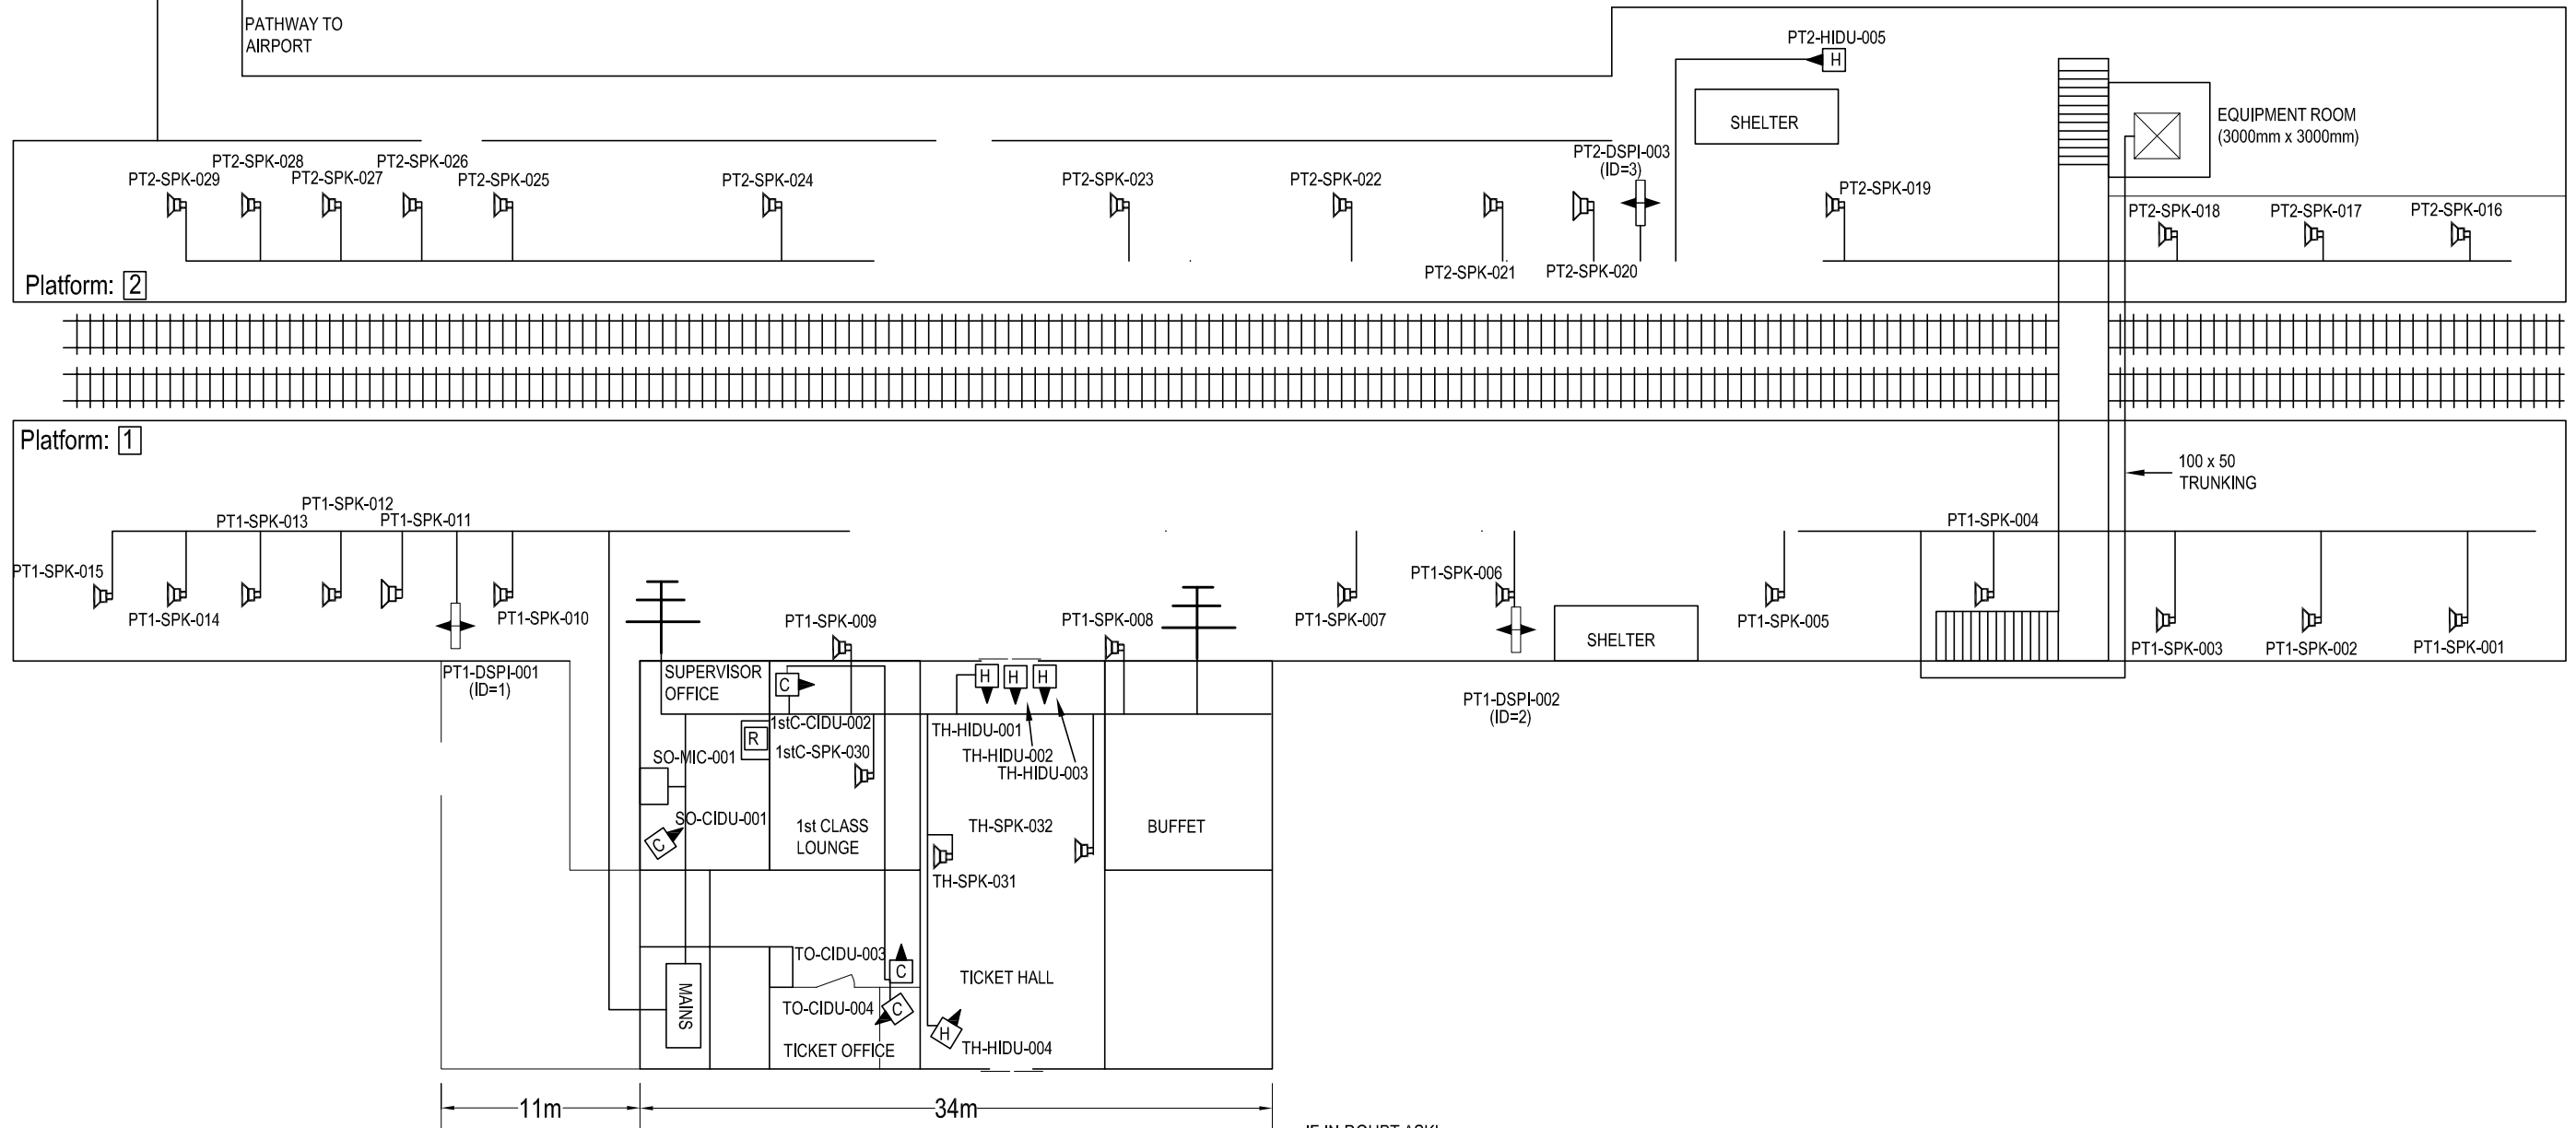

IF IN DOUBT ASK!

Date of Last Modification: 25 April 2003	CONSTRUCTION	<table border="1"> <tr> <th>NAME</th> <th>SIGNATURE</th> <th>DATE</th> </tr> <tr> <td>J STEVENS</td> <td></td> <td>25-04-2003</td> </tr> <tr> <td>T WONG</td> <td></td> <td></td> </tr> <tr> <td>A SMITH</td> <td></td> <td></td> </tr> </table>	NAME	SIGNATURE	DATE	J STEVENS		25-04-2003	T WONG			A SMITH			<p>AMEY DATEL Project Offices 1st Floor, Platform 2/3 Eastleigh Station Southampton Road Eastleigh Hants SO50 9FL</p>	SITE/PROJECT SOUTH WEST TRAINS CIS PROJECT	
		NAME	SIGNATURE	DATE													
J STEVENS		25-04-2003															
T WONG																	
A SMITH																	
<p>This Drawing Supersedes Any Previous Drawings</p>	<table border="1"> <tr> <th>DRAWN BY</th> <th>CHECKED BY</th> <th>APPD BY</th> <th>APPD BY</th> </tr> <tr> <td>J STEVENS</td> <td>T WONG</td> <td>A SMITH</td> <td></td> </tr> </table>	DRAWN BY	CHECKED BY	APPD BY	APPD BY	J STEVENS	T WONG	A SMITH		TITLE SOUTHAMPTON AIRPORT PARKWAY AS BUILT							
DRAWN BY	CHECKED BY	APPD BY	APPD BY														
J STEVENS	T WONG	A SMITH															
FINISH		CAD Ref:		<p>COPYRIGHT © AMEY Rail All rights reserved. Neither this drawing or any of the information it contains may be copied or communicated to third parties without the written permission of the copyright holder</p>	SCALE NTS	DRG No. SM803-75932	ISSUE D	SHEET 1 of 1									