




WAN	
CIRCUIT ID	KXIP 600399
IP ADDRESS	10.227.205.1

"PLATFORM 1 HP ISDN"
0208-894-7586
"PLATFORM 2 HP ISDN"
0208-894-7591

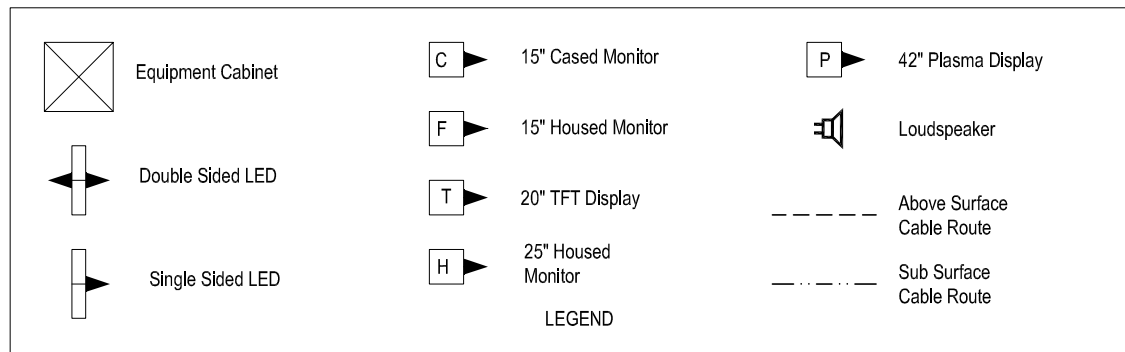

Equipment	Dist Board
CIS RACK	NEW BOARD
PT1-DSPI-001	MEM BOARD GP3 CCT 2
PT2-DSPI-002	MEM BOARD GP3 CCT 2

All Equipment tags to be prefixed with "STW-"

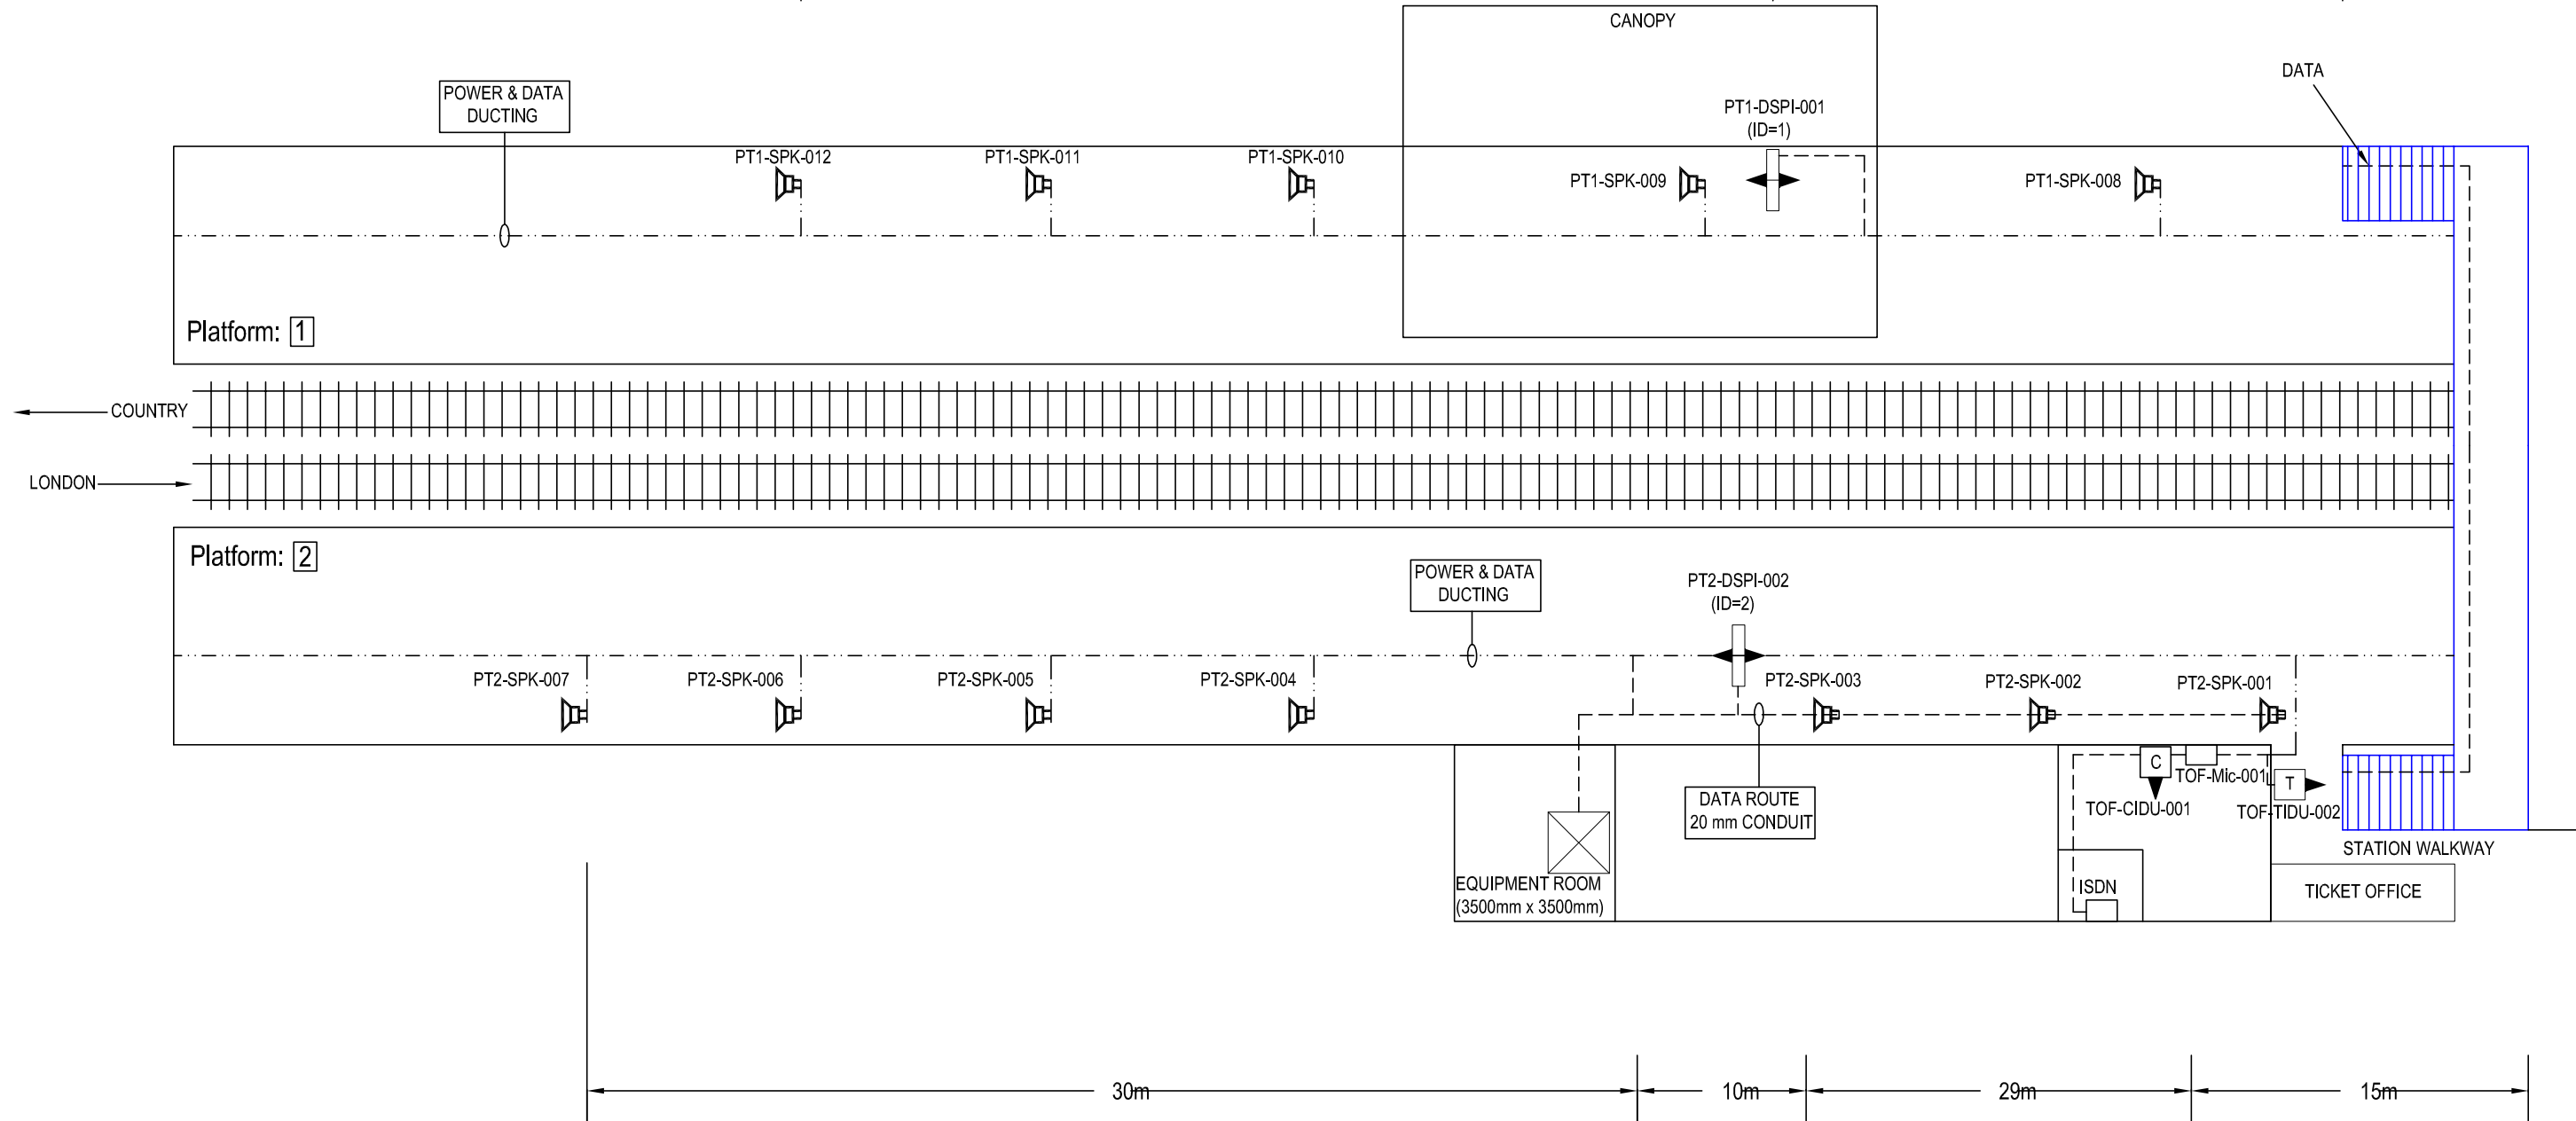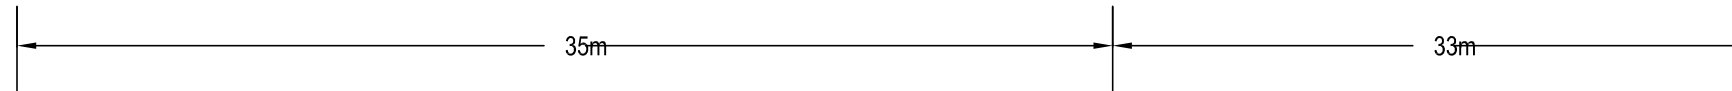

IF IN DOUBT ASK!

MATERIAL	CONSTRUCTION	<table border="1"> <thead> <tr> <th>NAME</th> <th>SIGNATURE</th> <th>DATE</th> </tr> </thead> <tbody> <tr> <td>D GADDU</td> <td></td> <td>22-05-2002</td> </tr> <tr> <td>T WONG</td> <td></td> <td></td> </tr> <tr> <td>A SMITH</td> <td></td> <td></td> </tr> </tbody> </table>	NAME	SIGNATURE	DATE	D GADDU		22-05-2002	T WONG			A SMITH			<p>AMEY DATEL Project Offices 1st Floor, Platform 2/3 Eastleigh Station Southampton Road Eastleigh Hants SO50 9FL</p>	SITE/PROJECT		SOUTH WEST TRAINS CIS PROJECT	
		NAME	SIGNATURE	DATE															
D GADDU		22-05-2002																	
T WONG																			
A SMITH																			
FINISH				TITLE		STRAWBERRY HILL AS BUILT													
		CAD Ref:	COPYRIGHT © AMEY Rail All rights reserved. Neither this drawing or any of the information it contains may be copied or communicated to third parties without the written permission of the copyright holder		SCALE	DRG No.	ISSUE	SHEET											
		CONTRACTOR'S Ref:			NTS	SM803-75607	C	1 of 1											