



WAN	
CIRCUIT ID	KXIP 600403
IP ADDRESS	10.227.7.1

"PLATFORM 1 HP ISDN"
0208-390-7026
"PLATFORM 2 HP ISDN"
0208-390-6312


All Equipment tags to be prefixed with "SUR-"

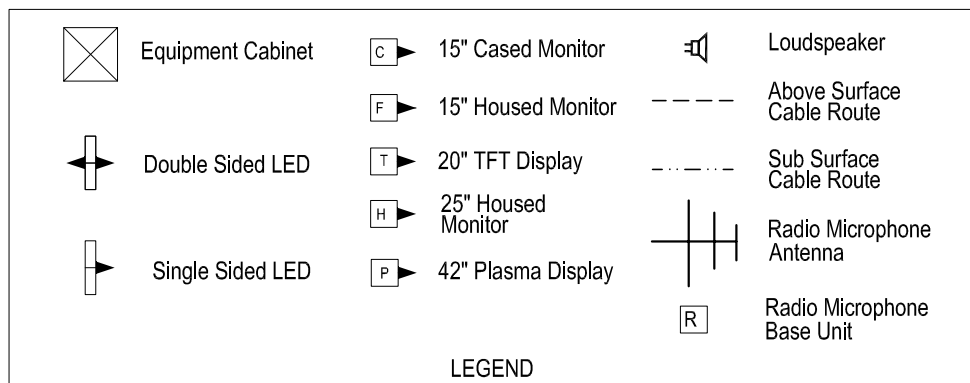

Equipment	Dist Board	
CIS RACK	S & T DB	R5
TOF-CIDU-001	PT1/2 GP1	R4

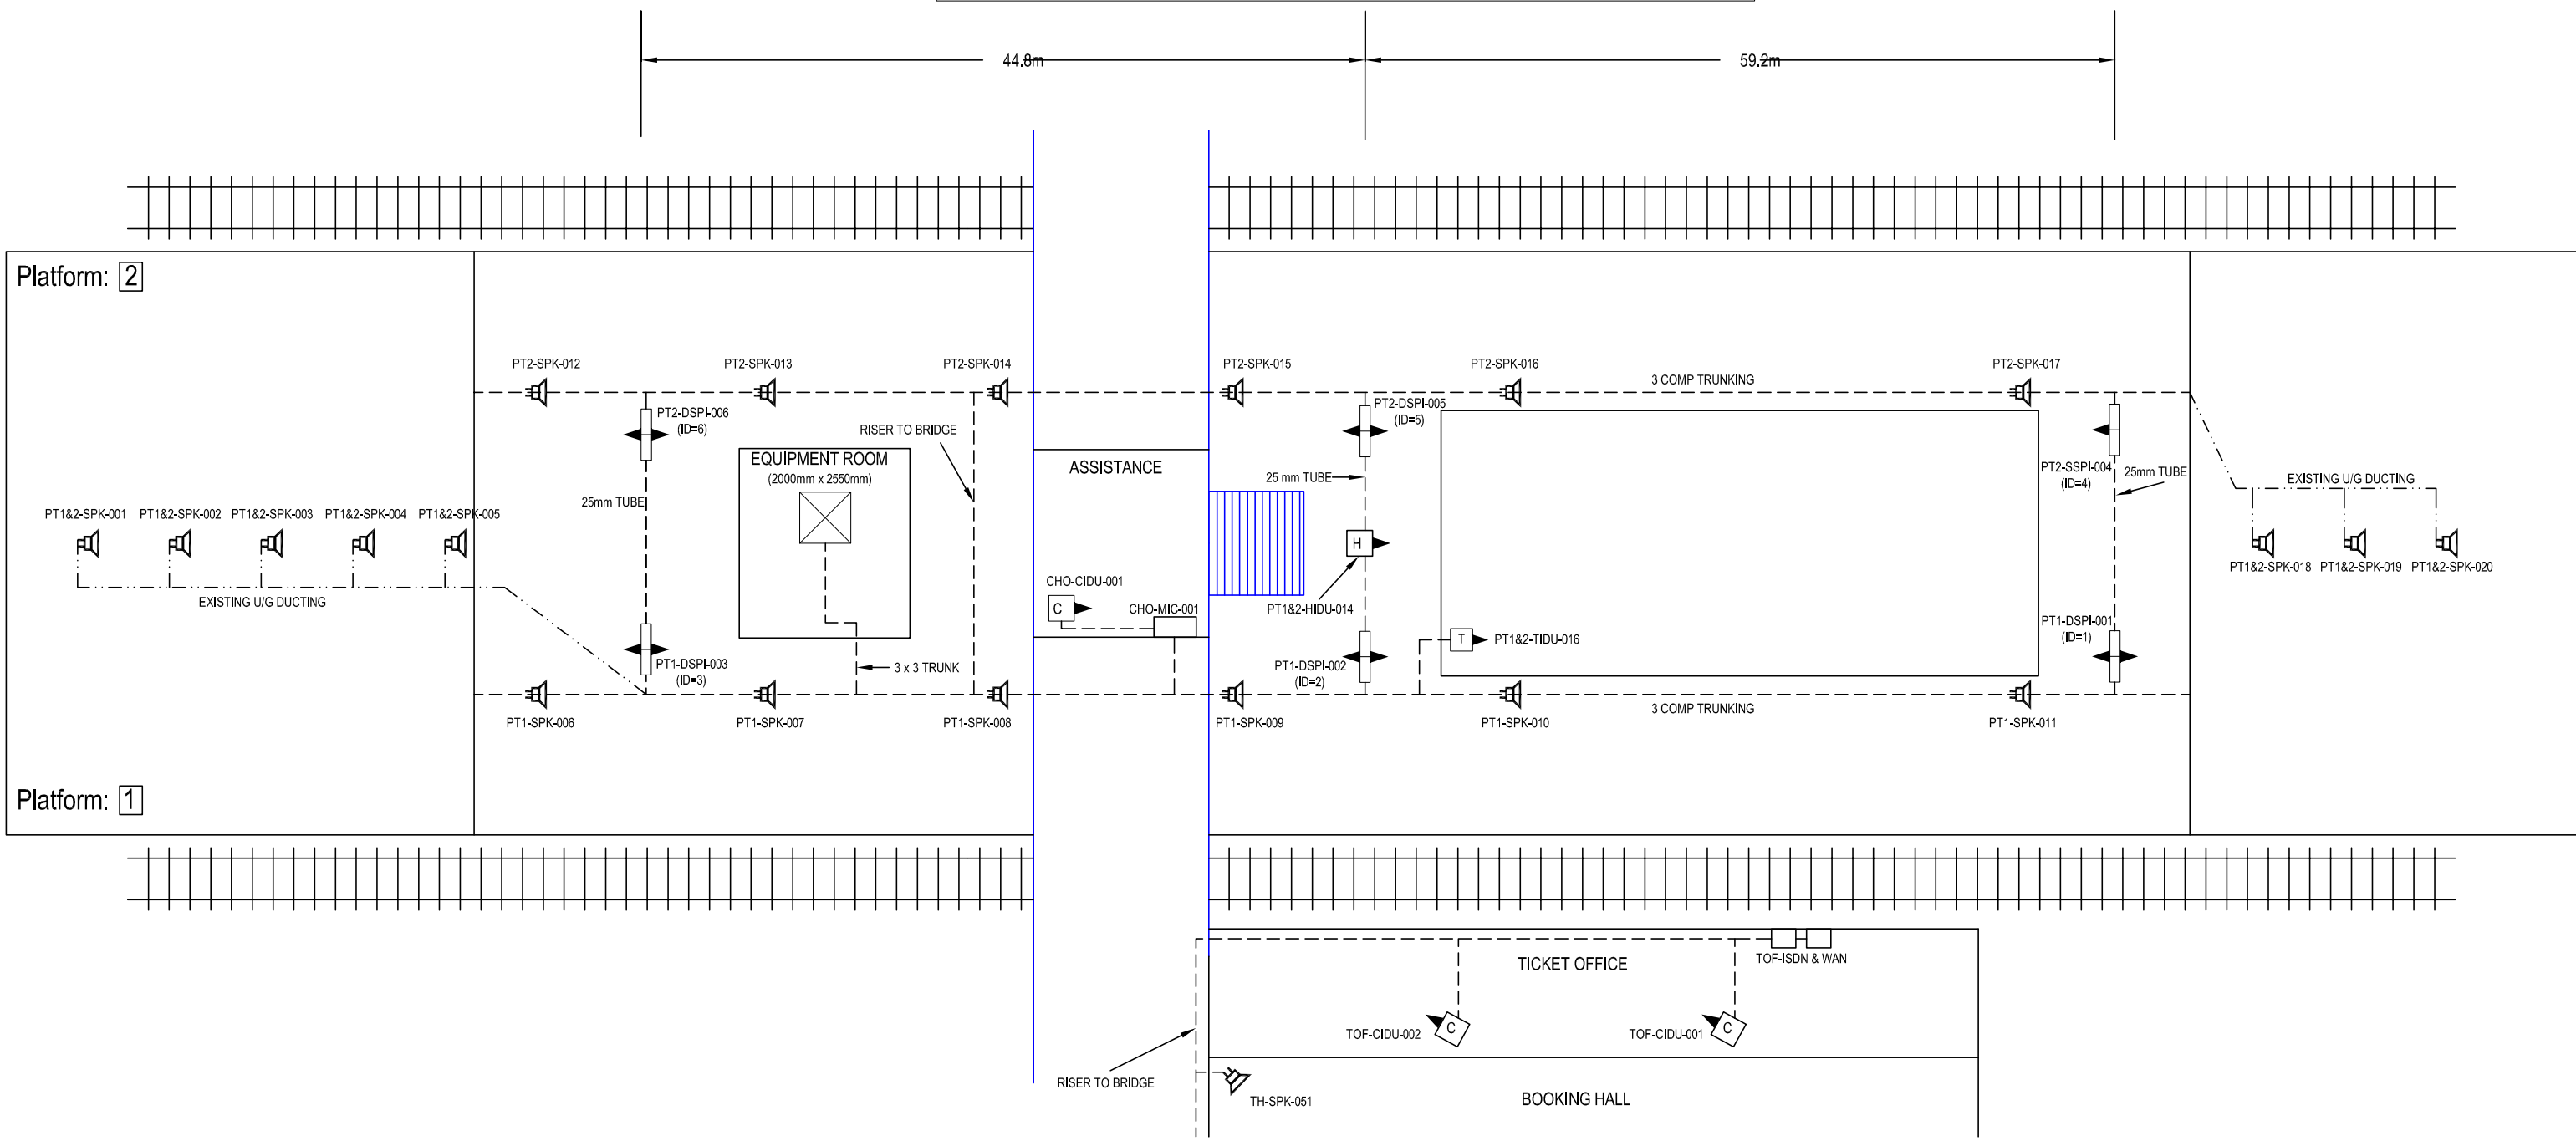

IF IN DOUBT ASK!

MATERIAL	CONSTRUCTION	NAME	SIGNATURE	DATE	 AMEY DATEL Project Offices 1st Floor, Platform 2/3 Eastleigh Station Southampton Road Eastleigh Hants SO50 9FL	SITE/PROJECT		
		DRAWN BY: D GADDU CHECKED BY: T WONG APPD BY: A SMITH		23-05-2002		SOUTH WEST TRAINS CIS PROJECT		
FINISH	CONSTRUCTION				COPYRIGHT © AMEY Rail All rights reserved. Neither this drawing or any of the information it contains may be copied or communicated to third parties without the written permission of the copyright holder	TITLE		
						SURBITON AS BUILT		
		CAD Ref:			SCALE	DRG No.	ISSUE	SHEET
		CONTRACTOR'S Ref:			NTS	SM803-75571	C	1 of 3

WAN	
CIRCUIT ID	KXIP 600403
IP ADDRESS	10.227.7.1



"PLATFORM 1 HP ISDN"
0208-390-7026
"PLATFORM 2 HP ISDN"
0208-390-6312

All Equipment tags to be prefixed with "SUR-"

	Equipment Cabinet		15" Cased Monitor		Loudspeaker
	Double Sided LED		15" Housed Monitor		Above Surface Cable Route
	Single Sided LED		20" TFT Display		Sub Surface Cable Route
			25" Housed Monitor		Radio Microphone Antenna
			42" Plasma Display		Radio Microphone Base Unit

LEGEND

Equipment	Dist Board	
PT3/4-CIDU-012	DB2AR	R6
PT3/4-CIDU-009	DB2AR	R6
RADIO BASE UNIT	DB2AB	B5

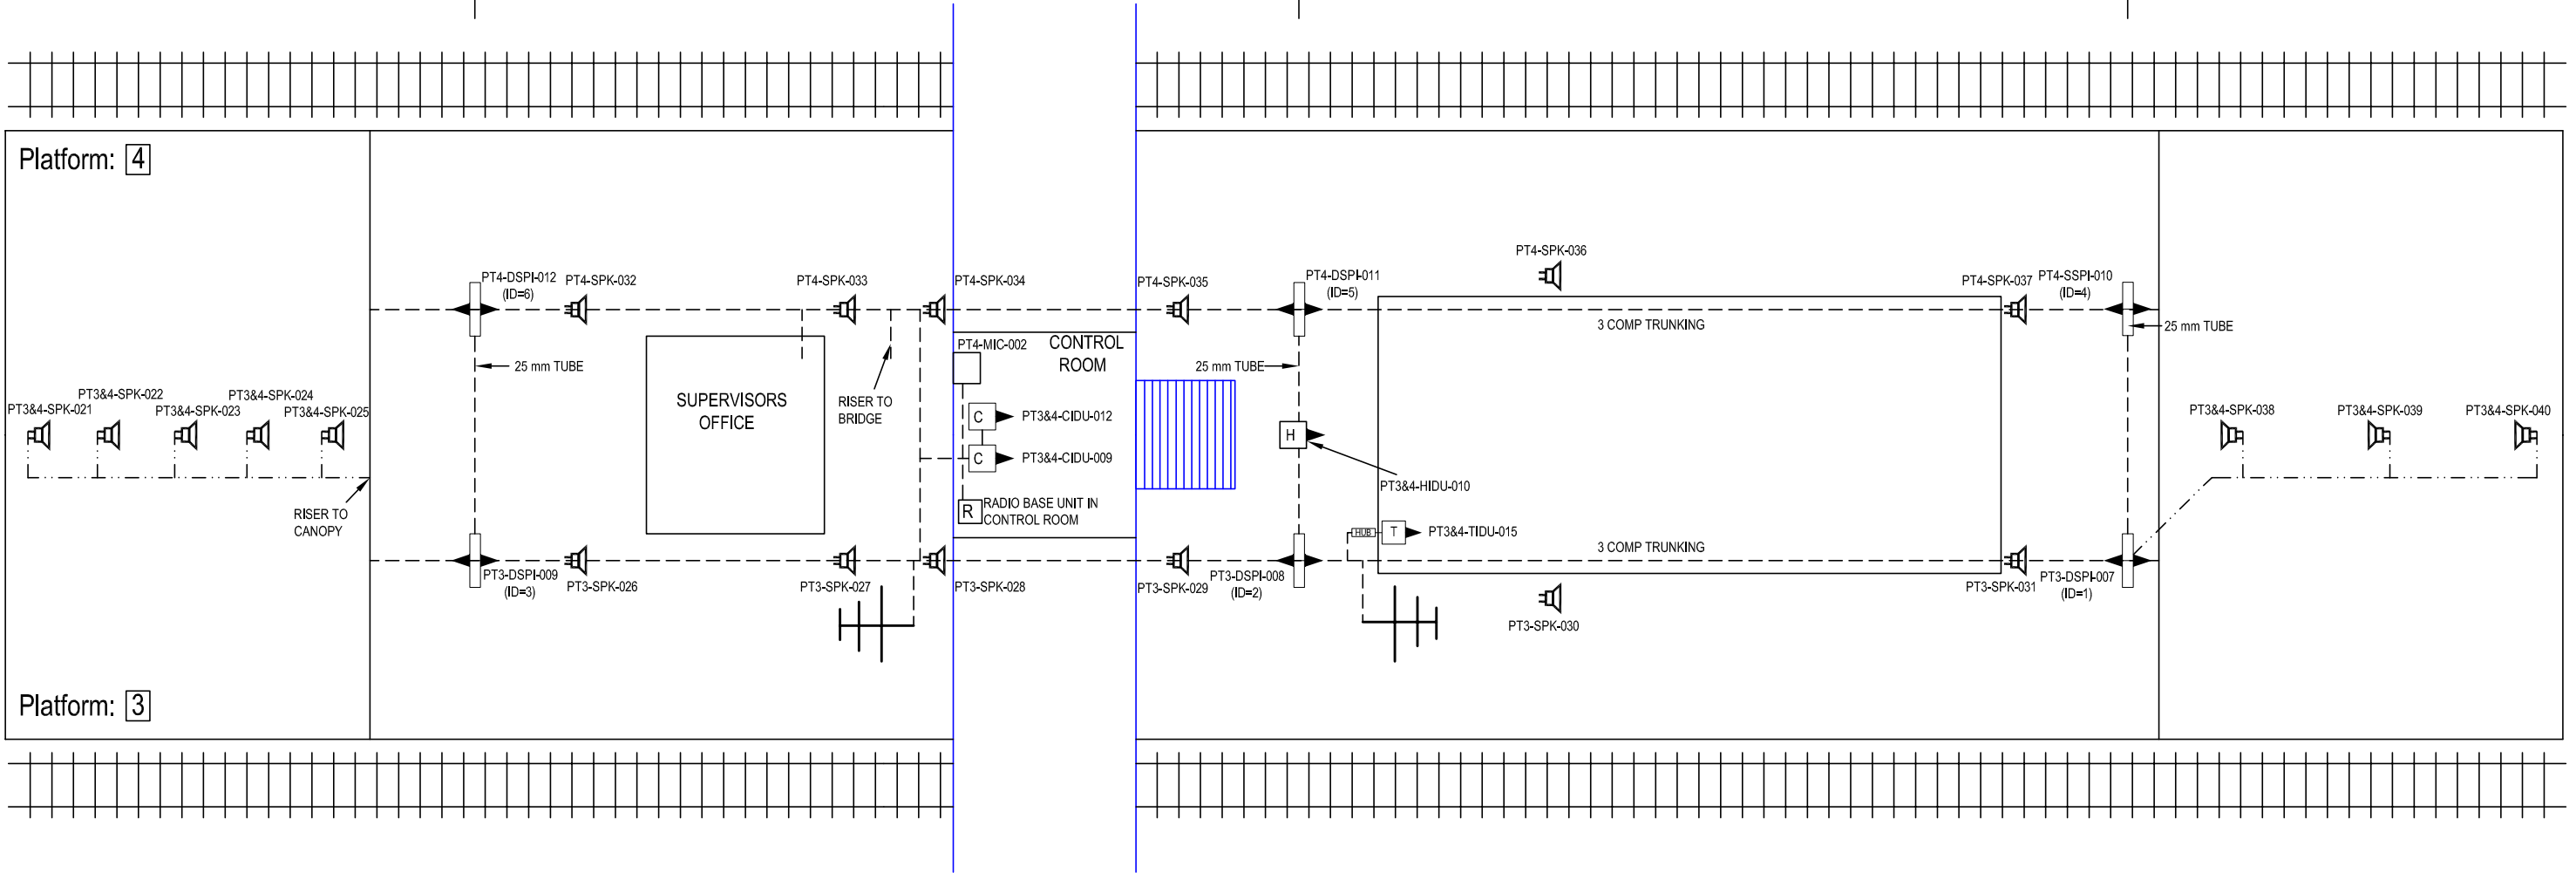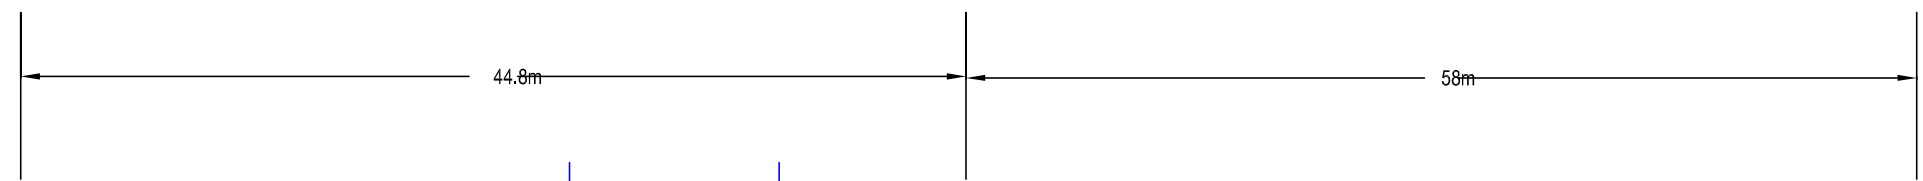


IF IN DOUBT ASK!

MATERIAL	CONSTRUCTION	NAME	SIGNATURE	DATE	<p>AMEY DATEL Project Offices 1st Floor, Platform 2/3 Eastleigh Station Southampton Road Eastleigh Hants SO50 9FL</p>	SITE/PROJECT		
		DRAWN BY		23-05-2002		SOUTH WEST TRAINS CIS PROJECT		
FINISH		CHECKED BY			<p>COPYRIGHT © AMEY Rail All rights reserved. Neither this drawing or any of the information it contains may be copied or communicated to third parties without the written permission of the copyright holder</p>	TITLE		
		APPD BY				SURBITON AS BUILT		
		CAD Ref:			SCALE	DRG No.	ISSUE	SHEET
		CONTRACTOR'S Ref:			NTS	SM803-75571	C	2 of 3



WAN	
CIRCUIT ID	KXIP 600403
IP ADDRESS	10.227.7.1

"PLATFORM 1 HP ISDN"
0208-390-7026
"PLATFORM 2 HP ISDN"
0208-390-6312

All Equipment tags to be prefixed with "SUR-"

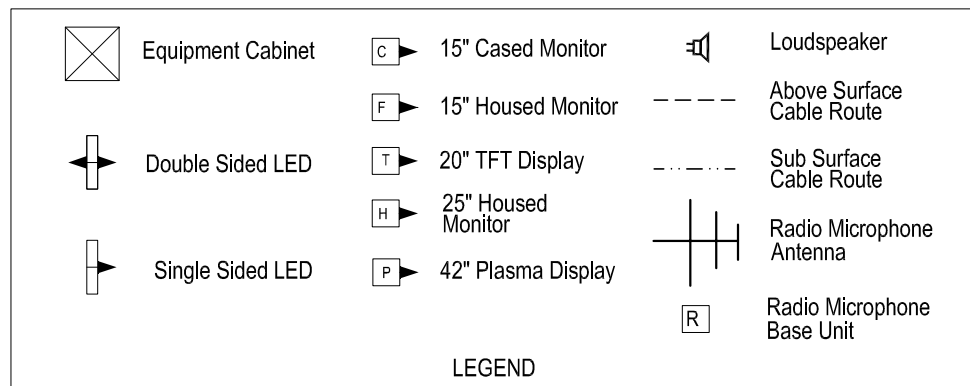


Equipment	Dist Board	
FB-HIDU-005/004	LIFT RM DB	R1
FB-HIDU-006/007	TO DB	R4
TOF-CIDU-008	DB1A	Y4

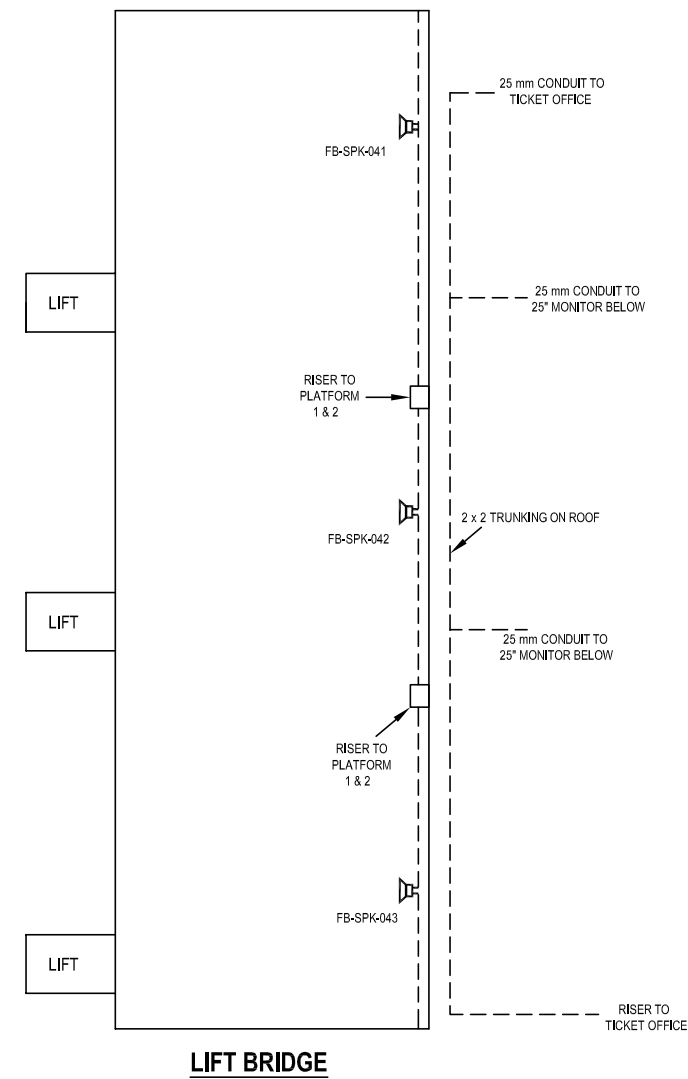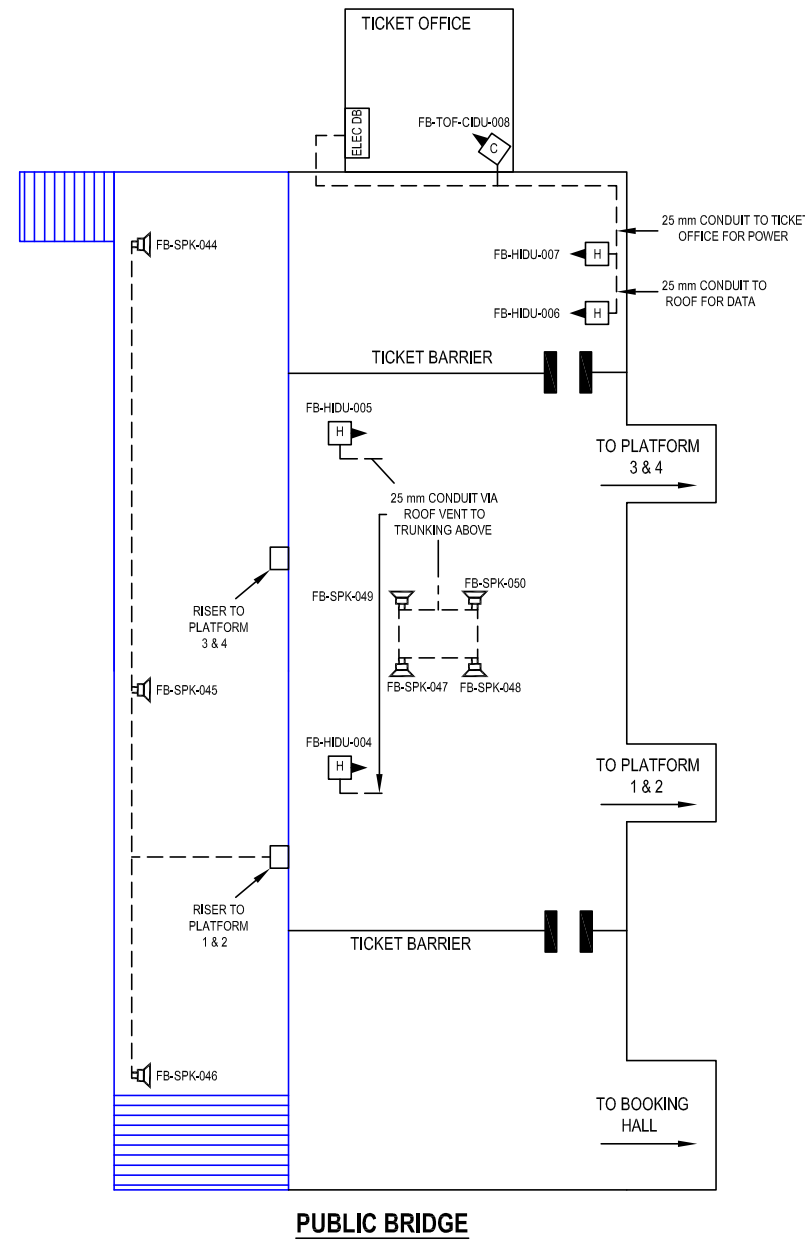

IF IN DOUBT ASK!

MATERIAL	CONSTRUCTION
FINISH	

NAME	SIGNATURE	DATE
D GADDU		23-05-2002
T WONG		
A SMITH		
CAD Ref:		
CONTRACTOR'S Ref:		



AMEY DATEL Project  
 Offices  
 1st Floor, Platform  
 2/3  
 Eastleigh Station  
 Southampton Road  
 Eastleigh  
 Hants  
 SO50 9FL

COPYRIGHT © AMEY Rail  
 All rights reserved. Neither this drawing or any of the information it contains may be copied or communicated to third parties without the written permission of the copyright holder

SITE/PROJECT		SOUTH WEST TRAINS CIS PROJECT	
TITLE		SURBITON AS BUILT	
SCALE	DRG No.	ISSUE	SHEET
NTS	SM803-75571	B	3 of 3