


DRG No. SM803-75608


WAN Details	
CIRCUIT ID	KXIP600400
IP ADDRESS	10.227.206.1

"PLATFORM 1 HP ISDN"
01-932-789308
"PLATFORM 2 HP ISDN"
01-932-785122

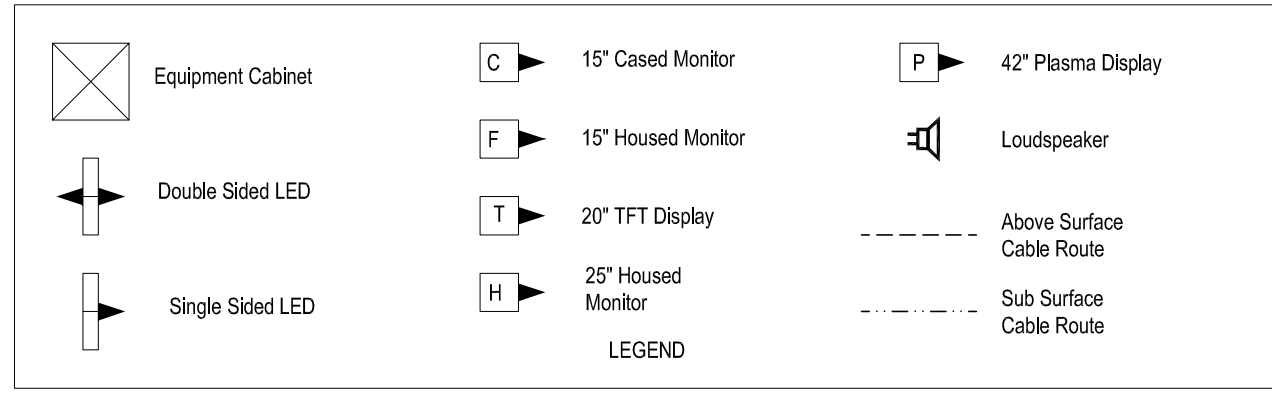

Equipment	Dist Board
TH-FIDU-001	EXISTING
CIS RACK	CP1 20A
PT1-DSPI-001	EXISTING
PT2-DSPI-002	EXISTING

All Equipment tags to be prefixed with "SUU-"

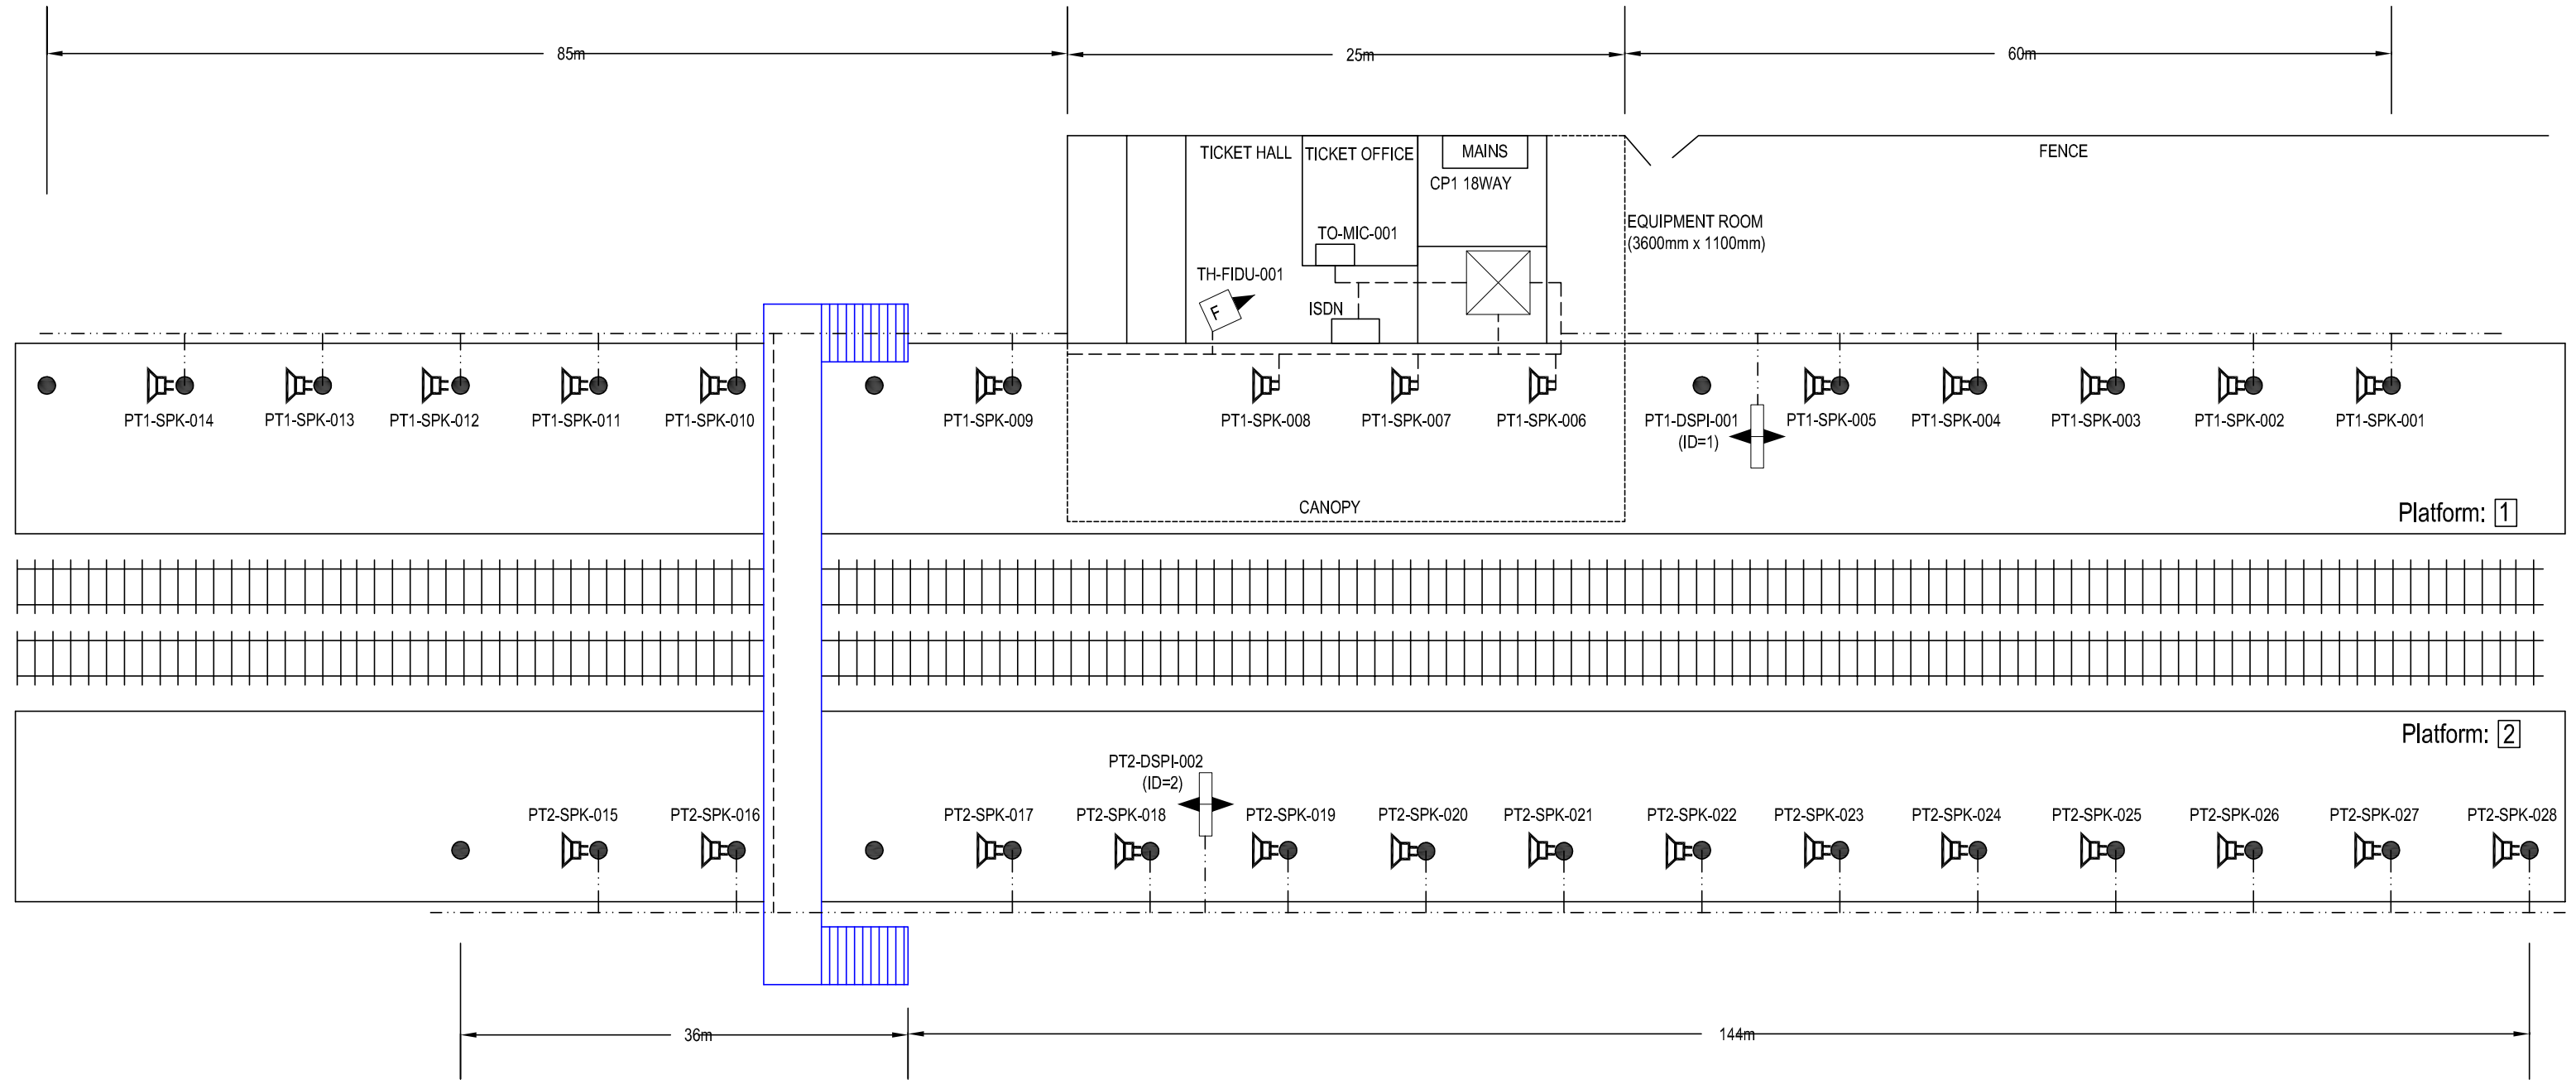

IF IN DOUBT ASK!

MATERIAL	CONSTRUCTION	DRAWN BY	A HATTON	SIGNATURE		AMEY DATEL Project Offices 1st Floor, Platform 2/3 Eastleigh Station Southampton Road Eastleigh Hants SO50 9FL	SITE/PROJECT		SOUTH WEST TRAINS CIS PROJECT	
		CHECKED BY	T WONG	DATE	03-07-2002		TITLE		SUNBURY AS BUILT	
FINISH		APPD BY	A SMITH			COPYRIGHT © AMEY Rail All rights reserved. Neither this drawing or any of the information it contains may be copied or communicated to third parties without the written permission of the copyright holder	SCALE	DRG No.	ISSUE	SHEET
		CAD Ref:					NTS	SM803-75608	B	1 of 1
CONTRACTOR'S Ref:										