



WAN	
CIRCUIT ID	KXIP 600406
IP ADDRESS	10.227.209.1

"PLATFORM 1 HP ISDN"
01-590-681824
"PLATFORM 2 HP ISDN"
01-590-681851

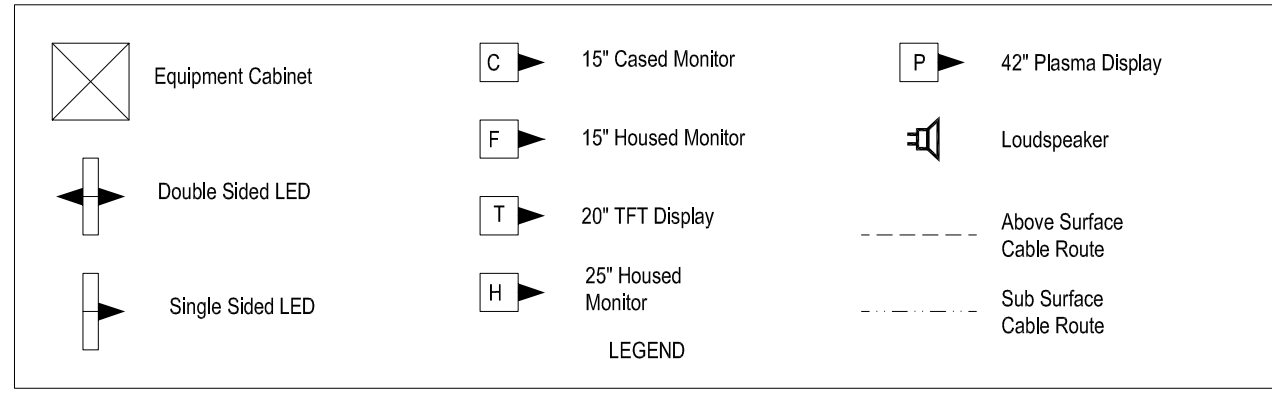

Equipment	Dist Board
13 A TWIN SKT	CCT NO 1
HEATER	CCT NO 2
CIS UNIT	CCT NO 3
STAT + FAN	CCT NO 4
LIGHT	CCT NO 5
CRT	CCT NO 6
LED 2	CCT NO 7
LED 1	CCT NO 8
SPARE	CCT NO 9

All Equipment tags to be prefixed with "SWY-"

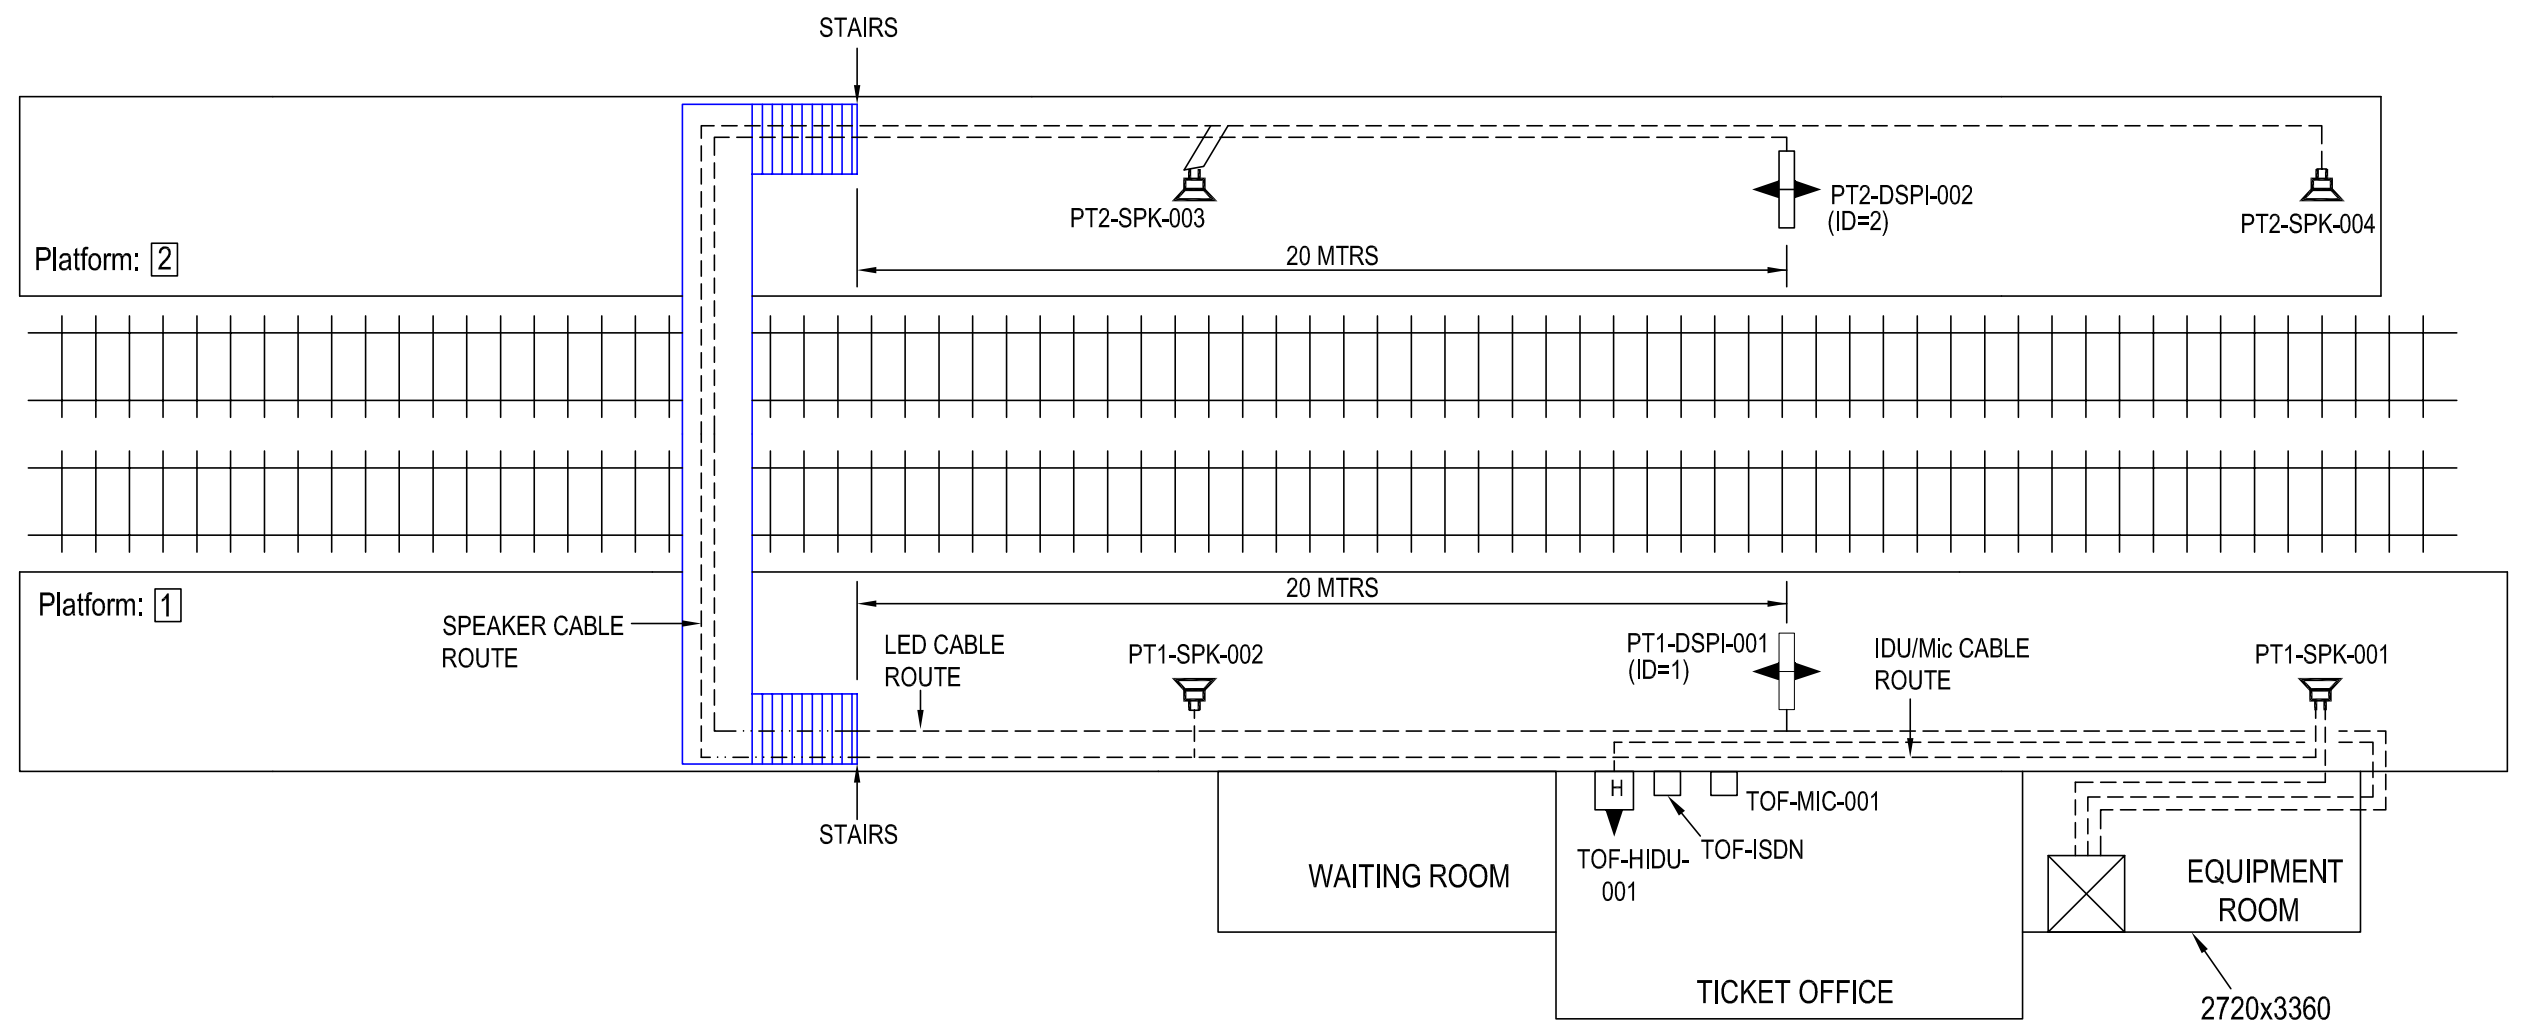

IF IN DOUBT ASK!

MATERIAL	CONSTRUCTION
FINISH	

	NAME	SIGNATURE	DATE
DRAWN BY	D GADDU		30-01-2002
CHECKED BY	T WONG		
APPD BY	A SMITH		
APPD BY			
CAD Ref:			
CONTRACTOR'S Ref:			

AMEY DATEL Project
Offices
1st Floor, Platform
2/3
Eastleigh Station
Southampton Road
Eastleigh
Hants
SO50 9FL

COPYRIGHT © AMEY Rail
All rights reserved. Neither this drawing or any of the information it contains may be copied or communicated to third parties without the written permission of the copyright holder

SITE/PROJECT		SOUTH WEST TRAINS CIS PROJECT	
TITLE		SWAY AS BUILT	
SCALE	DRG No.	ISSUE	SHEET
NTS	SM803-75884	B	1 of 1