


DRG No.

SM803-75610


WAN	
CIRCUIT ID	KXIP600410
IP ADDRESS	10.227.214.1

"PLATFORM 1 HP ISDN"
020-8398-9420
"PLATFORM 2 HP ISDN"
020-8398-2026


All Equipment tags to be prefixed with "THD-"

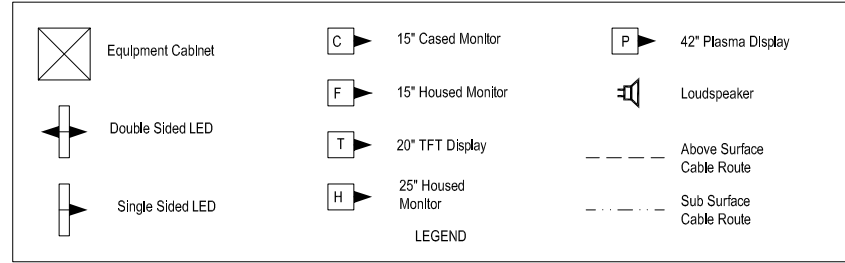

Equipment	Dist Board
RACK	GP1 CCT 12
TH-HIDU-001	GP1 CCT 1
PT1-DSPL-001	GP1 CCT 1
PT2-DSPL-002	GP1 CCT 1

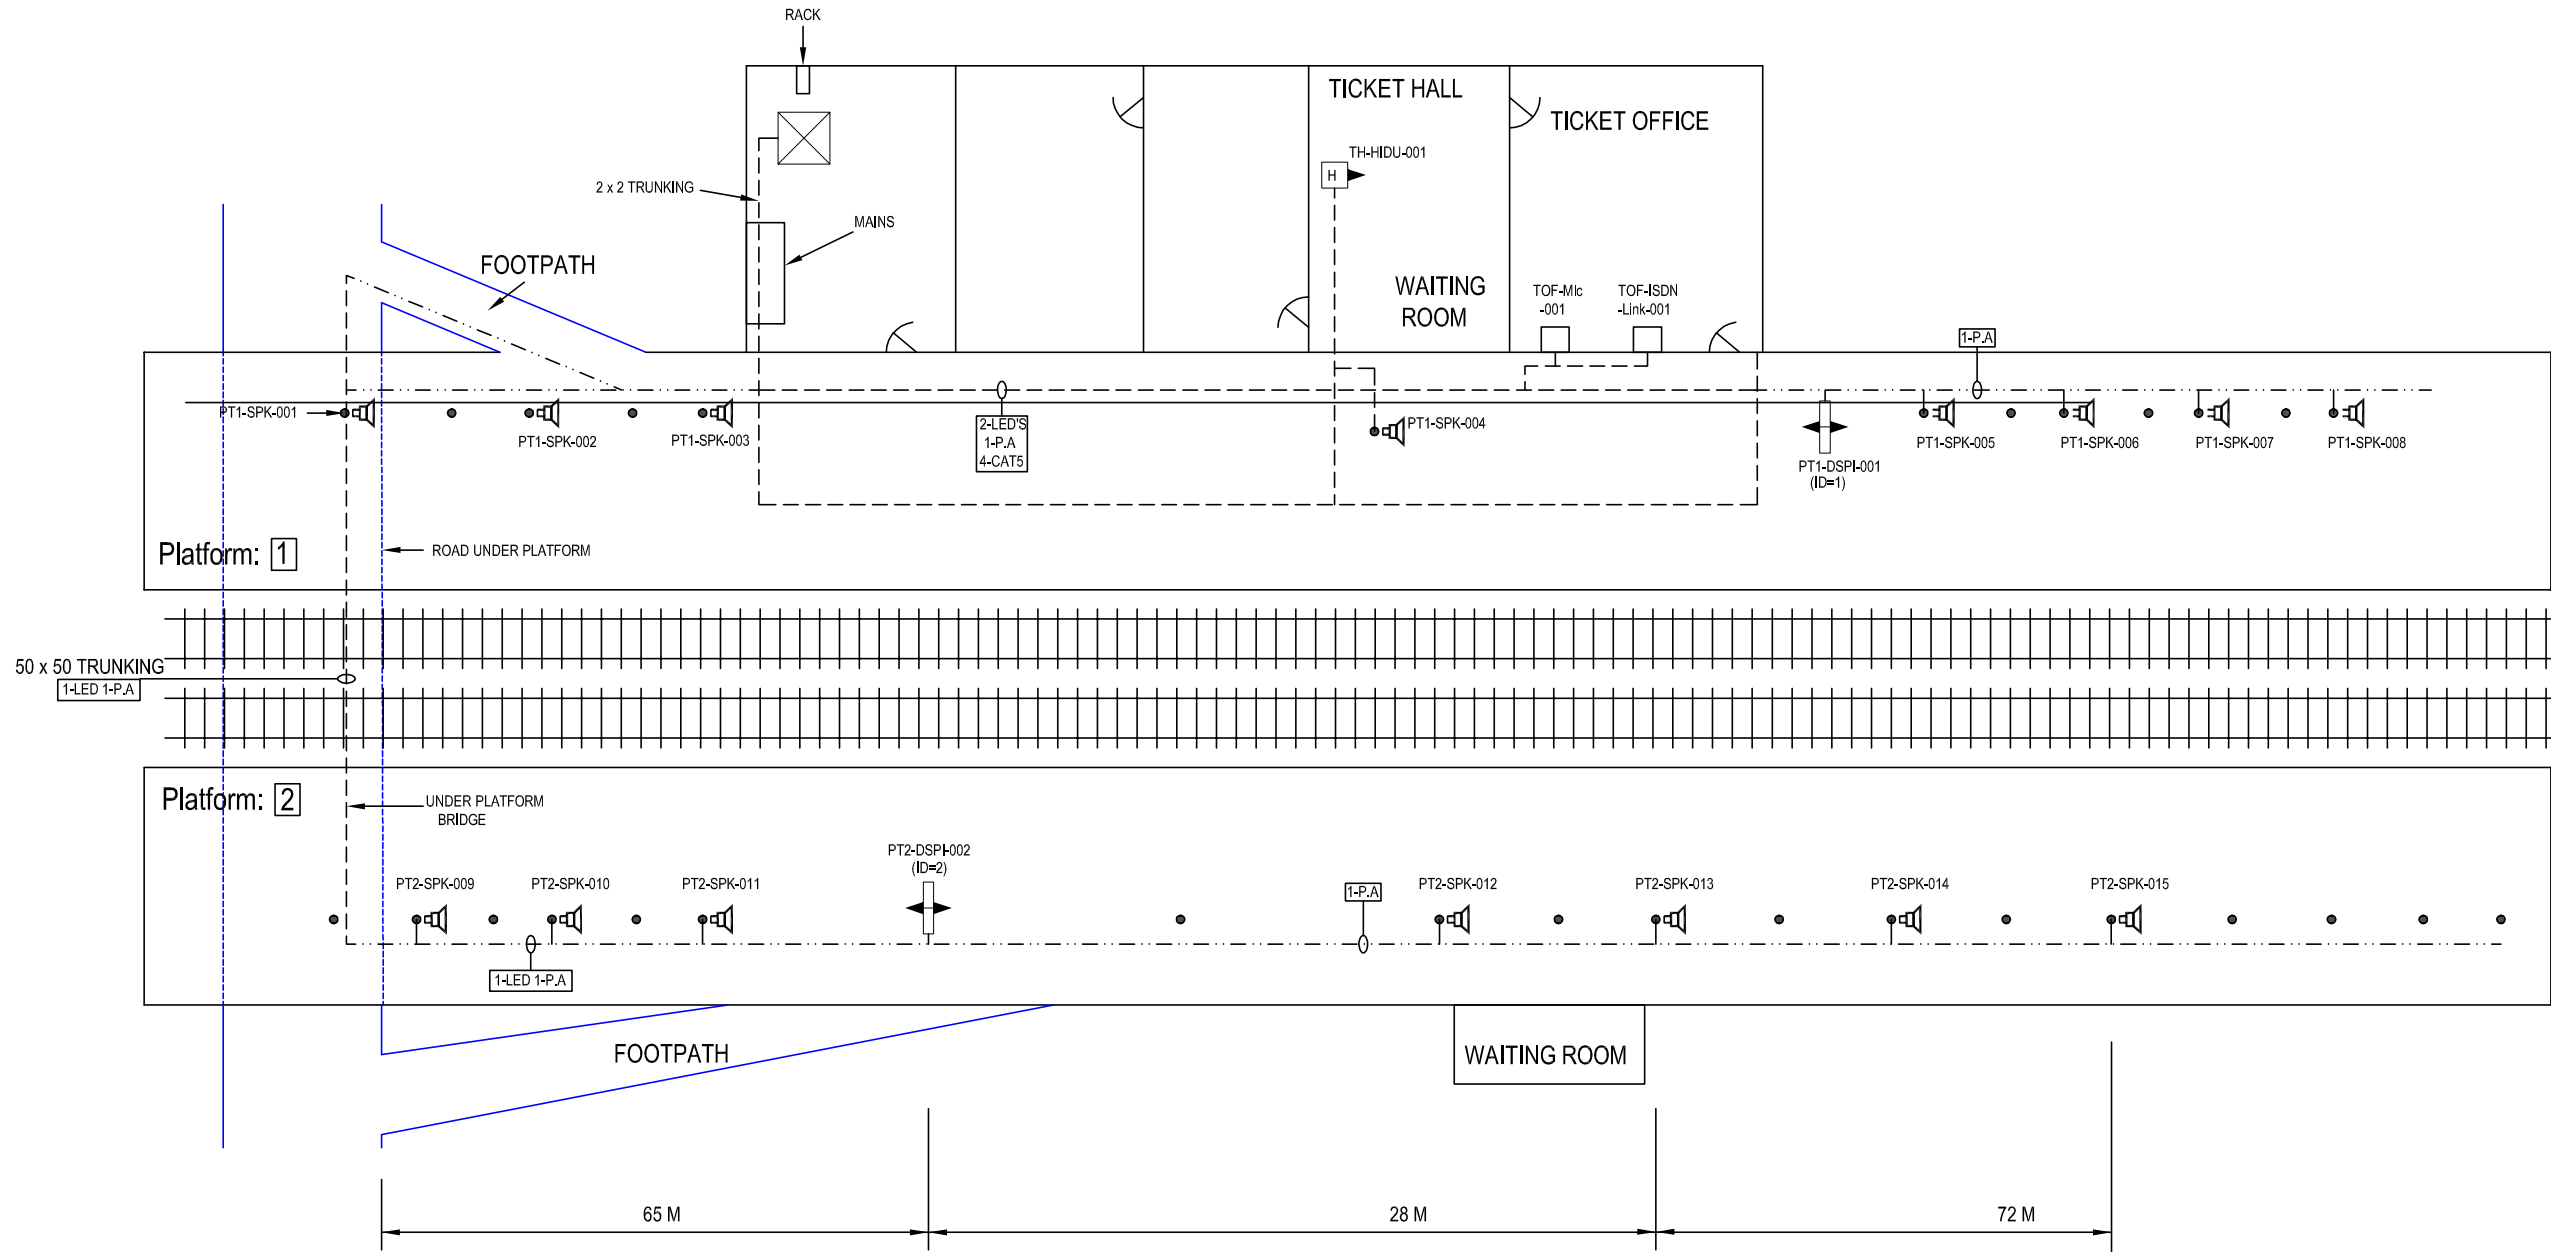

IF IN DOUBT ASK!

MATERIAL	CONSTRUCTION	NAME	SIGNATURE	DATE	 <p>AMEY DATEL Project Offices 1st Floor, Platform 2/3 Eastleigh Station Southampton Road Eastleigh Hants SO50 9FL</p>	SITE/PROJECT	
		DRAWN BY	D GADDU	15-05-2002		SOUTH WEST TRAINS CIS PROJECT	
		CHECKED BY	T WONG			TITLE	
		APPD BY	A SMITH			THAMES DITTON AS BUILT	
		APPD BY				SCALE	DRG No.
FINISH		CAD Ref:		NTS	SM803-75610	B	1 of 1
		CONTRACTOR'S Ref:		<p>COPYRIGHT © AMEY Rail All rights reserved. Neither this drawing or any of the information it contains may be copied or communicated to third parties without the written permission of the copyright holder</p>			