



WAN	
CIRCUIT ID	KXIP 600411
IP ADDRESS	10.227.215.1

"PLATFORM 1 HP ISDN"
01747 871680

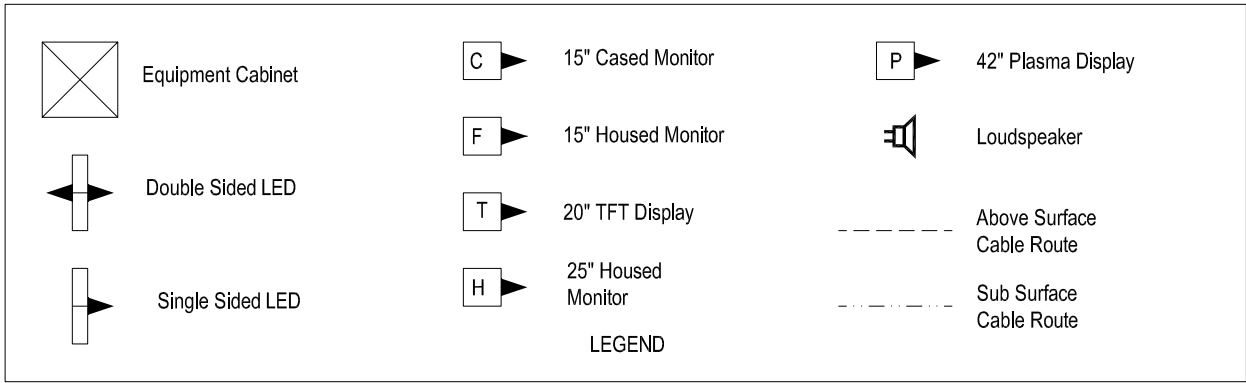

Equipment	Dist Board
CIS RACK	CCT NO. 1
THIS RM	CCT NO. 2
HEATER	CCT NO. 3
CRT TICKET HALL	CCT NO. 4
SPARE	CCT NO. 5-9

All Equipment tags to be prefixed with "TIS-"

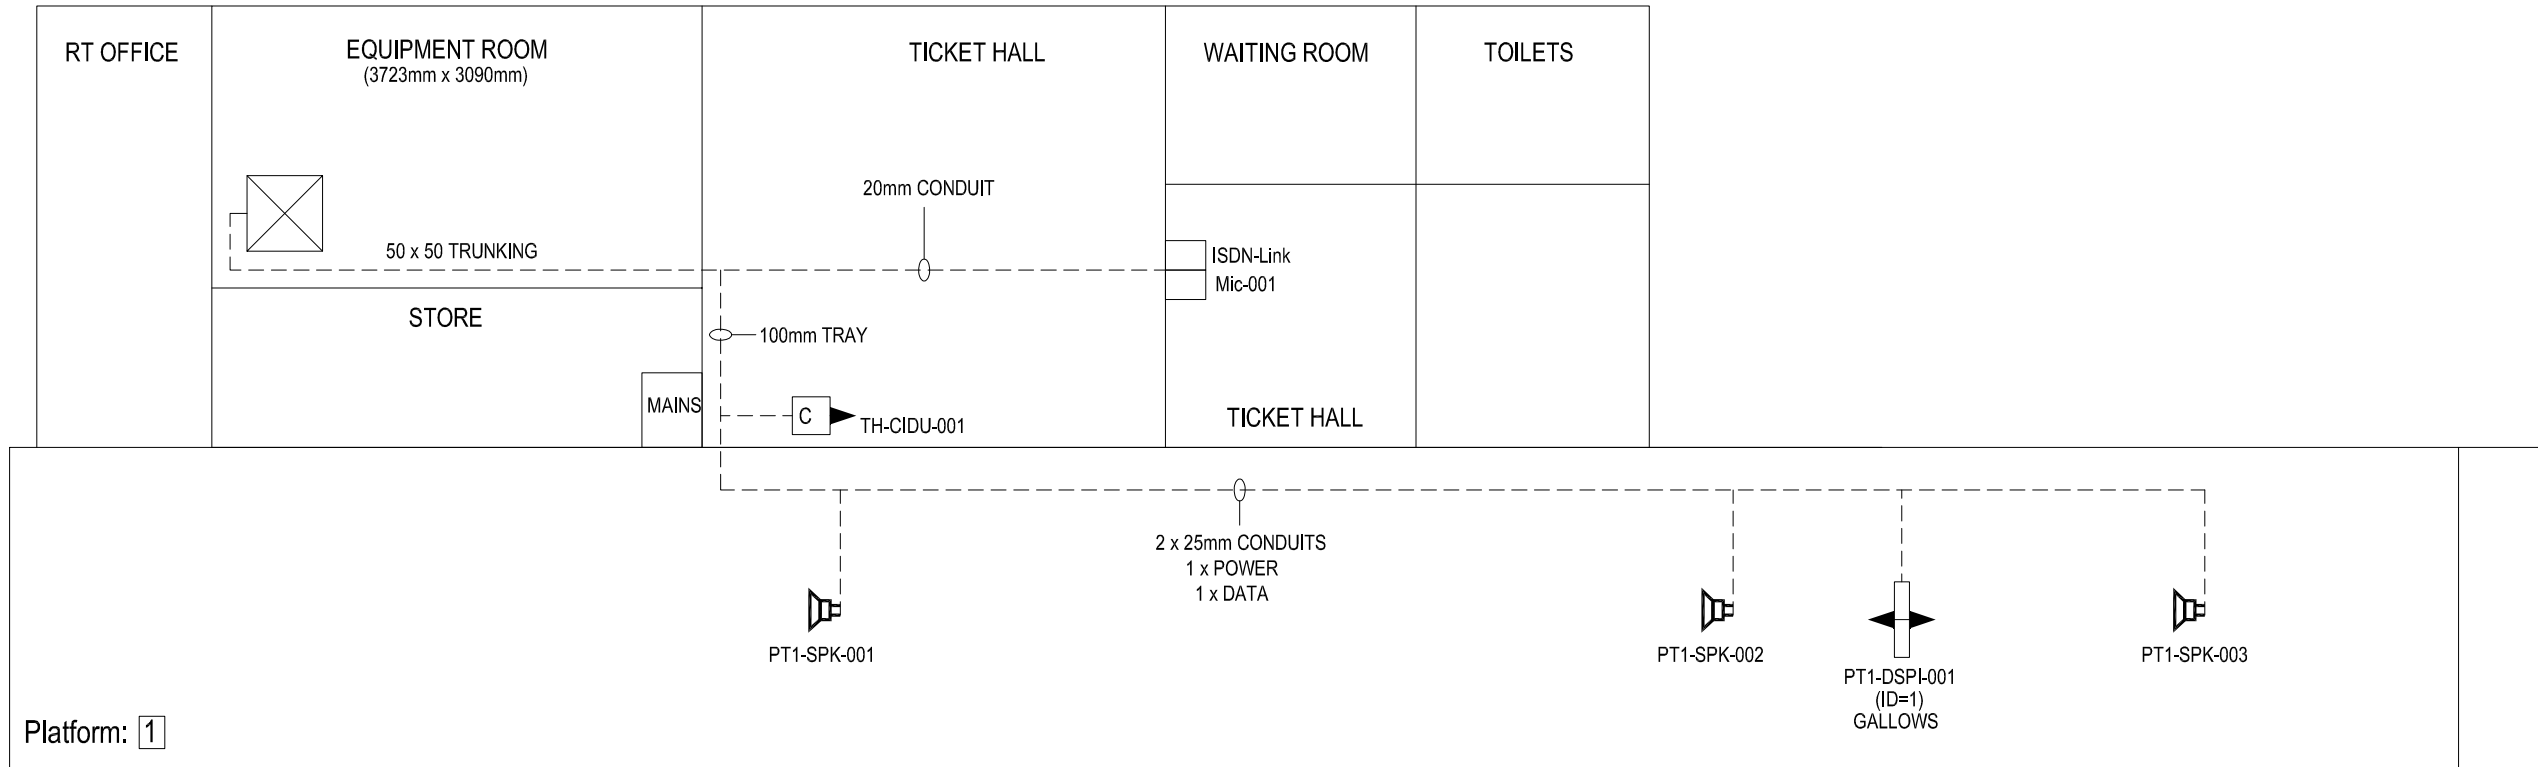

MATERIAL	CONSTRUCTION	IF IN DOUBT ASK!				AMEY DATEL Project Offices 1st Floor, Platform 2/3 Eastleigh Station Southampton Road Eastleigh Hants SO50 9FL		SITE/PROJECT SOUTH WEST TRAINS CIS PROJECT		
		DRAWN BY	D GADDU	SIGNATURE	DATE		TITLE TISBURY AS BUILT			
		CHECKED BY	T WONG							
		APPD BY	A SMITH				SCALE	DRG No.	ISSUE	SHEET
		CAD Ref:					NTS	SM803-75798	B	1 of 1
		CONTRACTOR'S Ref:				COPYRIGHT © AMEY Rail All rights reserved. Neither this drawing or any of the information it contains may be copied or communicated to third parties without the written permission of the copyright holder				