


DRG No. SM803-75582


WAN	
CIRCUIT ID	KXIP 600412
IP ADDRESS	10.227.216.1

"PLATFORM 1 HP ISDN"
0208-335-0768
"PLATFORM 2 HP ISDN"
0208-335-3796

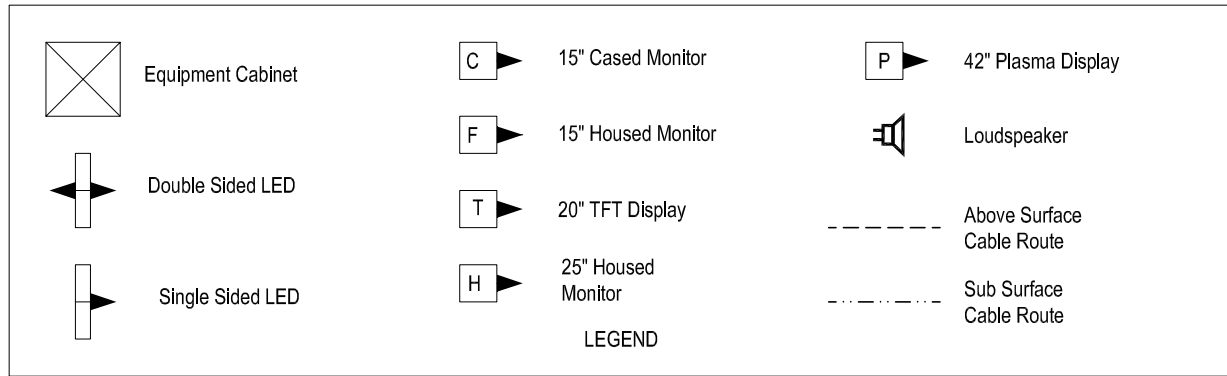

Equipment	Dist Board
CIS RACK	DB1 CCT 3
PT1-DSPI-001	DB1 CCT 4
PT2-DSPI-002	DB1 CCT 5


All Equipment tags to be prefixed with "TOL-"

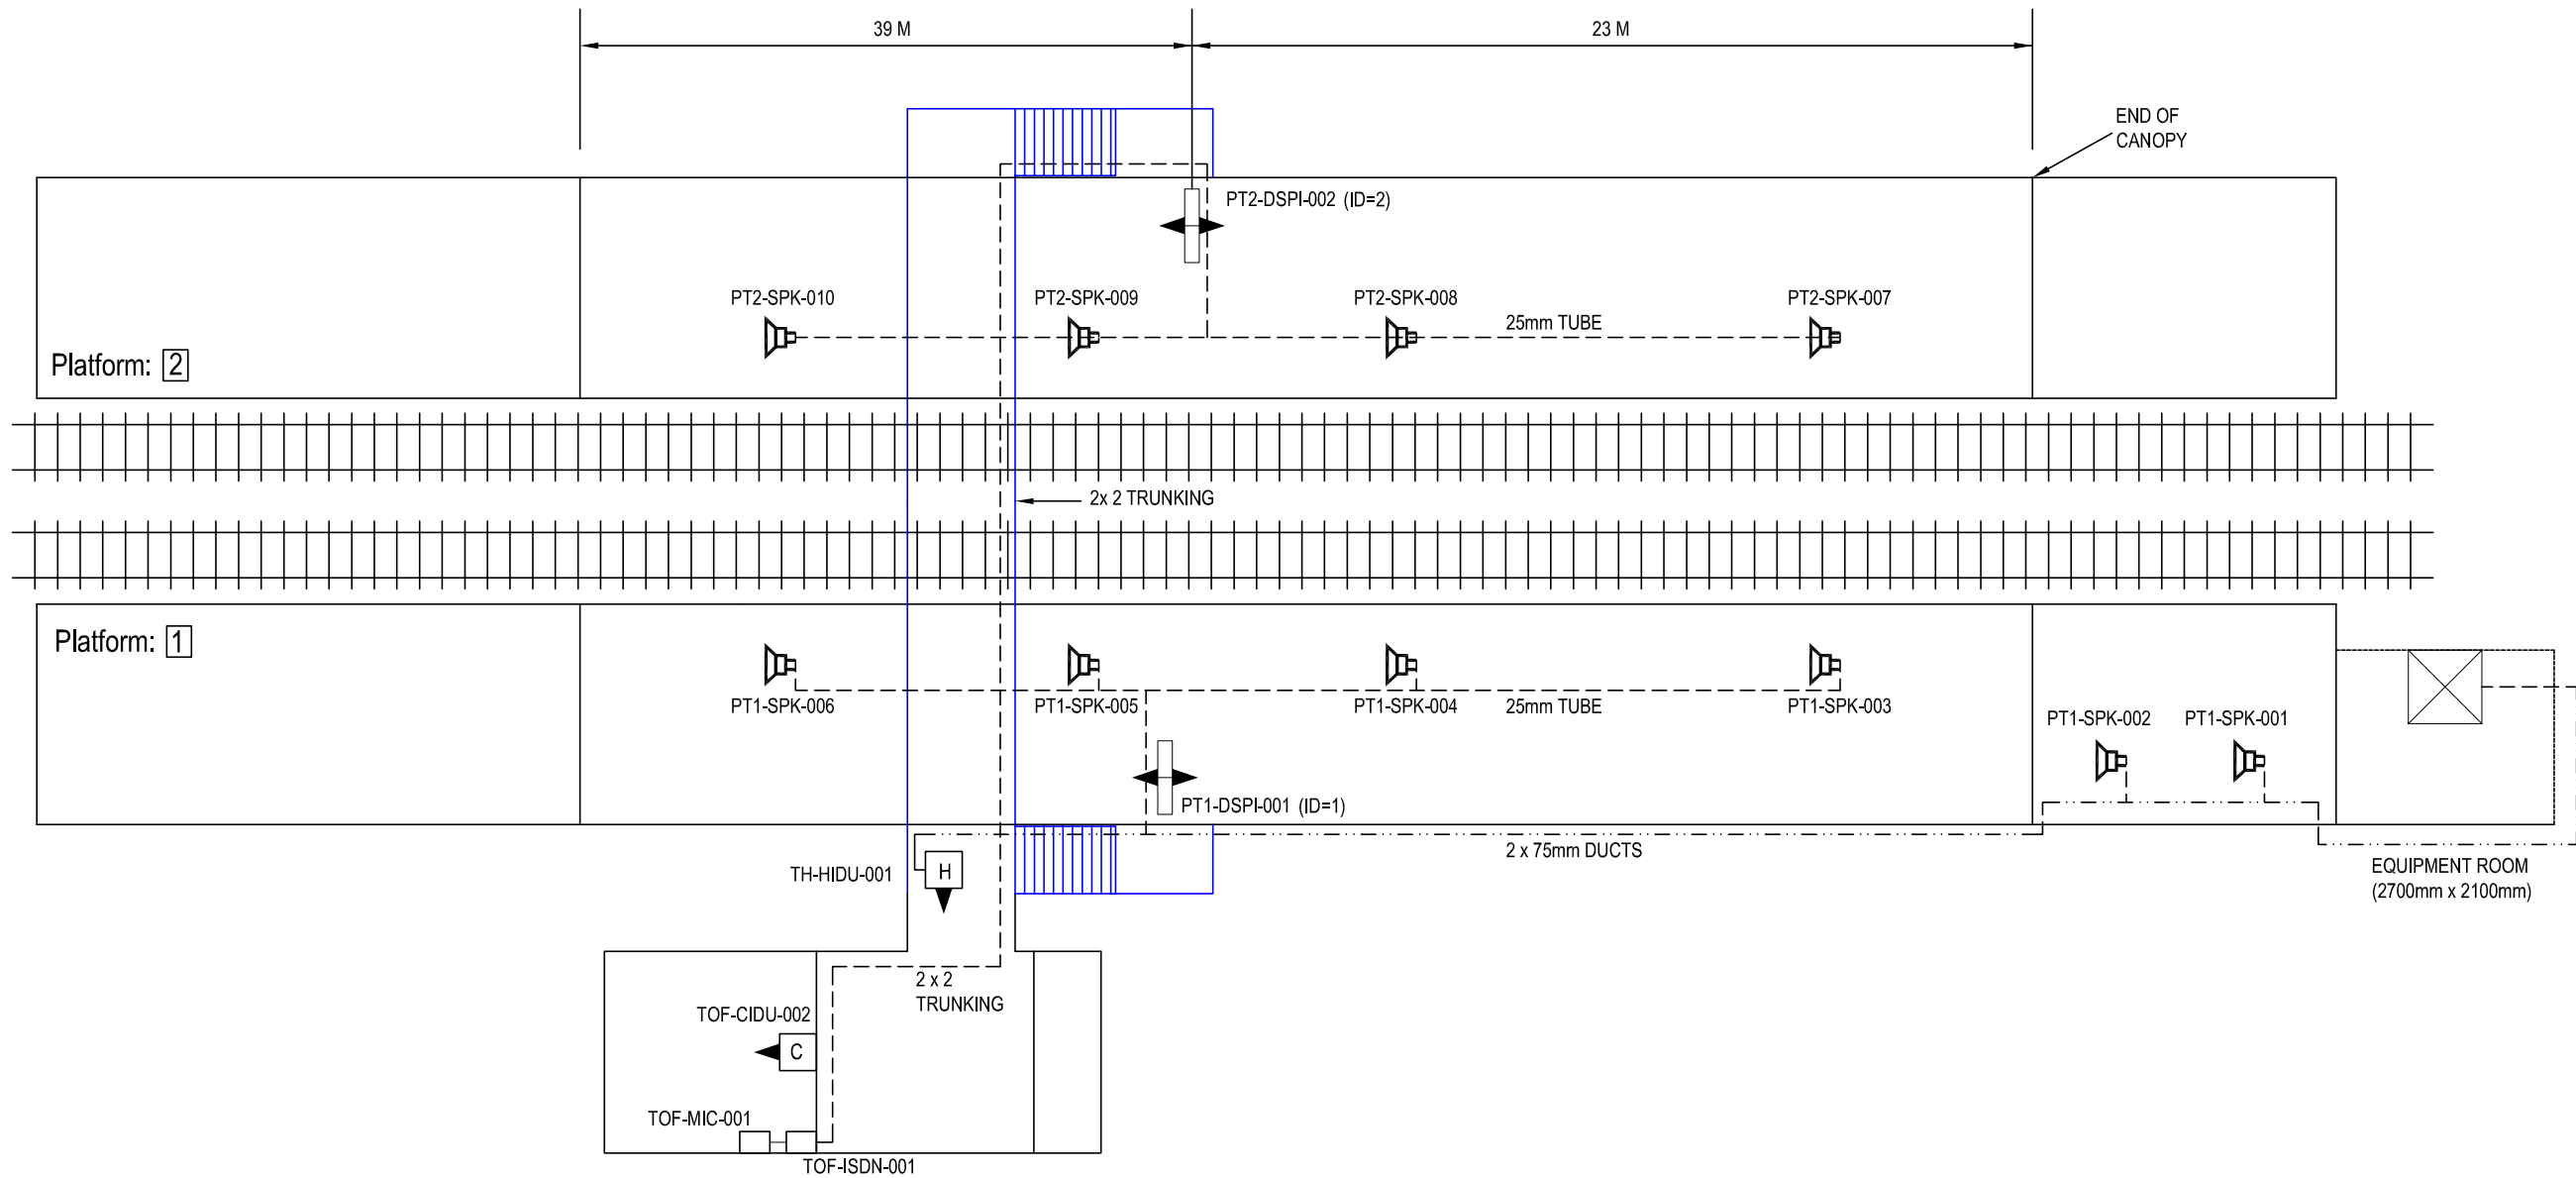

IF IN DOUBT ASK!

MATERIAL	
FINISH	

CONSTRUCTION	NAME	SIGNATURE	DATE
DRAWN BY	D GADDU		24-05-2002
CHECKED BY	T WONG		
APPD BY	A SMITH		
APPD BY			
CAD Ref:			
CONTRACTOR'S Ref:			



AMEY DATEL Project  
 Offices  
 1st Floor, Platform  
 2/3  
 Eastleigh Station  
 Southampton Road  
 Eastleigh  
 Hants  
 SO50 9FL

COPYRIGHT © AMEY Rail  
 All rights reserved. Neither this drawing or any of the information  
 it contains may be copied or communicated to third parties  
 without the written permission of the copyright holder

SITE/PROJECT		SOUTH WEST TRAINS CIS PROJECT	
TITLE		TOLWORTH AS BUILT	
SCALE	DRG No.	ISSUE	SHEET
NTS	SM803-75582	B	1 of 1