



WAN	
CIRCUIT ID	KXIP600414
IP ADDRESS	10.227.113.1

"PLATFORM 3 HP ISDN"
020-8744-9746
"PLATFORM 5 HP ISDN"
020-8744-9789

All Equipment tags to be prefixed with "TWI-"

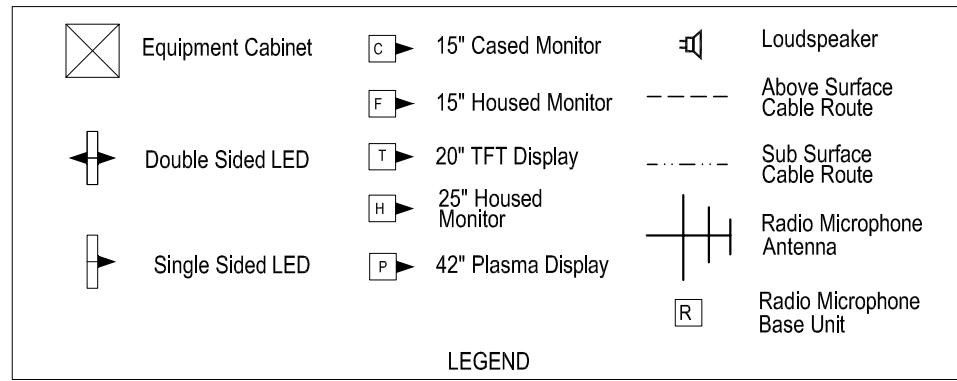

Equipment	Dist Board
EXISTING	
SUPPLIES USED	

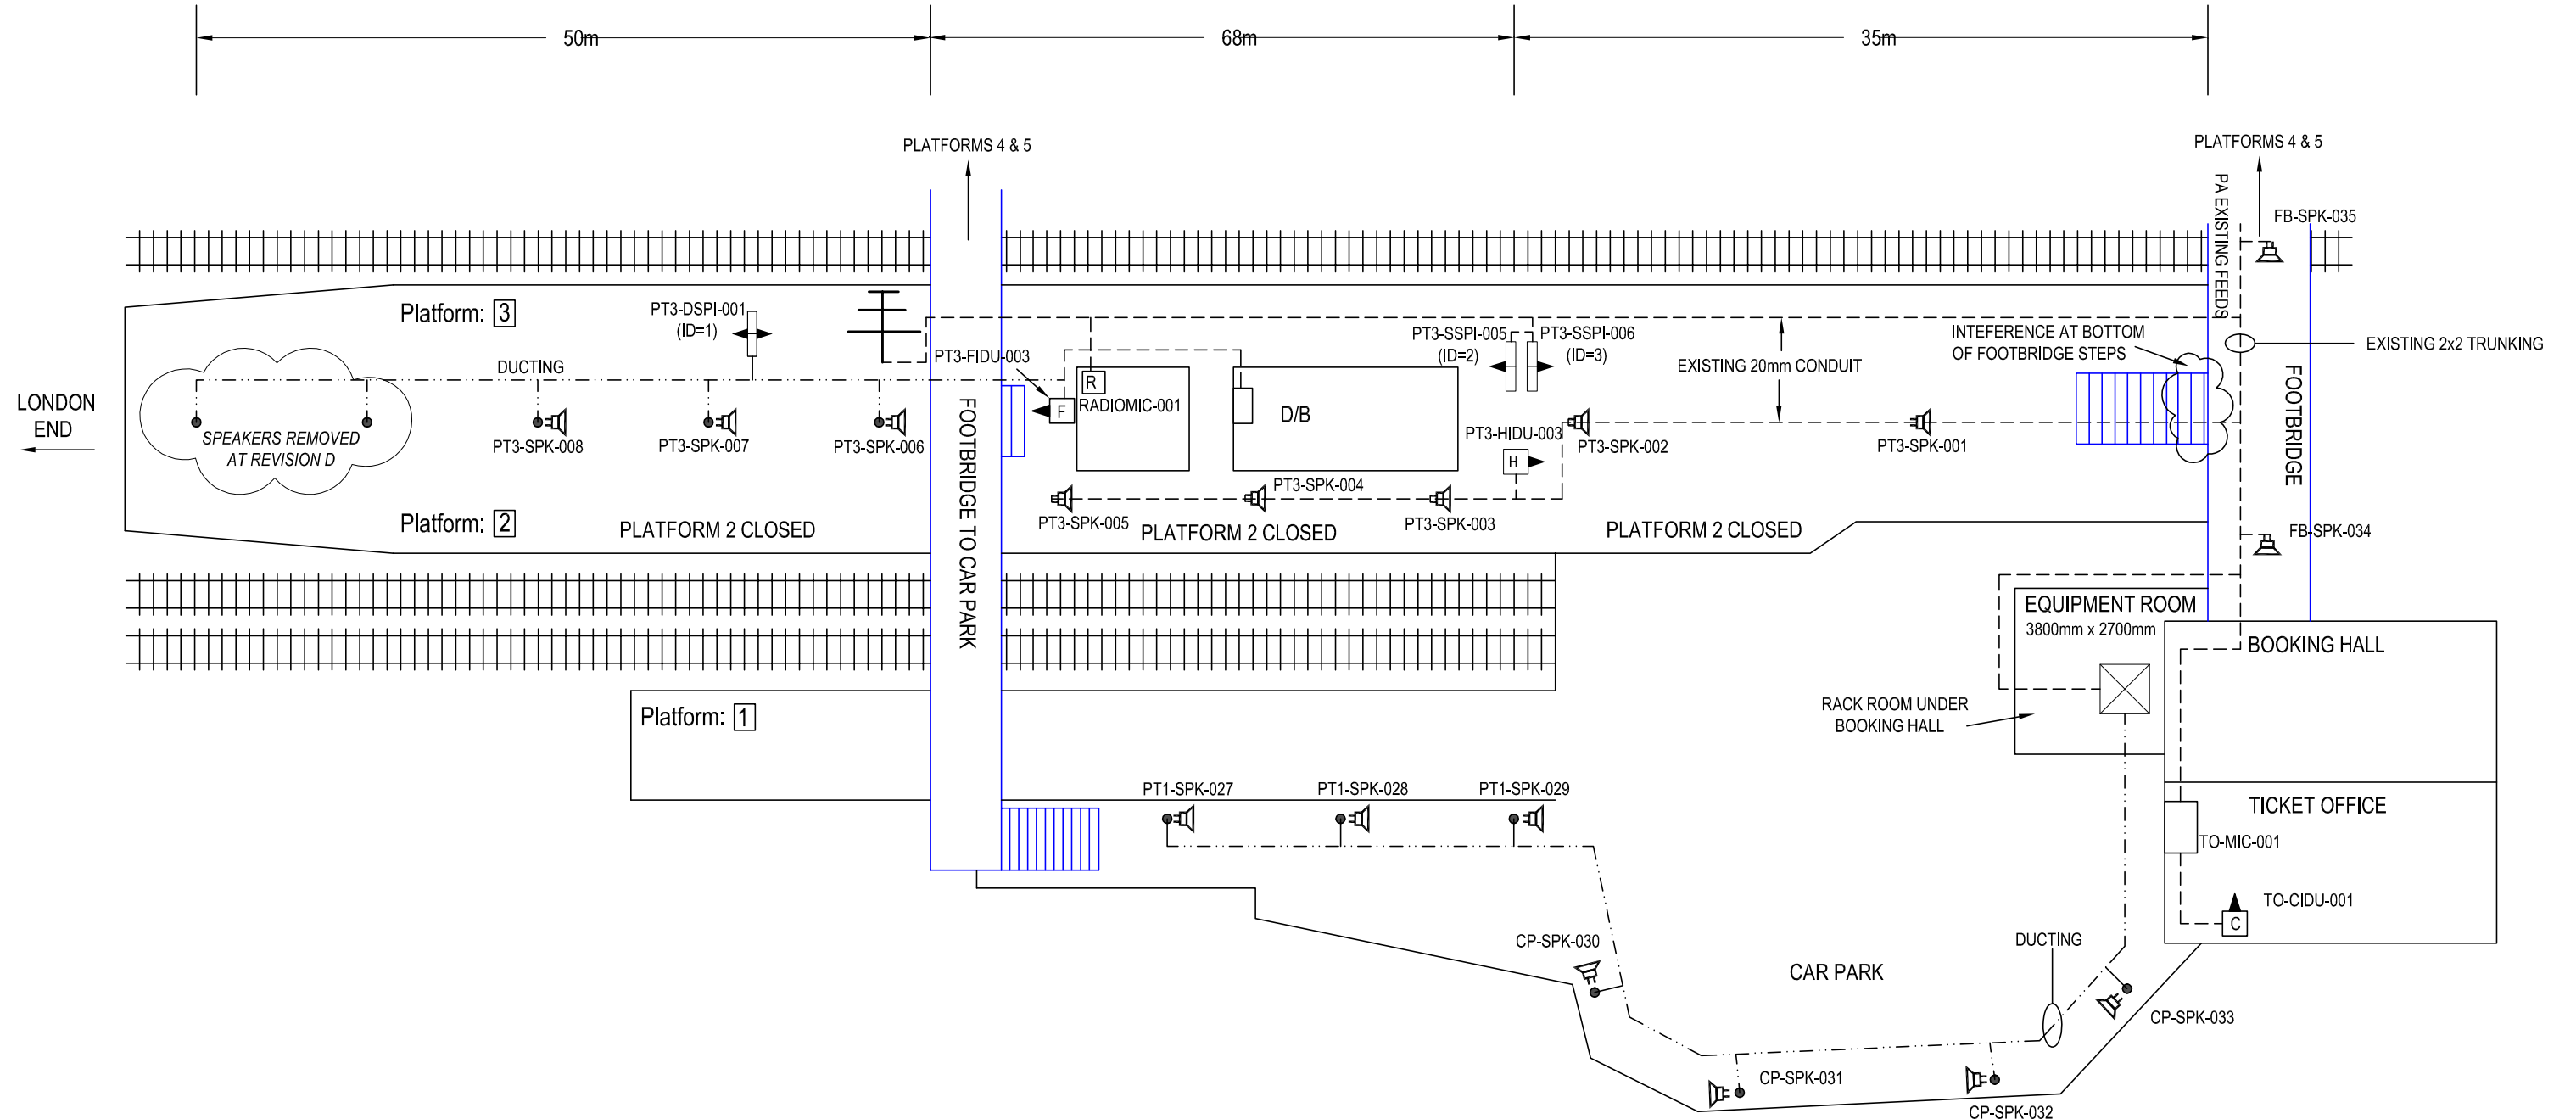

Date of Last Modification: 07 May 2004

This Drawing Supersedes Any Previous Drawings

CONSTRUCTION	NAME	SIGNATURE	DATE
DRAWN BY	C RAMSEY		07-05-2004
CHECKED BY	P JAMES		07-05-2004
APPD BY	A WILLIAMS		07-05-2004
APPD BY			

AMEY DATTEL Project
 Offices
 1st Floor, Platform
 2/3
 Eastleigh Station
 Southampton Road
 Eastleigh
 Hants
 SO50 9FL

SITE/PROJECT	SOUTH WEST TRAINS CIS PROJECT		
TITLE	TWICKENHAM PLATFORMS 1, 2 & 3 AS BUILT		

FINISH

CAD Ref:	
CONTRACTOR'S Ref:	


COPYRIGHT © AMEY Rail
 All rights reserved. Neither this drawing or any of the information it contains may copied or communicated to third parties without the written permission of the copyright holder

SCALE	DRG No.	ISSUE	SHEET
NTS	SM803-75574	D	1 of 2


WAN	
CIRCUIT ID	KXIP600414
IP ADDRESS	10.227.113.1

"PLATFORM 3 HP ISDN"	020-8744-9746
"PLATFORM 5 HP ISDN"	020-8744-9789

All Equipment tags to be prefixed with "TWI-"

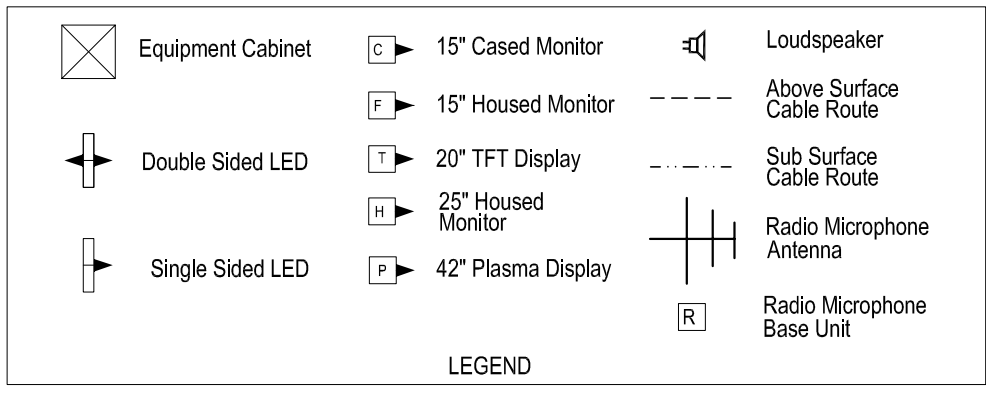

Equipment	Dist Board	
EXISTING		
SUPPLIES USED		

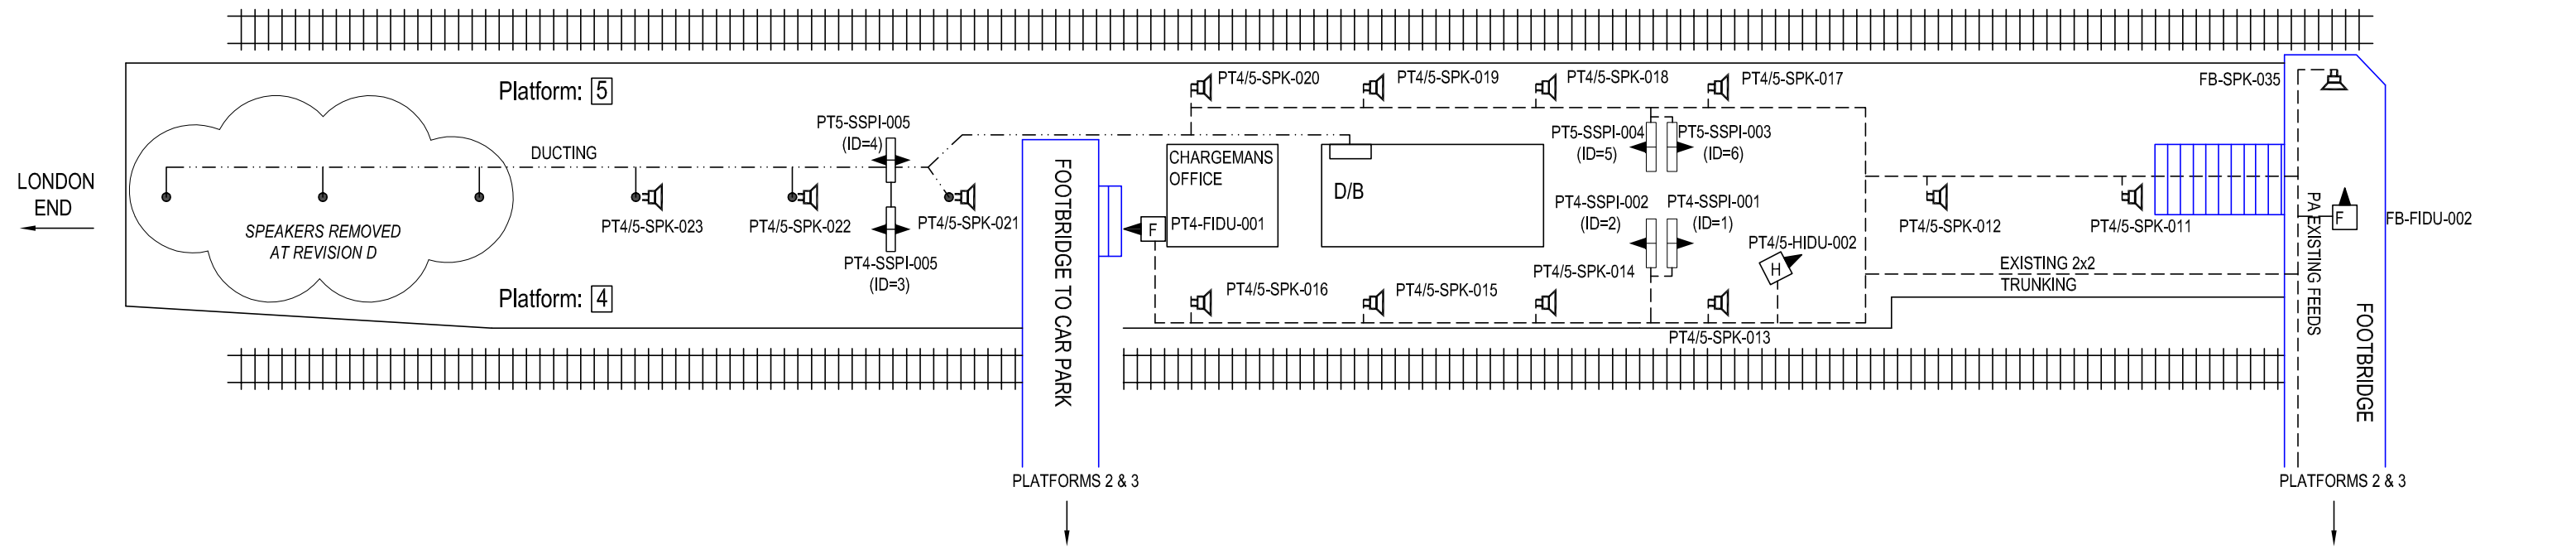

IF IN DOUBT ASK!

Date of Last Modification: 07 May 2004
 This Drawing Supersedes Any Previous Drawings

CONSTRUCTION	NAME	SIGNATURE	DATE
DRAWN BY	C RAMSEY		07-05-2004
CHECKED BY	P JAMES		07-05-2004
APPD BY	A WILLIAMS		07-05-2004
APPD BY			



AMEY DATEL Project
 Offices
 1st Floor, Platform
 2/3
 Eastleigh Station
 Southampton Road
 Eastleigh
 Hants
 SO50 9FL

SITE/PROJECT: SOUTH WEST TRAINS CIS PROJECT

TITLE: TWICKENHAM PLATFORMS 4 & 5 AS BUILT

FINISH

CAD Ref:	
CONTRACTOR'S Ref:	

COPYRIGHT © AMEY Rail
 All rights reserved. Neither this drawing or any of the information it contains may be copied or communicated to third parties without the written permission of the copyright holder

SCALE: NTS	DRG No. SM803-75574	ISSUE: D	SHEET: 2 of 2
------------	---------------------	----------	---------------