



WAN	
CIRCUIT ID	KXIP600415
IP ADDRESS	10.227.218.1

"PLATFORM 1 HP ISDN"
01-932-783037
"PLATFORM 2 HP ISDN"
01-932-783069

All Equipment tags to be prefixed with "UPH-"

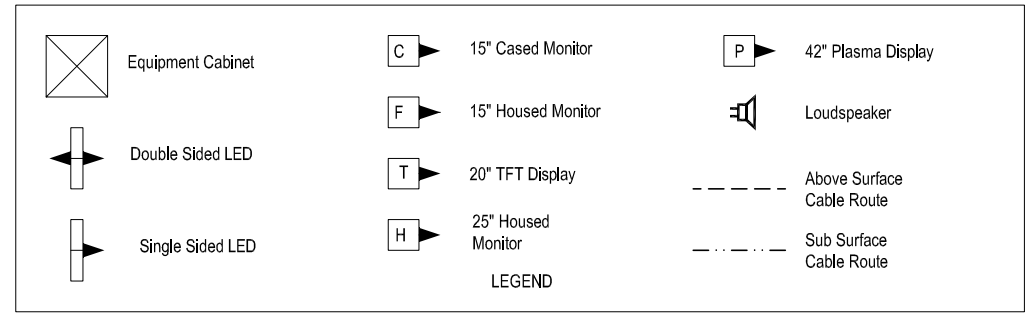

Equipment	Dist Board	
PT1-DSPI-001	LP 1	CCT 6
PT2-DSPI-002	LP 1	CCT 6

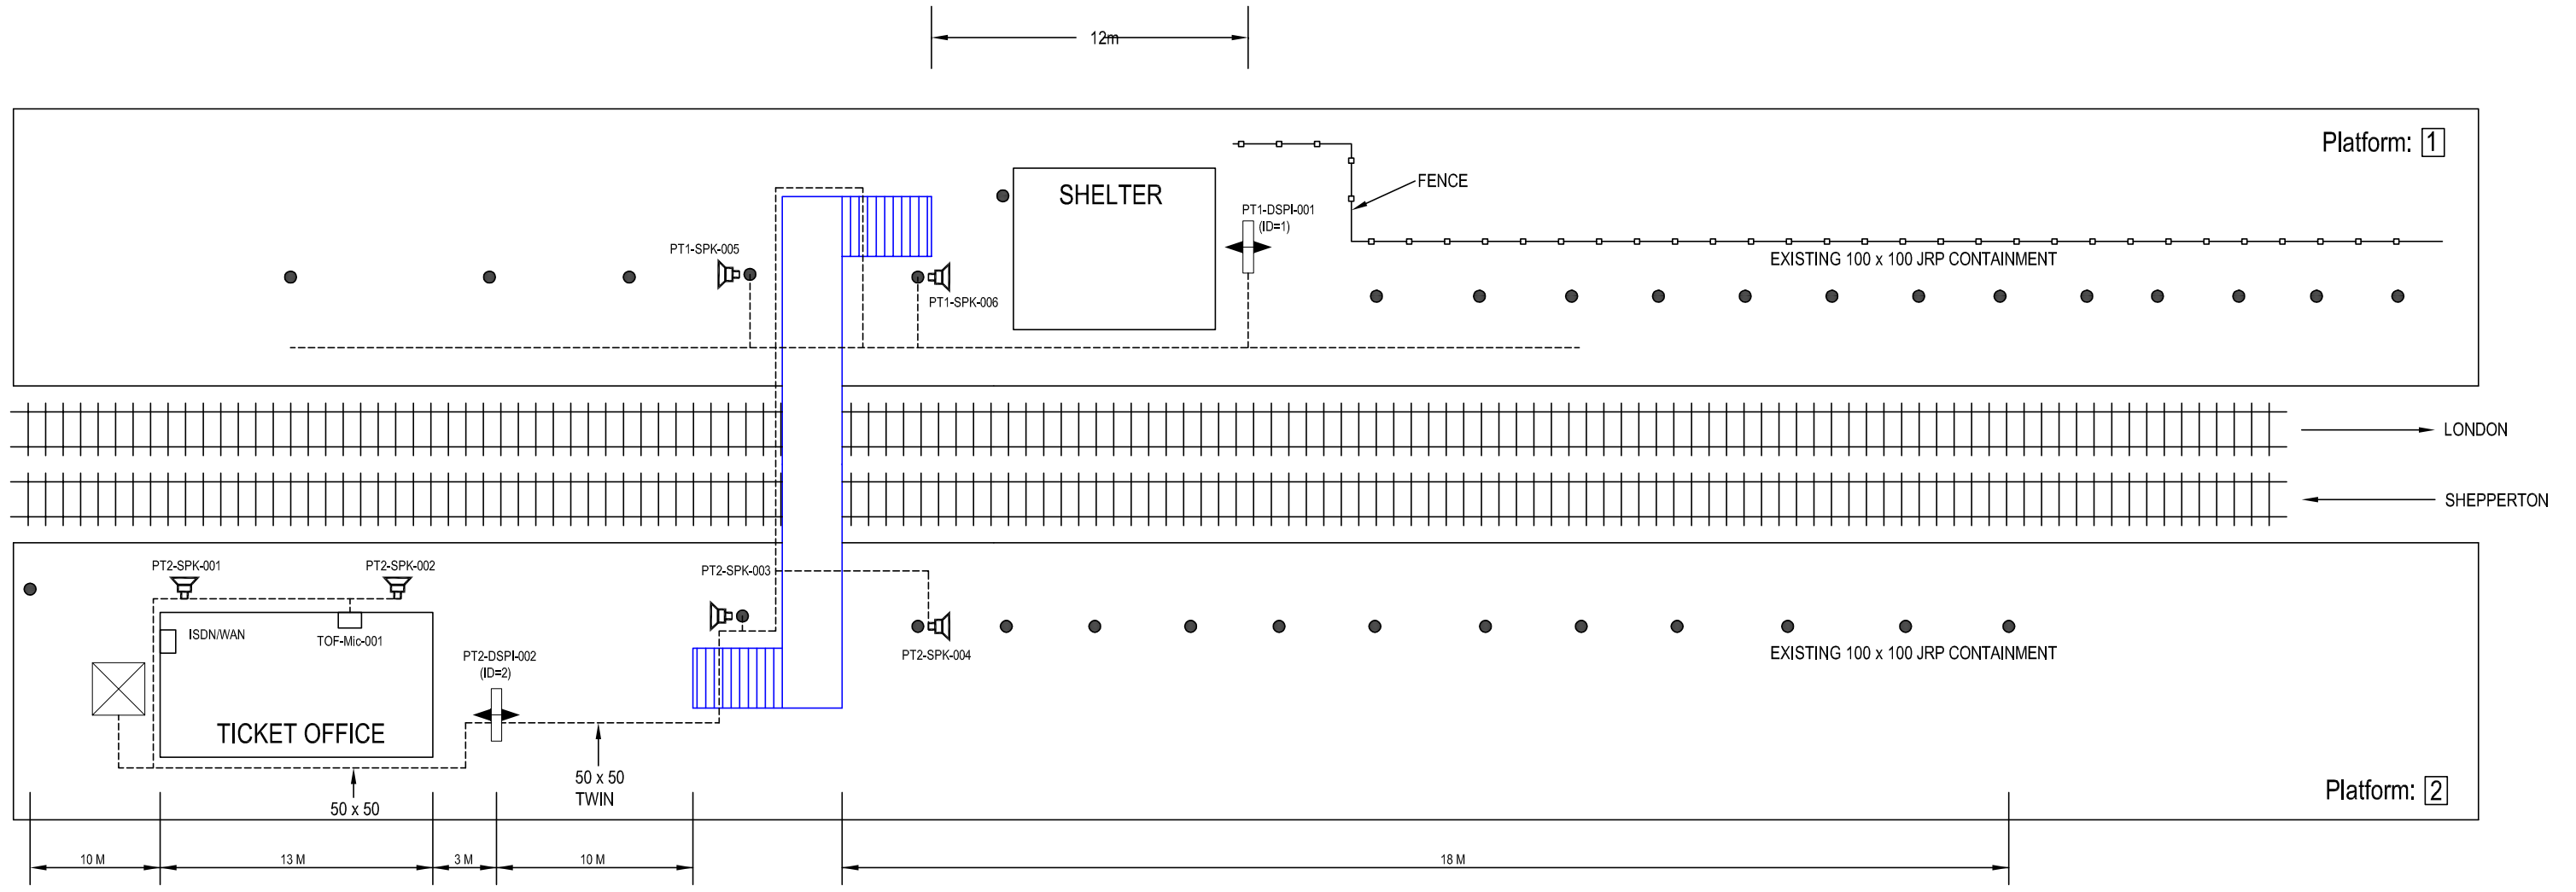

IF IN DOUBT ASK!

MATERIAL	CONSTRUCTION	DRAWN BY	D GADDU	SIGNATURE		AMEY DATEL Project Offices 1st Floor, Platform 2/3 Eastleigh Station Southampton Road Eastleigh Hants SO50 9FL	SITE/PROJECT		SOUTH WEST TRAINS CIS PROJECT	
		CHECKED BY	T WONG	DATE	23/06/2002		TITLE		UPPER HALLIFORD AS BUILT	
FINISH		APPD BY	A SMITH			COPYRIGHT © AMEY Rail All rights reserved. Neither this drawing or any of the information it contains may copied or communicated to third parties without the written permission of the copyright holder	SCALE	DRG No.	ISSUE	SHEET
		CAD Ref:					NTS	SM803-75613	B	1 of 1
		CONTRACTOR'S Ref:								