



WAN	
CIRCUIT ID	KXIP 100404
IP ADDRESS	10.227.219.1

"PLATFORM 1 HP ISDN"
01-305-815351
"PLATFORM 2 HP ISDN"
01-305-815352

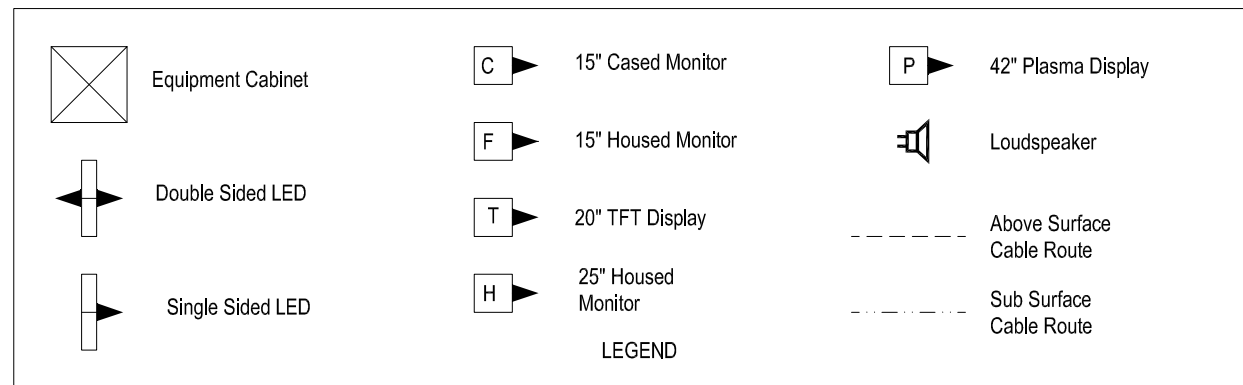

Equipment	Dist Board
CCT BRK 1	CIS
CCT BRK 2	LED
CCT BRK 3	LED

All Equipment tags to be prefixed with "UPW-"

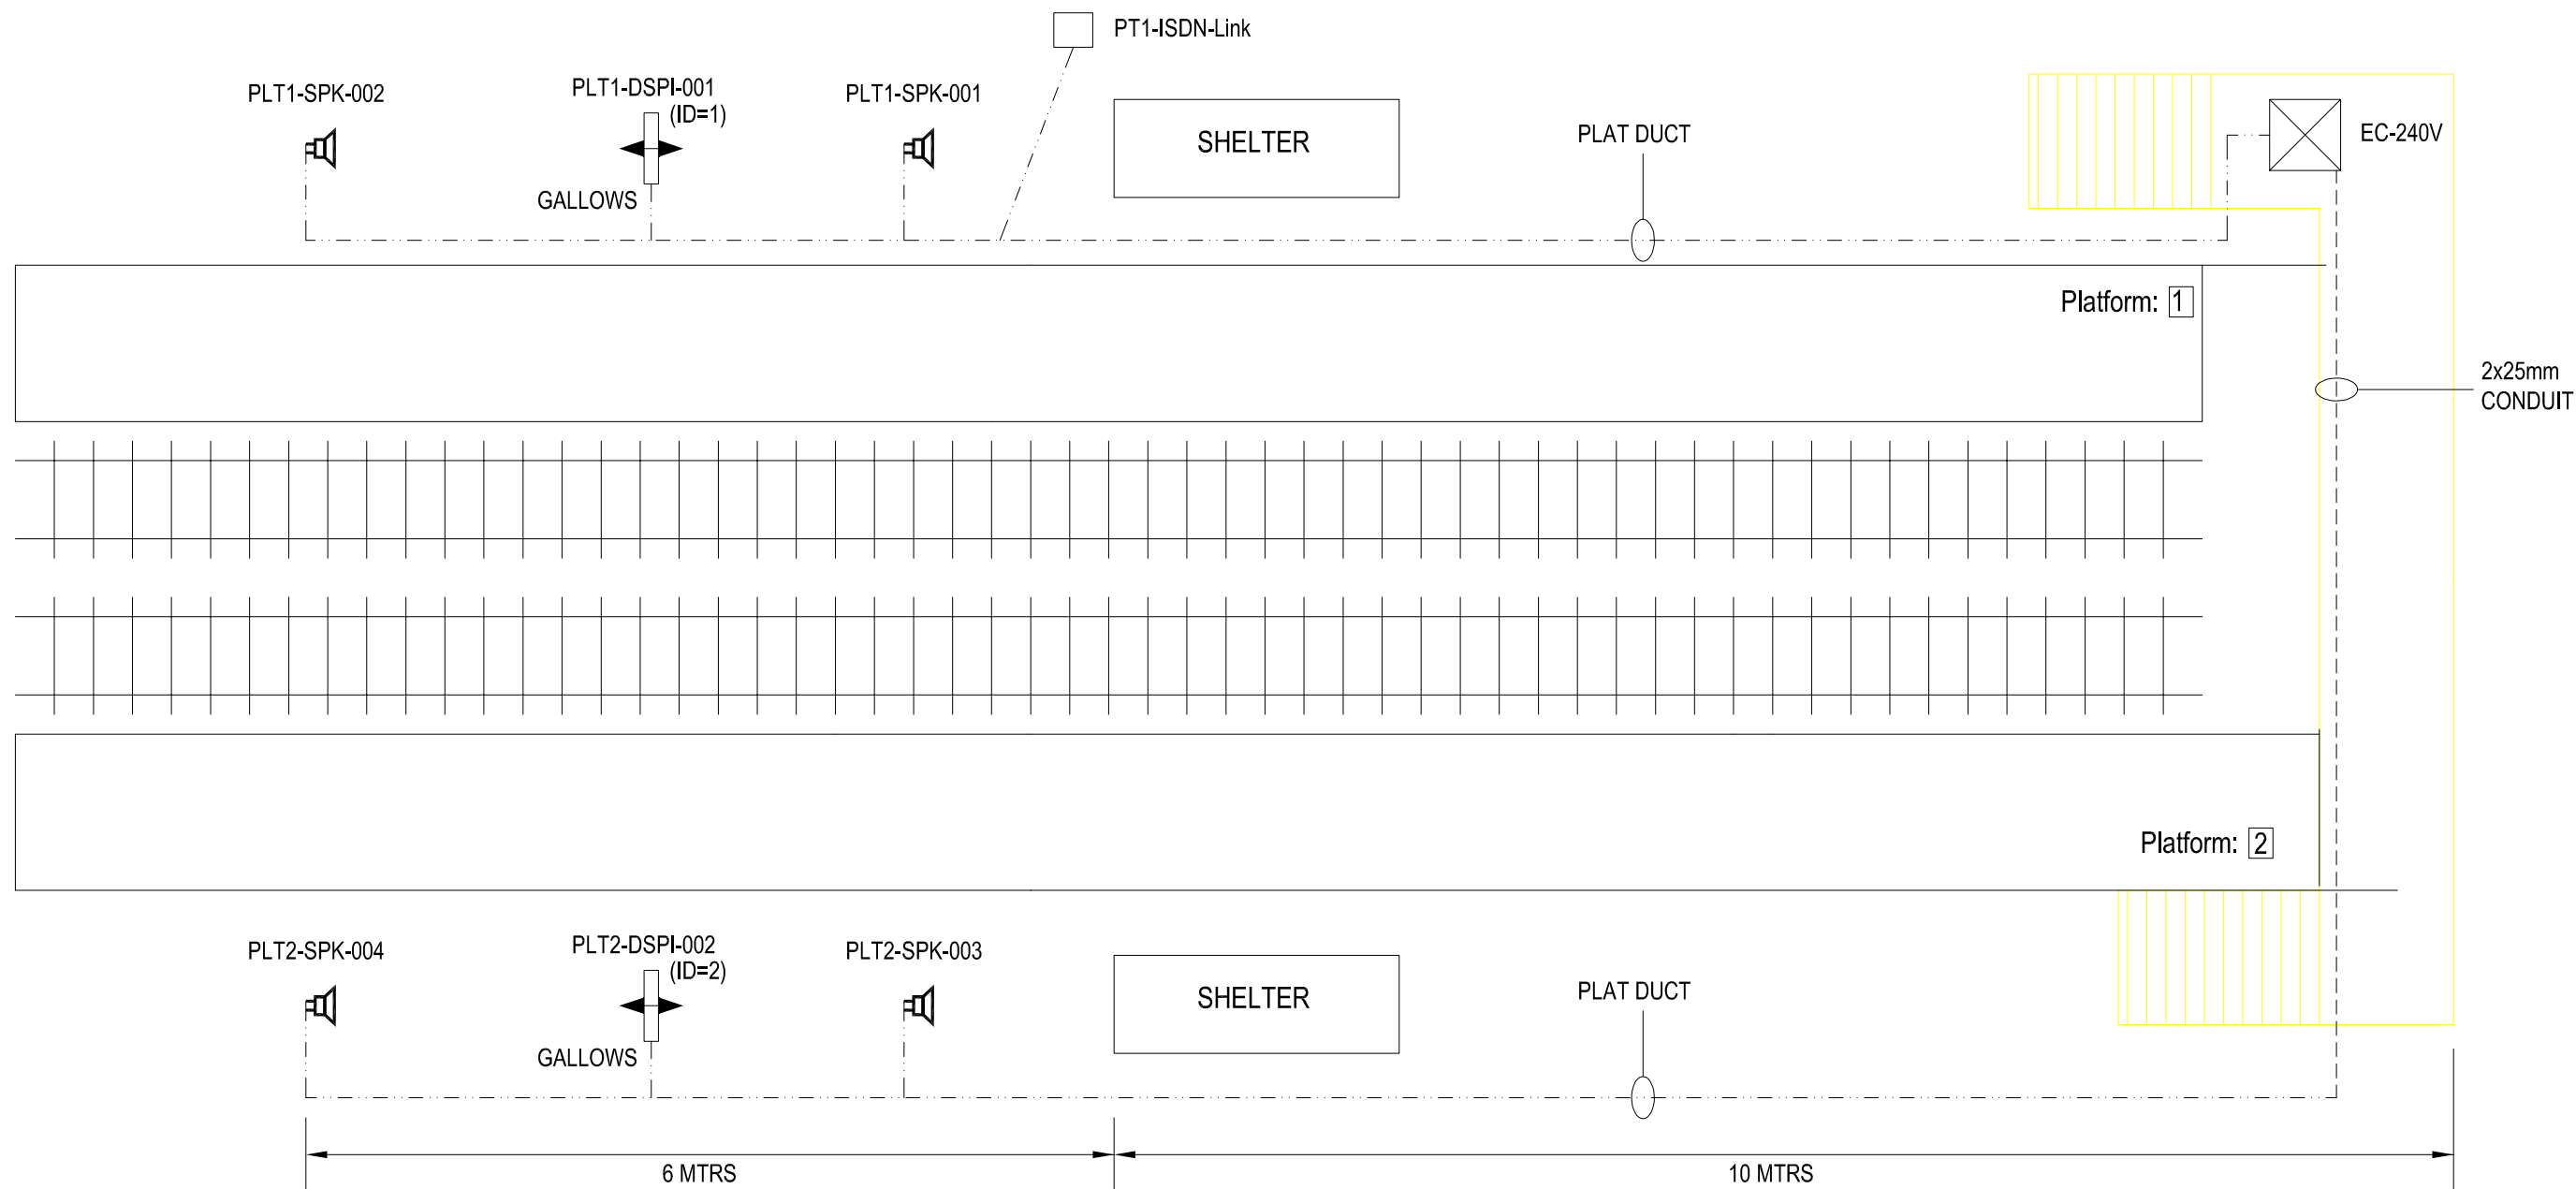

MATERIAL	CONSTRUCTION
----------	--------------

	NAME	SIGNATURE	DATE
DRAWN BY	D GADDU		22-01-2002
CHECKED BY	T WONG		
APPD BY			
APPD BY			

AMEY DATEL Project  
 Offices  
 1st Floor, Platform  
 2/3  
 Eastleigh Station  
 Southampton Road  
 Eastleigh  
 Hants  
 SO50 9FL

SITE/PROJECT  
 SOUTH WEST TRAINS CIS PROJECT

TITLE  
 UPWEY  
 AS BUILT

FINISH
--------

CAD Ref:
CONTRACTOR'S Ref:

COPYRIGHT © AMEY Rail  
 All rights reserved. Neither this drawing or any of the information it contains may be copied or communicated to third parties without the written permission of the copyright holder

SCALE	DRG No.	ISSUE	SHEET
NTS	SM803-75967	B	1 of 1