




WAN	
CIRCUIT ID	10.227.220.1
IP ADDRESS	KXIP600416

All Equipment tags to be prefixed with "VXH-"

"PLATFORM 1 HP ISDN"	020-7582-0719
"PLATFORM 3 HP ISDN"	020-7582-0768
"PLATFORM 5 HP ISDN"	020-7582-0823
"PLATFORM 7 HP ISDN"	020-7582-0906

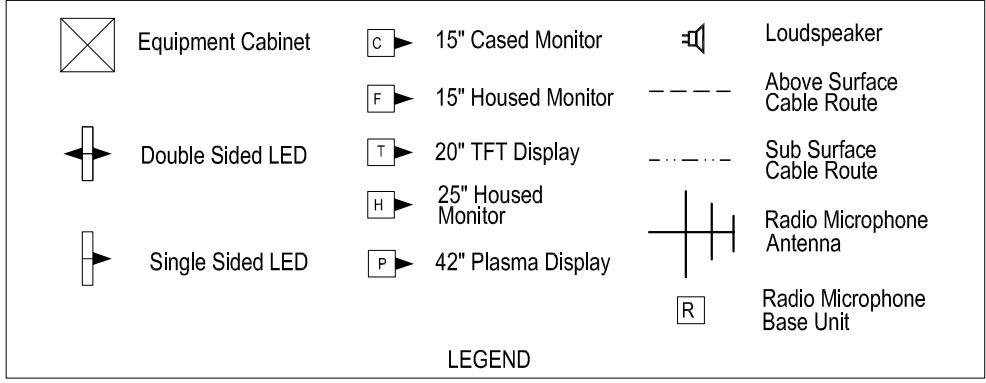

Equipment	Dist Board	
TO-CIDU-009	TO DB1	C2
SUB-HIDU-001	DB01A	C2
SUB-HIDU-002	DB01A	C2
SUB-HIDU-003	DB01A	C2
SUB-HIDU-004	DB01A	C2
SUB-HIDU-005	DB01A	C2
SUB-HIDU-006	DB01A	C2

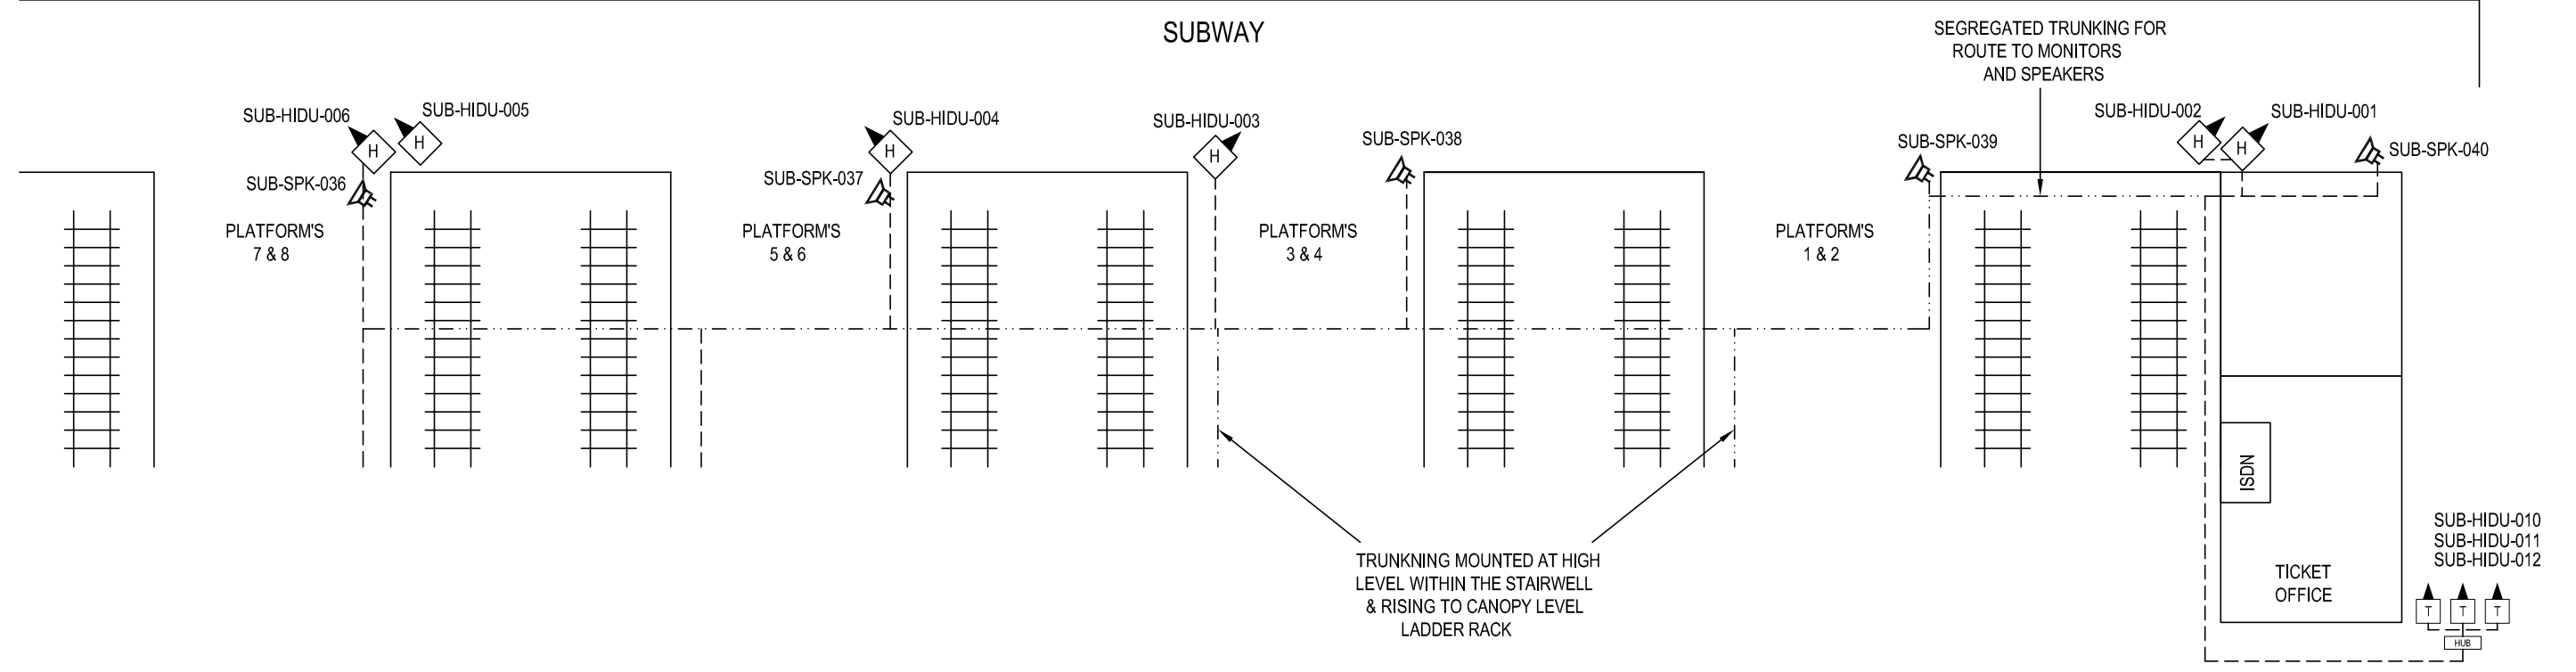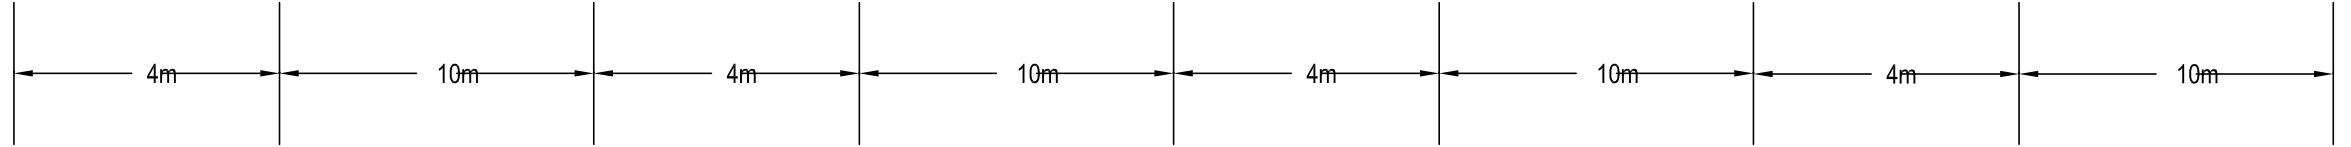

IF IN DOUBT ASK!

Date of Last Modification: 25 April 2003

This Drawing Supersedes Any Previous Drawings

CONSTRUCTION	NAME	SIGNATURE	DATE
DRAWN BY	J STEVENS		25-04-2003
CHECKED BY	T WONG		
APPD BY	A SMITH		
APPD BY			

AMEY DATEL Project Offices
1st Floor, Platform 2/3
Eastleigh Station
Southampton Road
Eastleigh
Hants
SO50 9FL

SITE/PROJECT		SOUTH WEST TRAINS CIS PROJECT	
TITLE		VAUXHALL AS BUILT	

FINISH

CAD Ref:	
CONTRACTOR'S Ref:	


COPYRIGHT © AMEY Rail
All rights reserved. Neither this drawing or any of the information it contains may be copied or communicated to third parties without the written permission of the copyright holder

SCALE	DRG No.	ISSUE	SHEET
NTS	SM803-75597	D	1 of 5


WAN	
CIRCUIT ID	10.227.220.1
IP ADDRESS	KXIP600416

"PLATFORM 1 HP ISDN"	020-7582-0719
"PLATFORM 3 HP ISDN"	020-7582-0768
"PLATFORM 5 HP ISDN"	020-7582-0823
"PLATFORM 7 HP ISDN"	020-7582-0906

All Equipment tags to be prefixed with "VXH-"

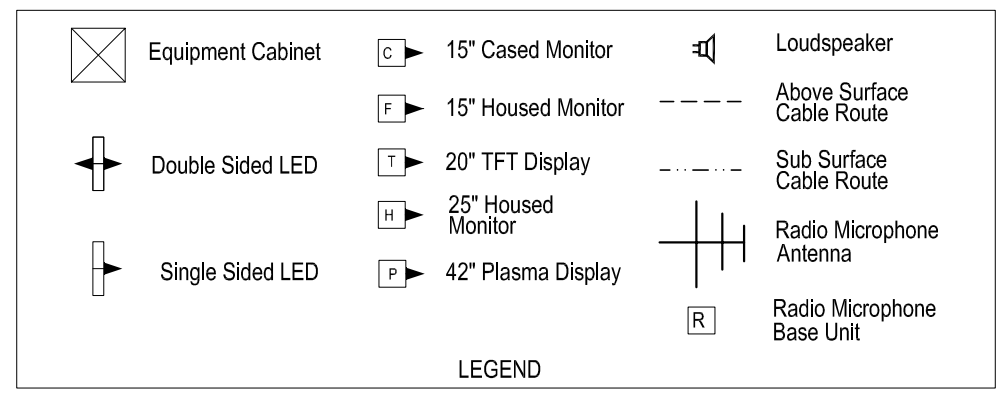

Equipment	Dist Board
EXISTING SUPPLIES USED	

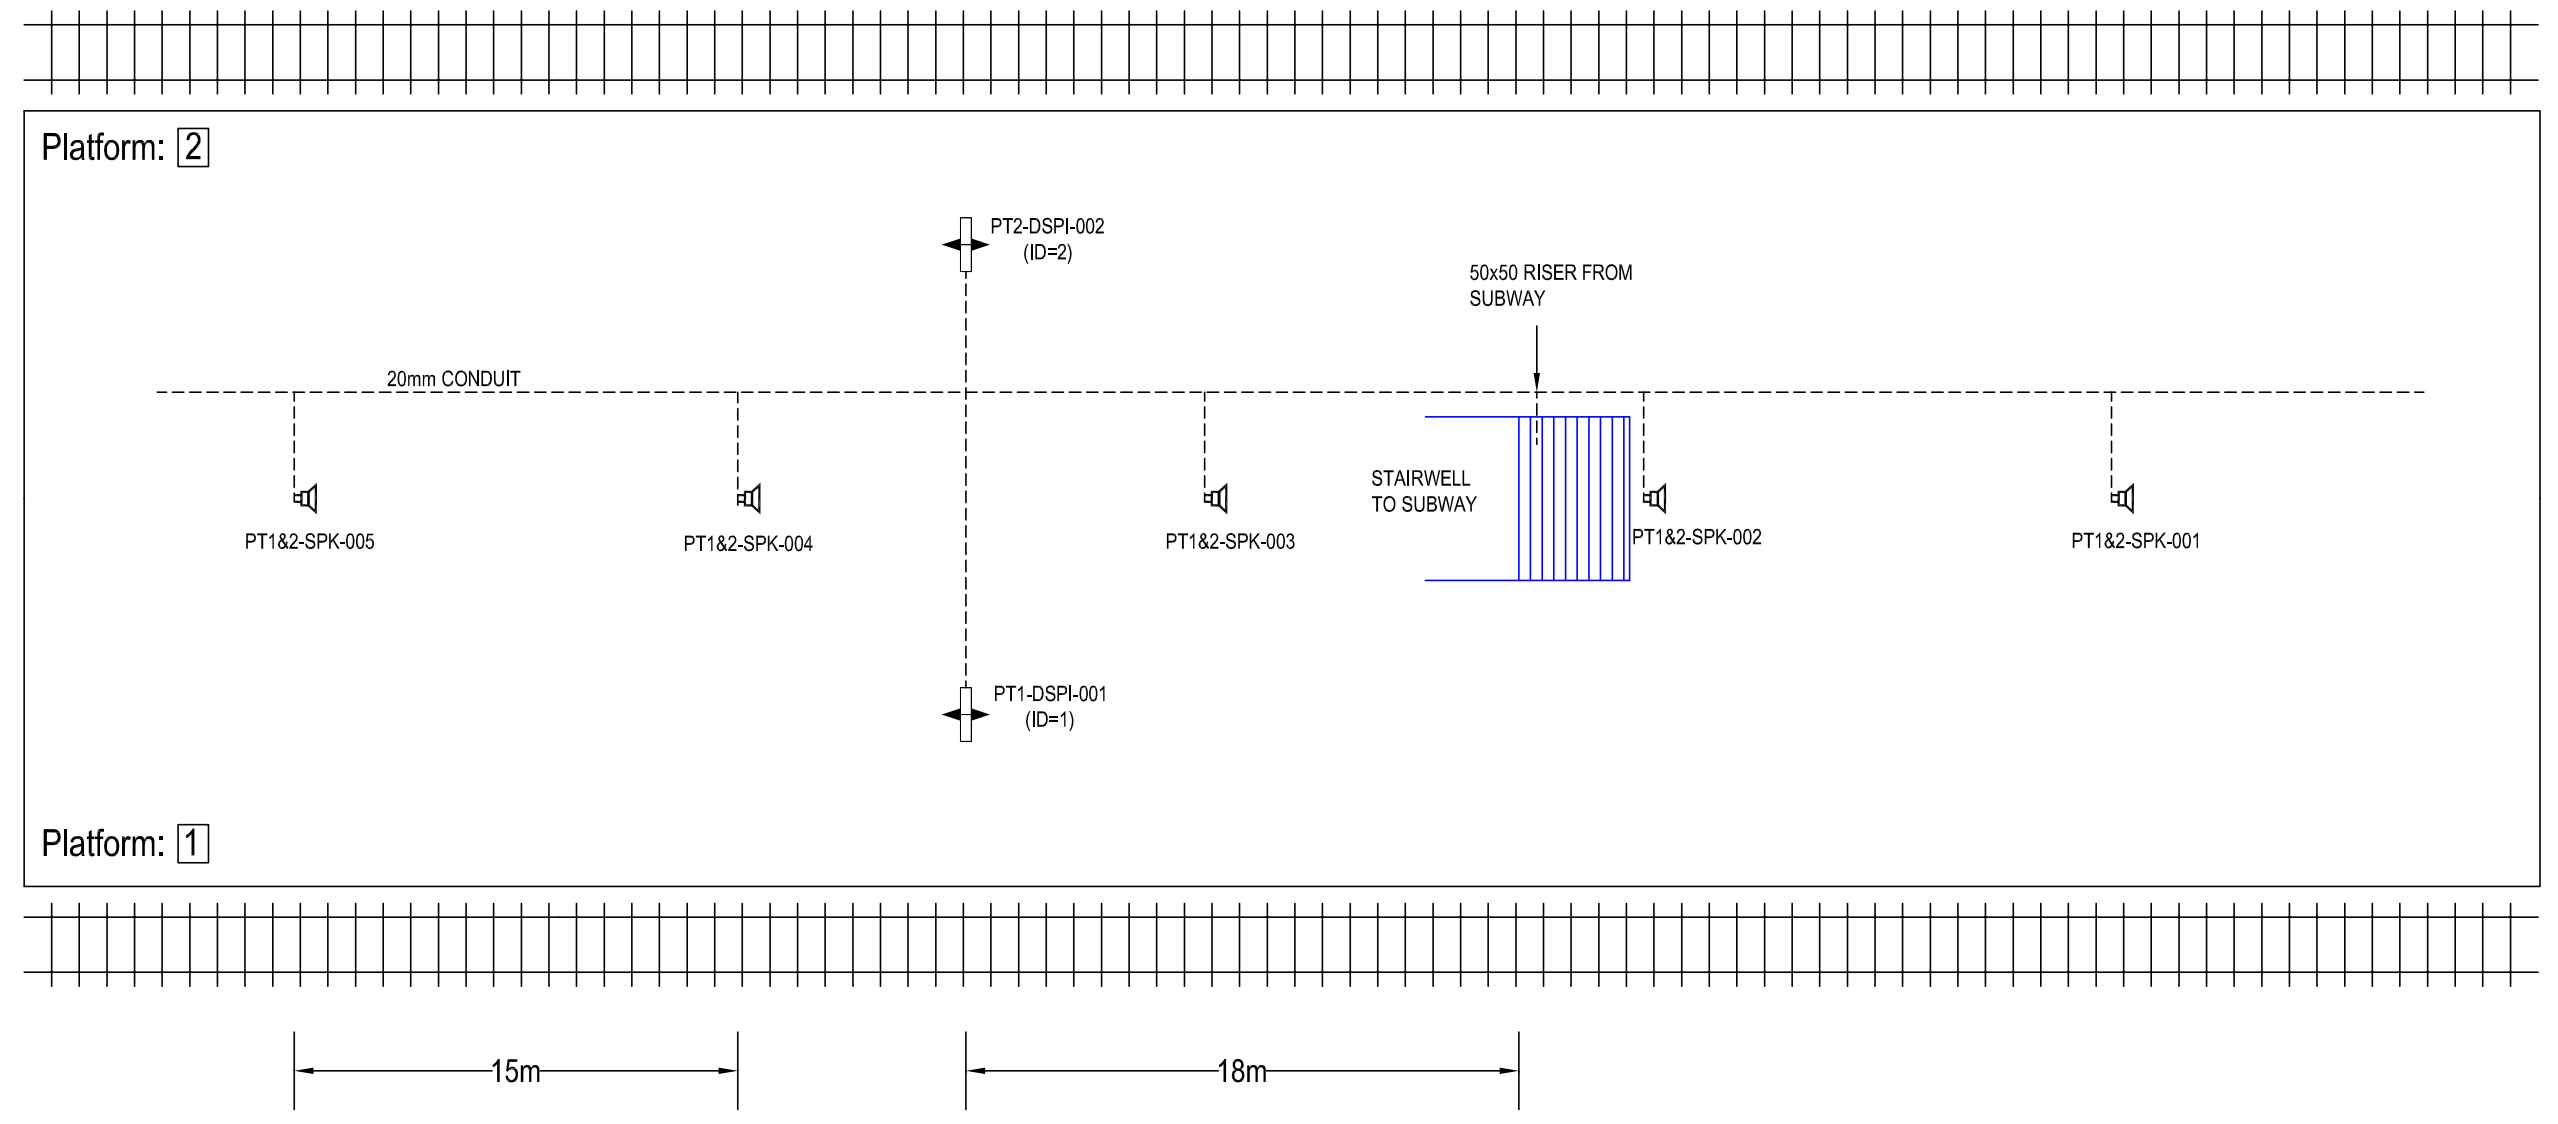

Date of Last Modification: 24 June 2003
 This Drawing Supersedes Any Previous Drawings

CONSTRUCTION	NAME	J STEVENS	SIGNATURE	J STEVENS	DATE	25-04-2003
	DRAWN BY	J STEVENS	CHECKED BY	T WONG	DATE	25-04-2003
	APPD BY	A SMITH	APPD BY			
	CAD Ref:					
	CONTRACTOR'S Ref:					

AMEY DATEL Project
 Offices
 1st Floor, Platform
 2/3
 Eastleigh Station
 Southampton Road
 Eastleigh
 Hants
 SO50 9FL

amey


COPYRIGHT © AMEY Rail
 All rights reserved. Neither this drawing or any of the information it contains may be copied or communicated to third parties without the written permission of the copyright holder

SITE/PROJECT		SOUTH WEST TRAINS CIS PROJECT	
TITLE		VAUXHALL AS BUILT	
SCALE	DRG No.	ISSUE	SHEET
NTS	SM803-75597	D	2 of 5



WAN	
CIRCUIT ID	10.227.220.1
IP ADDRESS	KXIP600416

"PLATFORM 1 HP ISDN"	020-7582-0719
"PLATFORM 3 HP ISDN"	020-7582-0768
"PLATFORM 5 HP ISDN"	020-7582-0823
"PLATFORM 7 HP ISDN"	020-7582-0906

All Equipment tags to be prefixed with "VXH-"

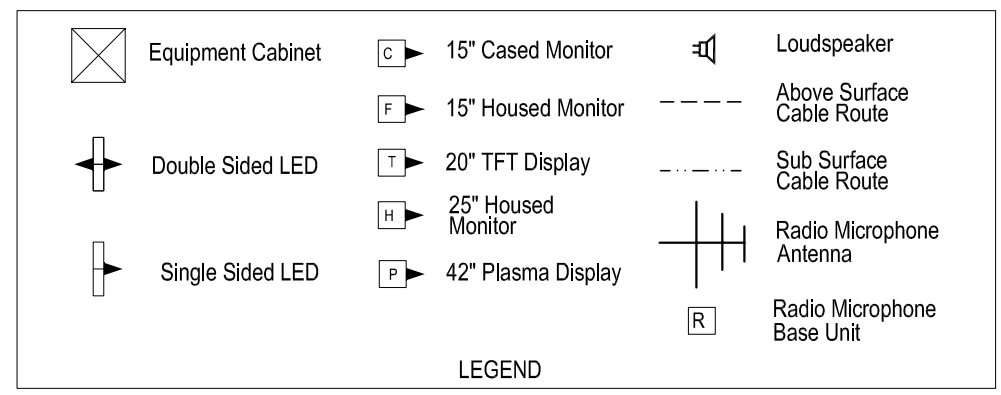

Equipment	Dist Board	
CIS RACK	S&T GP DB	C2
PT3-DSPI-003	EXISTING	
PT4-DSPI-004	EXISTING	

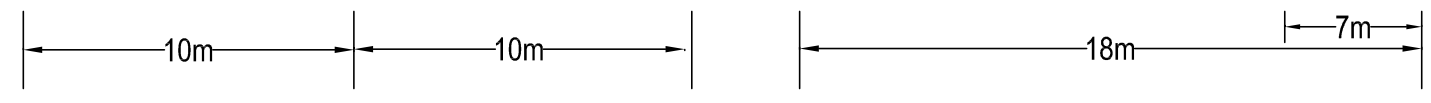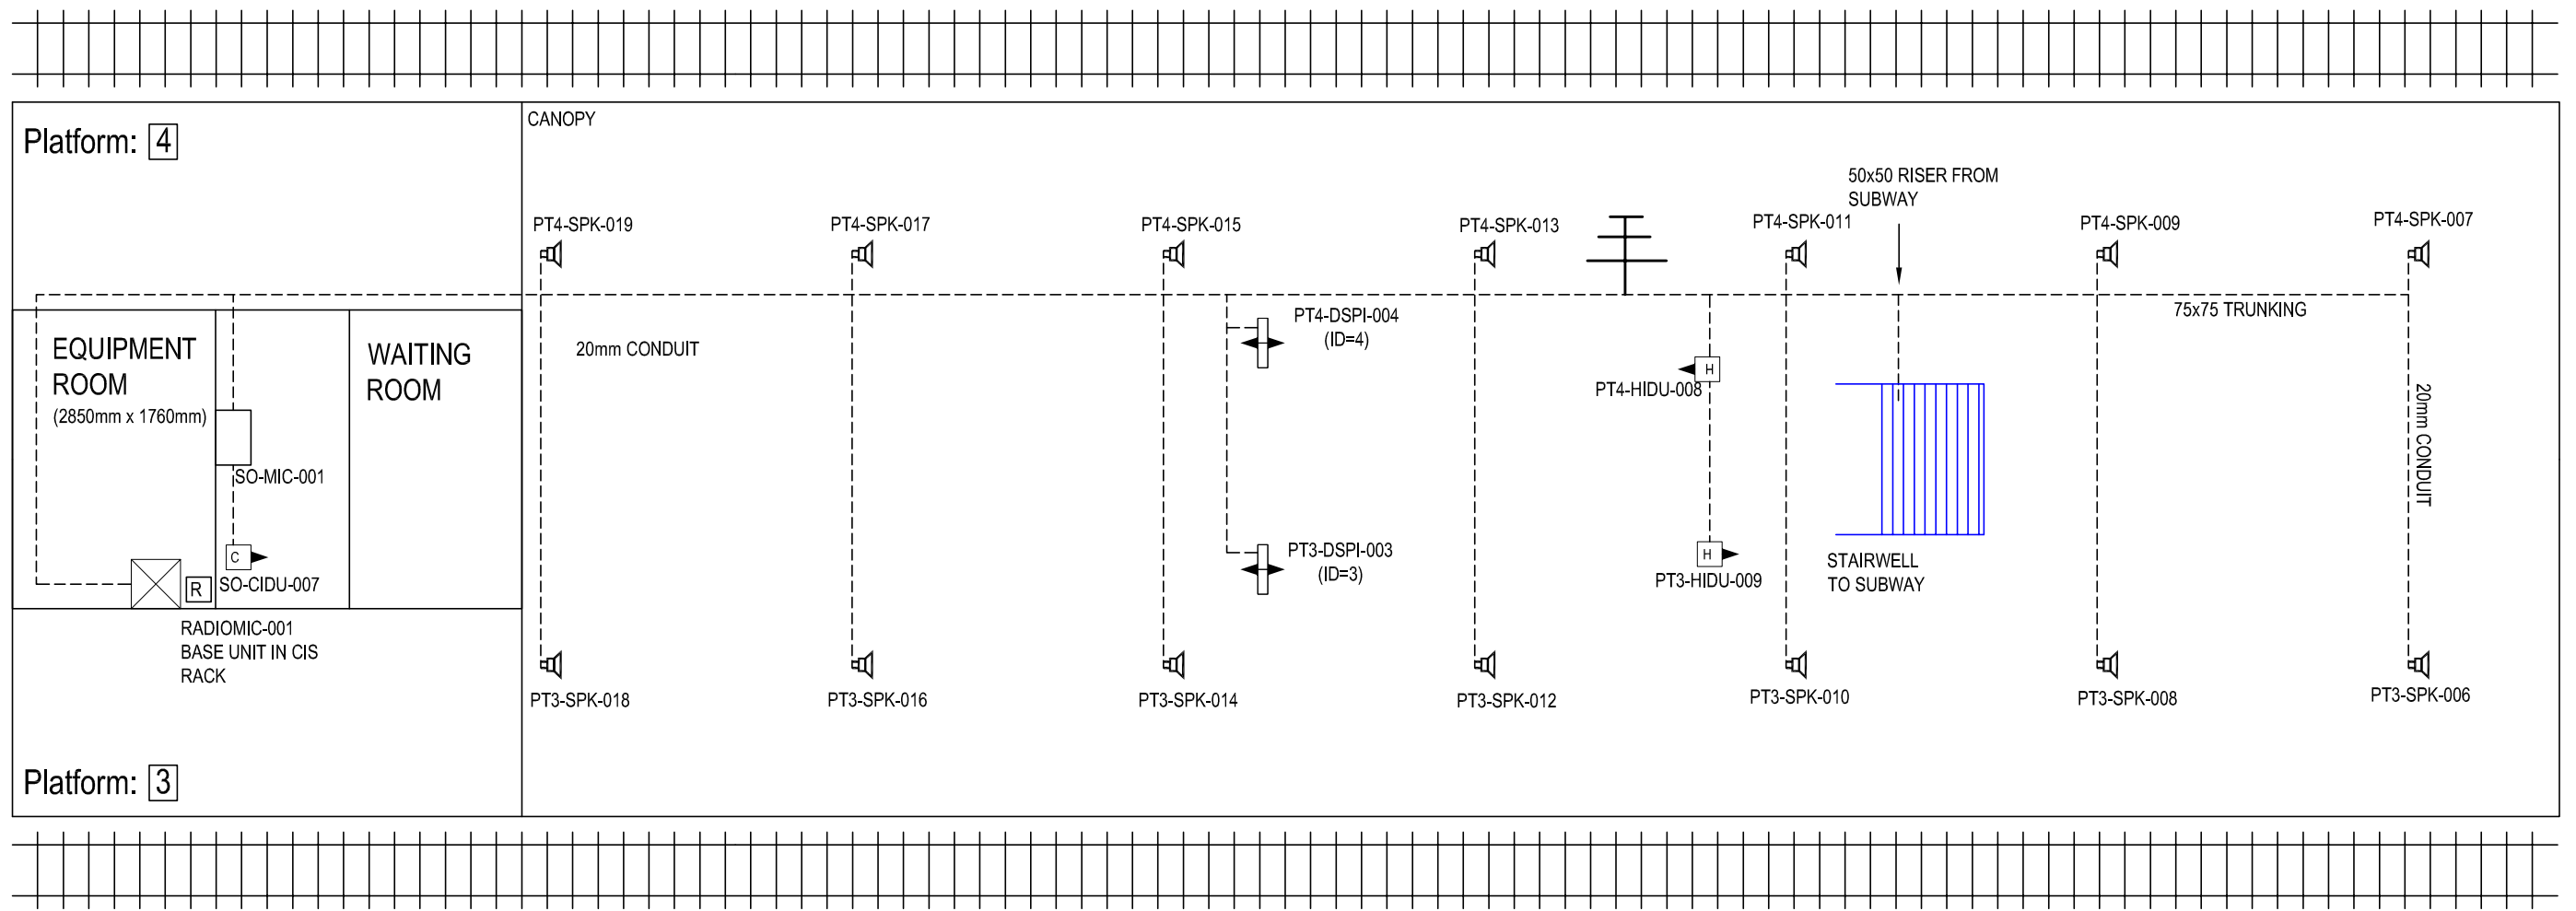

IF IN DOUBT ASK!

Date of Last Modification: 24 June 2003

This Drawing Supersedes Any Previous Drawings

CONSTRUCTION	NAME	SIGNATURE	DATE
DRAWN BY	J STEVENS	J STEVENS	25-04-2003
CHECKED BY	T WONG	T WONG	25-04-2003
APPD BY	A SMITH		
APPD BY			
CAD Ref:			
CONTRACTOR'S Ref:			

AMEY DATEL Project
Offices
1st Floor, Platform
2/3
Eastleigh Station
Southampton Road
Eastleigh
Hants
SO50 9FL


COPYRIGHT © AMEY Rail
All rights reserved. Neither this drawing or any of the information it contains may be copied or communicated to third parties without the written permission of the copyright holder

SITE/PROJECT		SOUTH WEST TRAINS CIS PROJECT	
TITLE		VAUXHALL AS BUILT	
SCALE	DRG No.	ISSUE	SHEET
NTS	SM803-75597	D	3 of 5




WAN	
CIRCUIT ID	10.227.220.1
IP ADDRESS	KXIP600416


"PLATFORM 1 HP ISDN"	020-7582-0719
"PLATFORM 3 HP ISDN"	020-7582-0768
"PLATFORM 5 HP ISDN"	020-7582-0823
"PLATFORM 7 HP ISDN"	020-7582-0906

All Equipment tags to be prefixed with "VXH-"

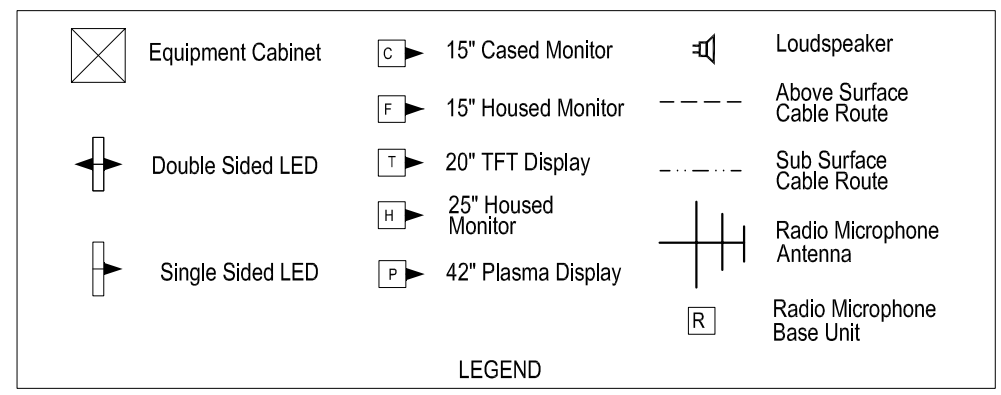

Equipment	Dist Board	
EXISTING SUPPLIES USED		

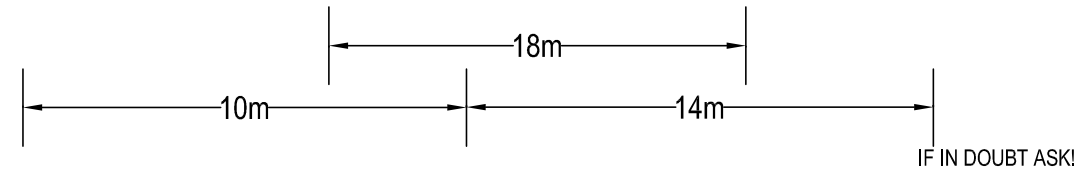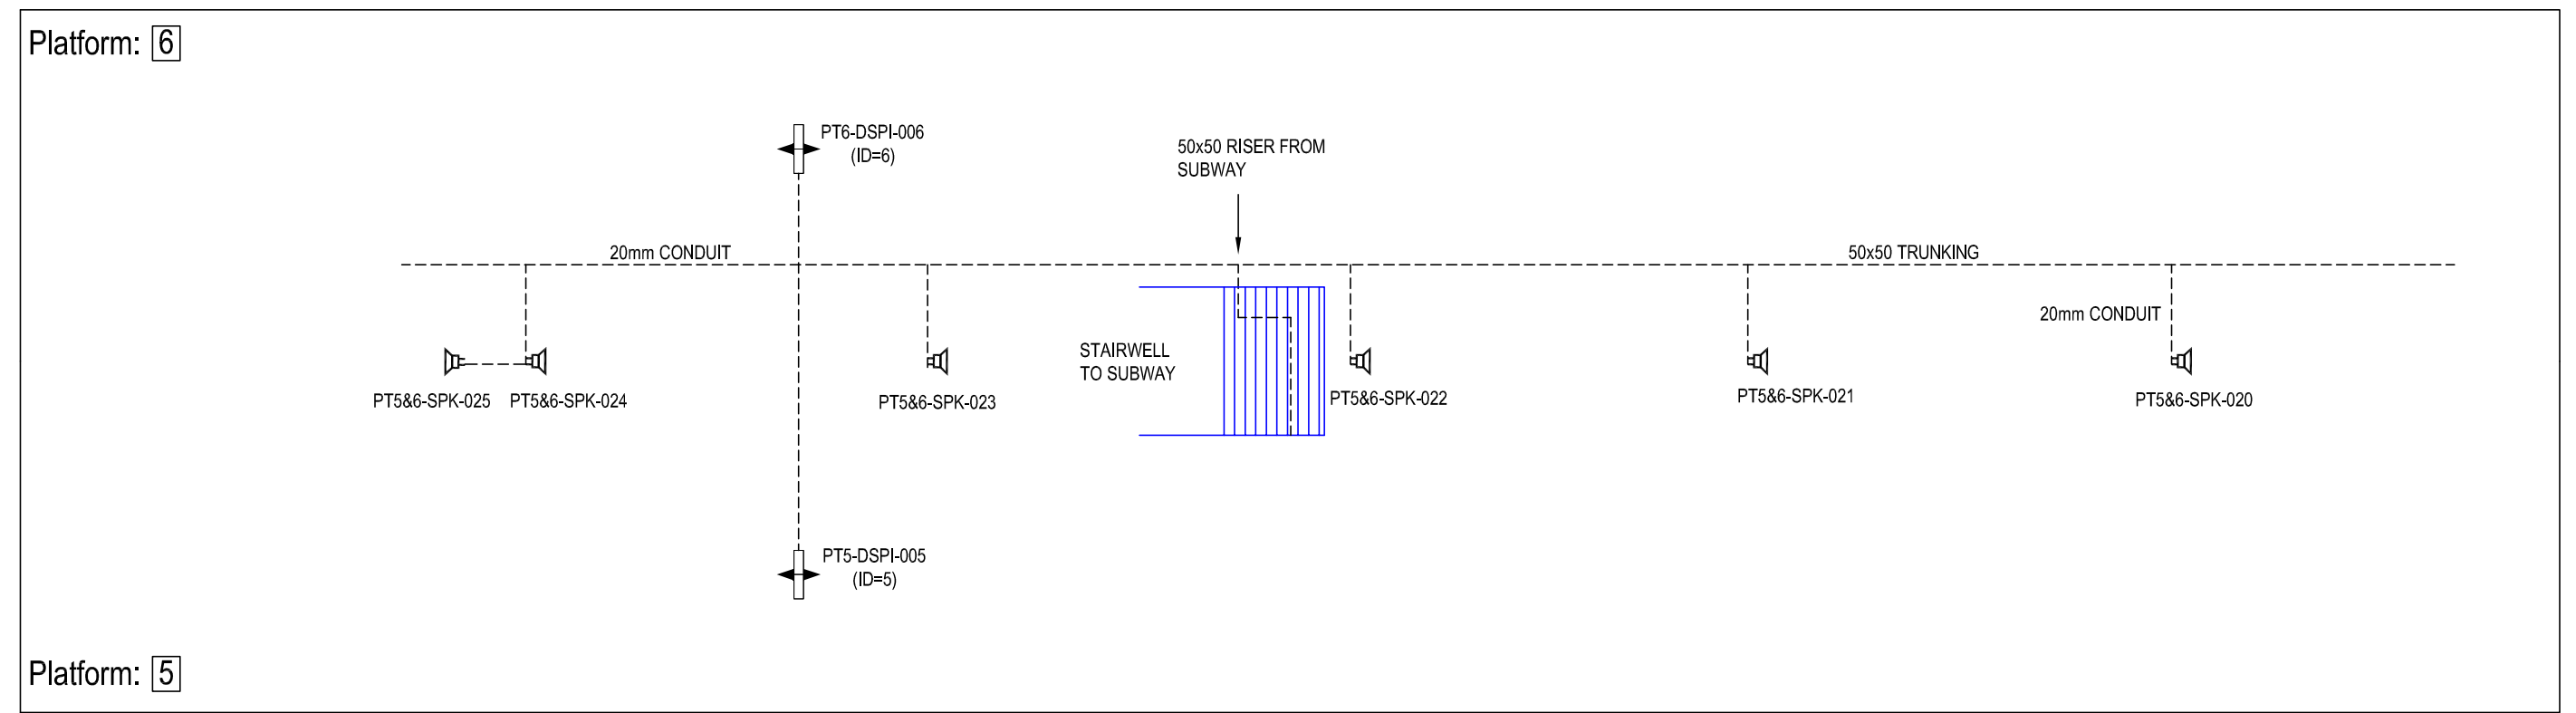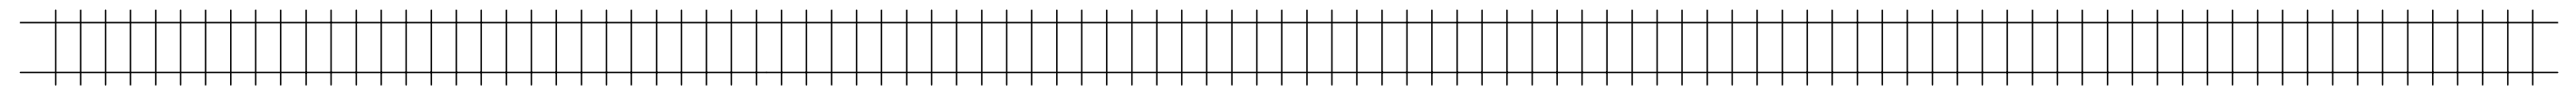


Date of Last Modification: 24 June 2003 This Drawing Supersedes Any Previous Drawings	CONSTRUCTION	NAME	SIGNATURE	DATE	 AMEY DATEL Project Offices 1st Floor, Platform 2/3 Eastleigh Station Southampton Road Eastleigh Hants SO50 9FL	SITE/PROJECT SOUTH WEST TRAINS CIS PROJECT			
		DRAWN BY: D GADDU	D GADDU	25-04-2003		TITLE VAUXHALL AS BUILT			
FINISH		CHECKED BY: T WONG	T WONG	25-04-2003	COPYRIGHT © AMEY Rail All rights reserved. Neither this drawing or any of the information it contains may be copied or communicated to third parties without the written permission of the copyright holder	SCALE NTS	DRG No. SM803-75597	ISSUE D	SHEET 4 of 5
		APPD BY: A SMITH							
		CAD Ref:							
		CONTRACTOR'S Ref:							





WAN	
CIRCUIT ID	10.227.220.1
IP ADDRESS	KXIP600416

"PLATFORM 1 HP ISDN"	020-7582-0719
"PLATFORM 3 HP ISDN"	020-7582-0768
"PLATFORM 5 HP ISDN"	020-7582-0823
"PLATFORM 7 HP ISDN"	020-7582-0906

All Equipment tags to be prefixed with "VXH-"

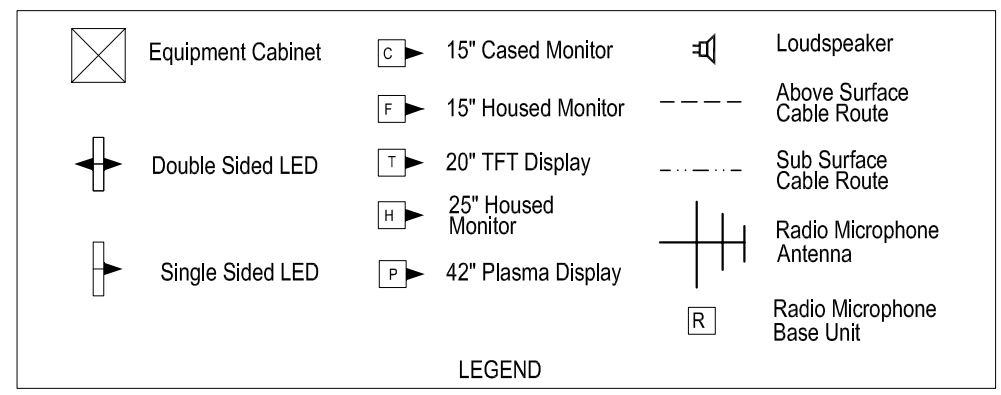

Equipment	Dist Board
EXISTING SUPPLIES	

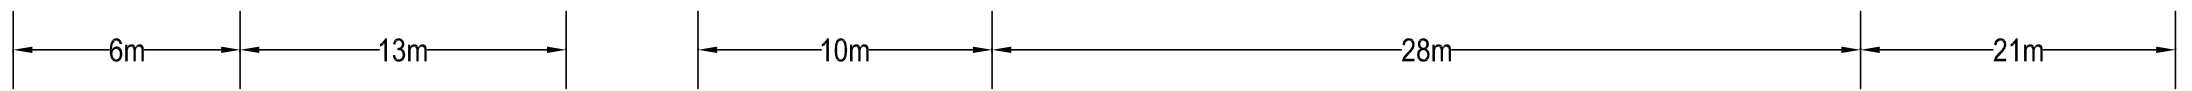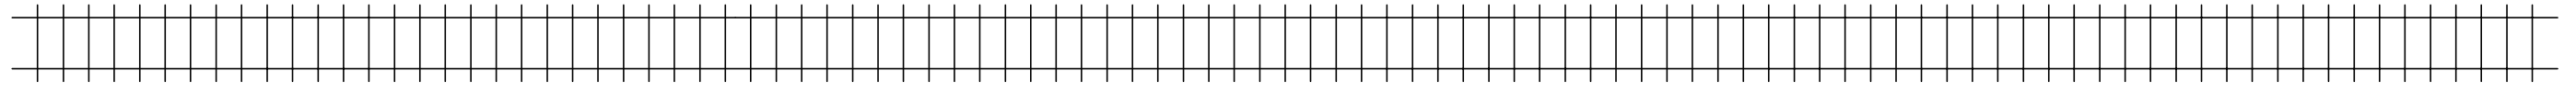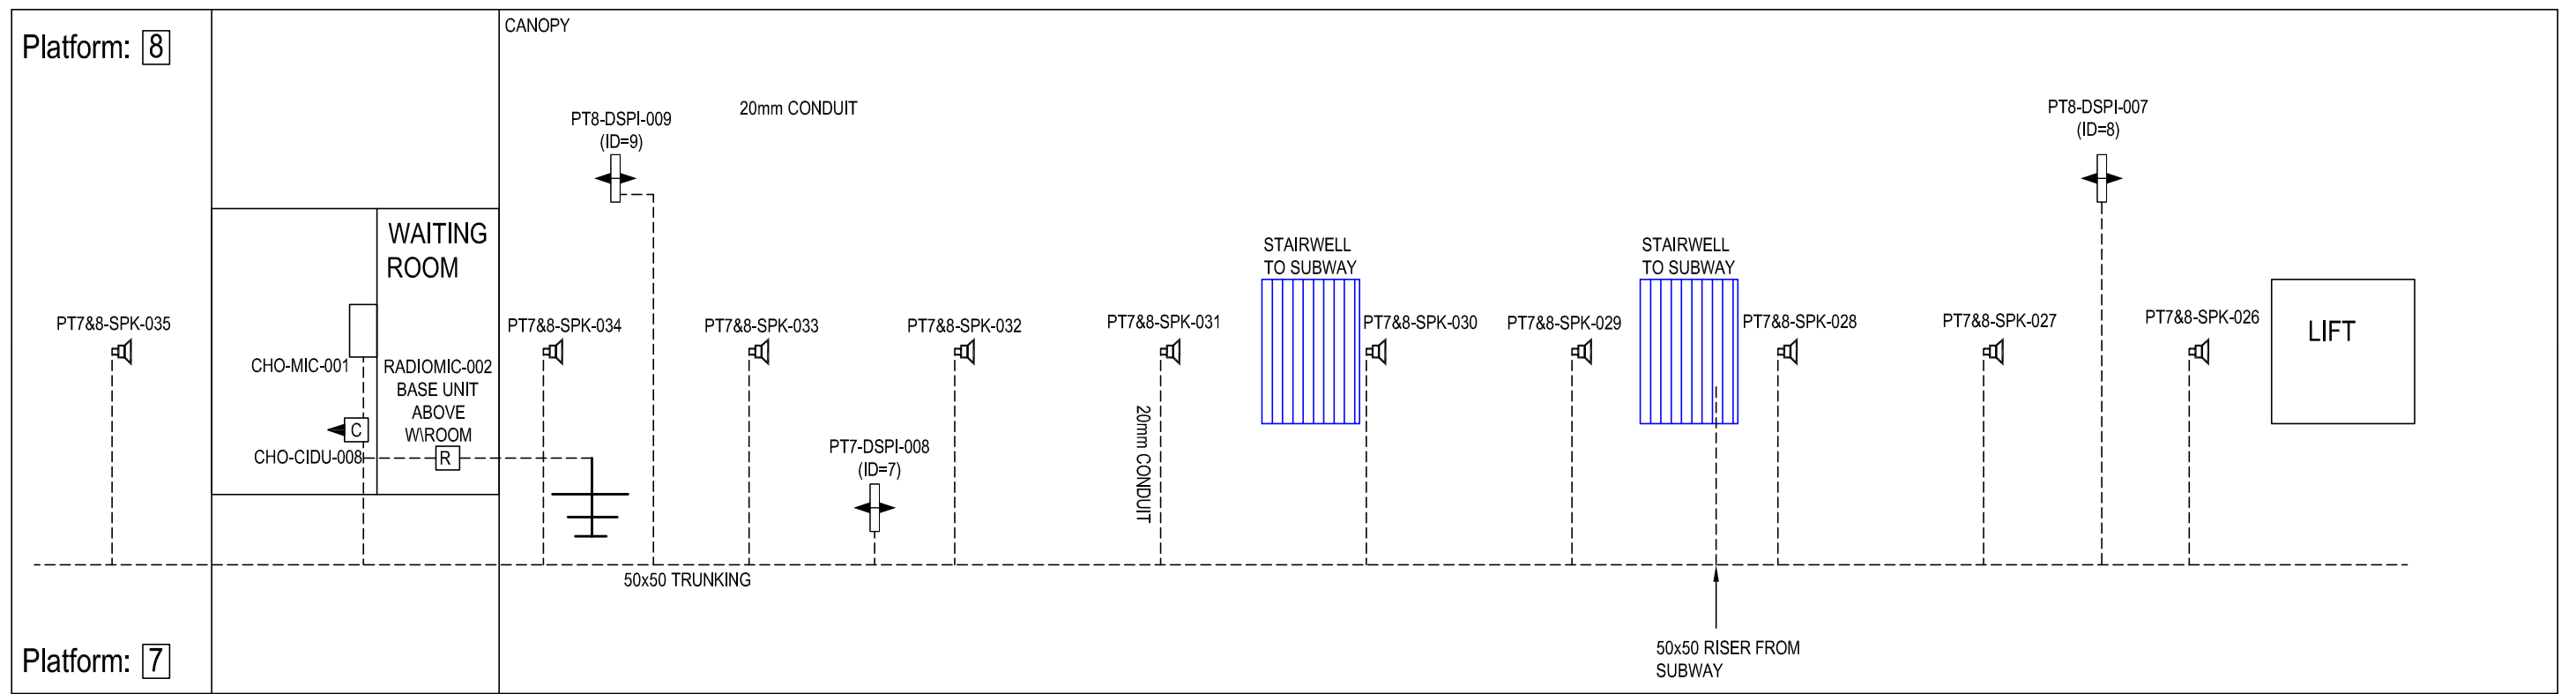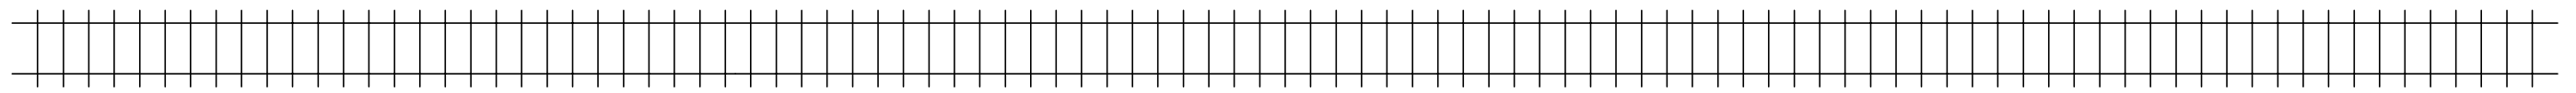

IF IN DOUBT ASK!

Date of Last Modification: 24 June 2003

This Drawing Supersedes Any Previous Drawings

CONSTRUCTION	NAME	J STEVENS	SIGNATURE	J STEVENS	DATE	25-04-2003
	DRAWN BY	J STEVENS	SIGNATURE	J STEVENS	DATE	25-04-2003
	CHECKED BY	T WONG	SIGNATURE	T WONG	DATE	25-04-2003
	APPD BY	A SMITH				
	CONTRACTOR'S Ref:					

AMEY DATEL Project
 Offices
 1st Floor, Platform
 2/3
 Eastleigh Station
 Southampton Road
 Eastleigh
 Hants
 SO50 9FL

COPYRIGHT © AMEY Rail
 All rights reserved. Neither this drawing or any of the information it contains may be copied or communicated to third parties without the written permission of the copyright holder

SITE/PROJECT		SOUTH WEST TRAINS CIS PROJECT	
TITLE		VAUXHALL AS BUILT	
SCALE	DRG No.	ISSUE	SHEET
NTS	SM803-75597	D	5 of 5