


DRG No. SM803-75884


WAN	
CIRCUIT ID	KXIP600418
IP ADDRESS	10.227.36.1

"PLATFORM 1 HP ISDN"	01-590-681824
"PLATFORM 2 HP ISDN"	01-590-681851

All Equipment tags to be prefixed with "WAL-"

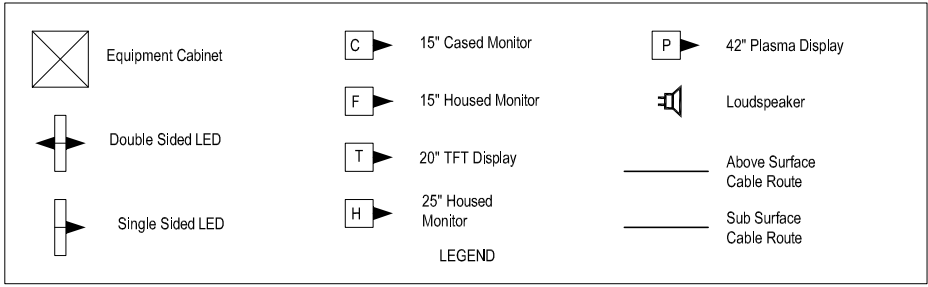

Equipment	Dist Board
CIS RACK	NEW BOARD 2
SO-CIDU-001	GP1 CCT 4
STF-HIDU-002	GP1 CCT 4
TH-HIDU-001	GP1 CCT 4
TH-FIDU-001	GP1 CCT 4
PT1-DSPI-001	GP2 CCT 5
PT1-DSPI-002	GP2 CCT 5
PT2-DSPI-003	GP2 CCT 5

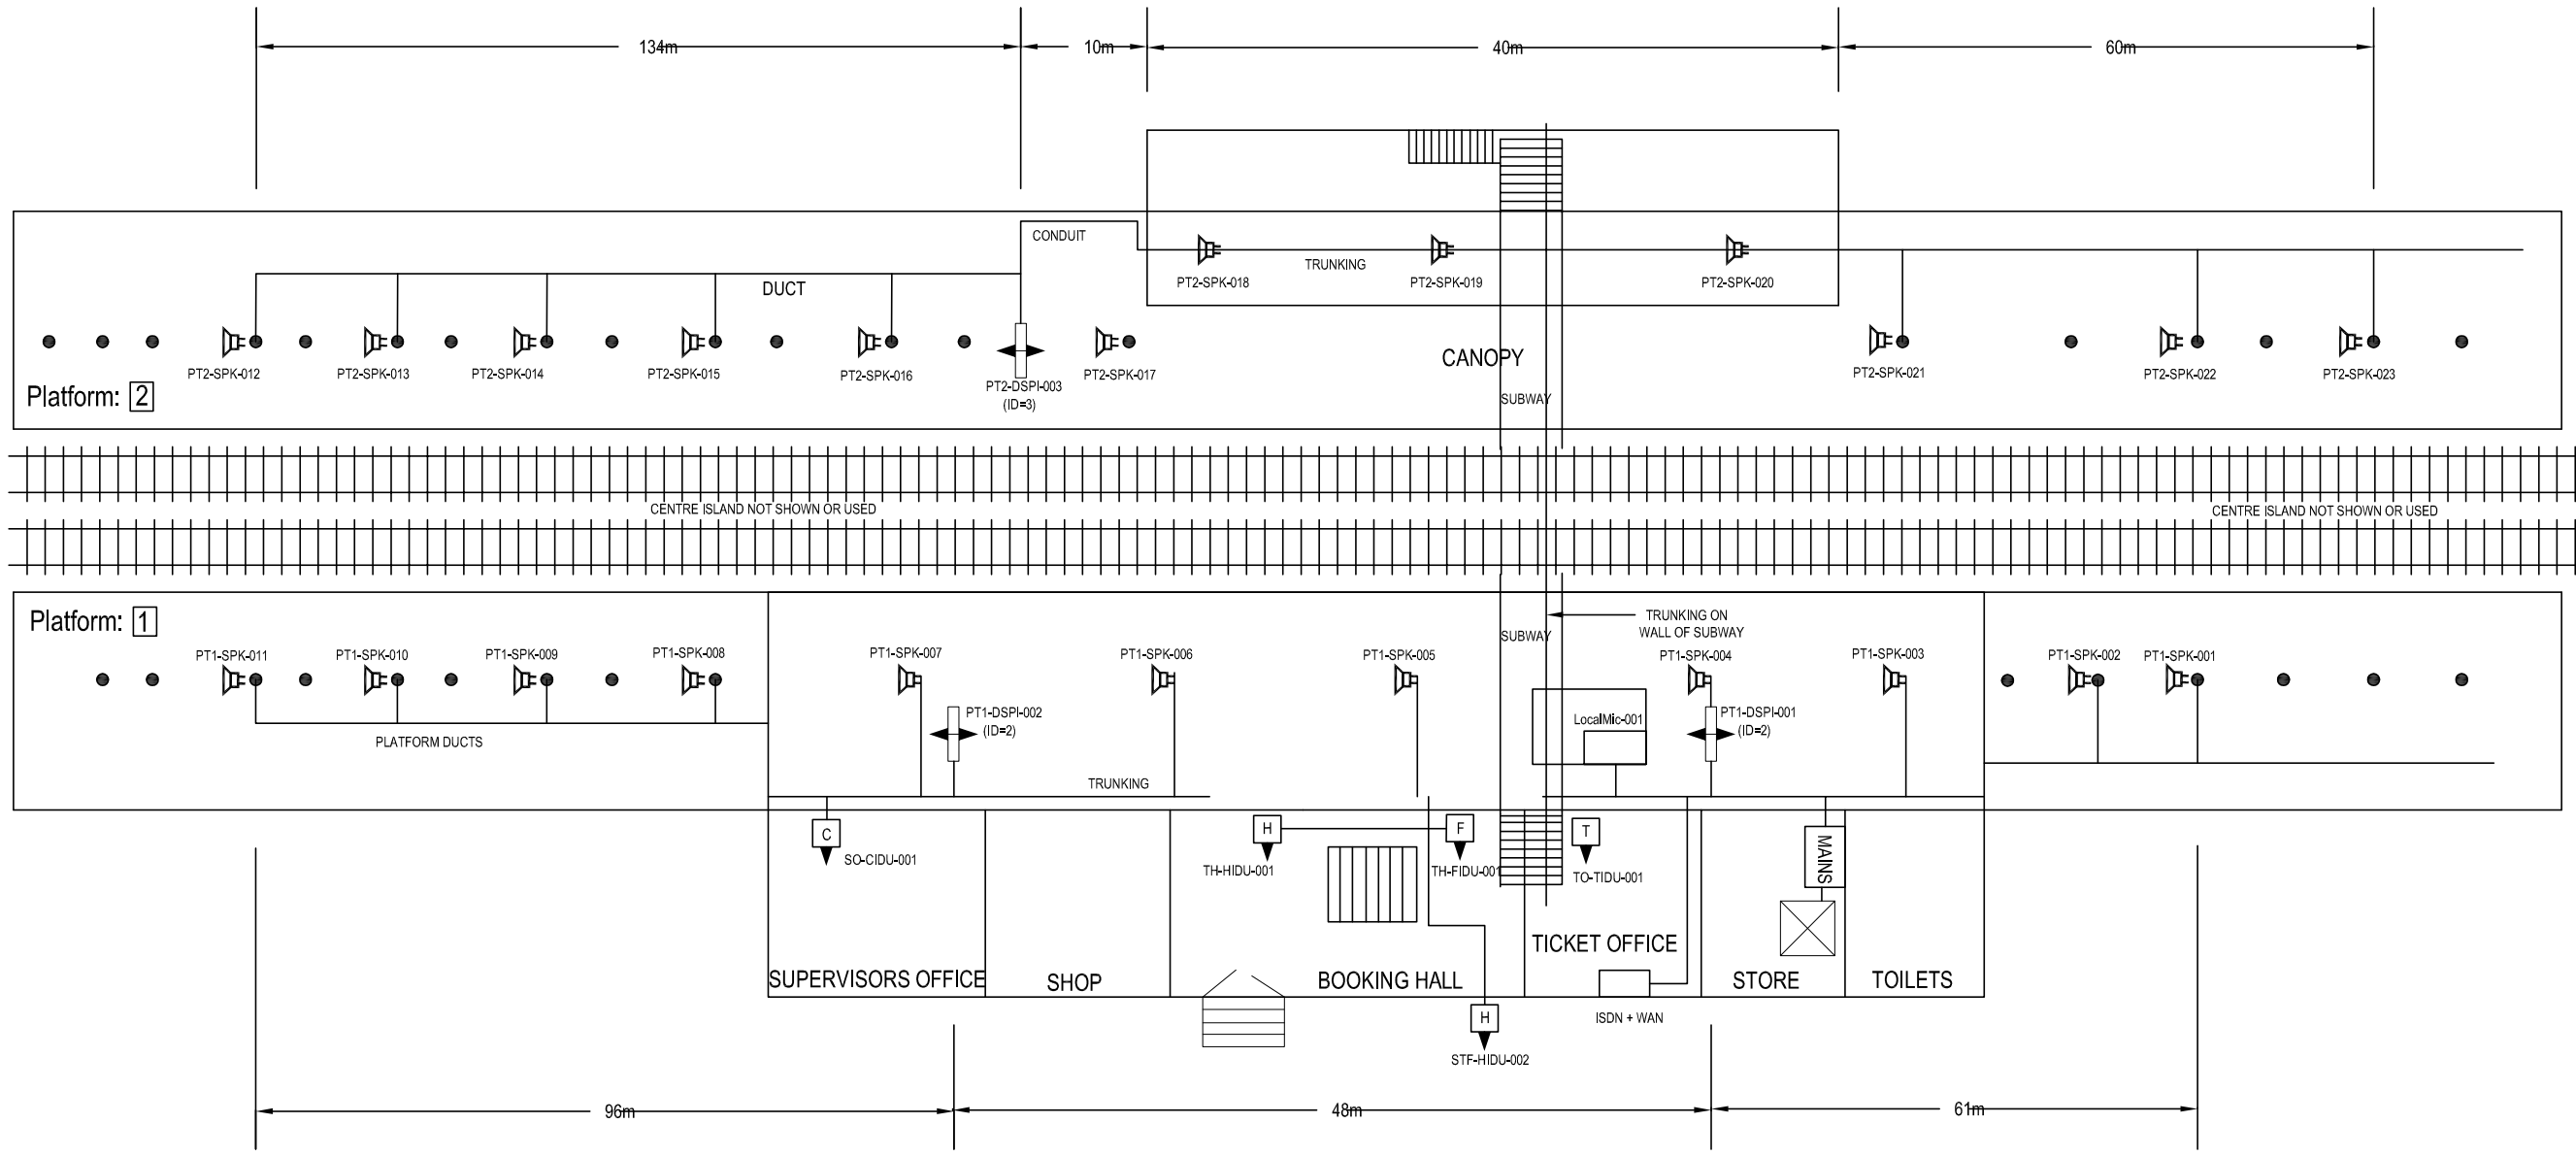

IF IN DOUBT ASK!

MATERIAL	CONSTRUCTION	<table border="1"> <tr> <th>NAME</th> <th>SIGNATURE</th> <th>DATE</th> </tr> <tr> <td>D GADDU</td> <td></td> <td>09-05-2002</td> </tr> <tr> <td>T WONG</td> <td></td> <td></td> </tr> <tr> <td>A SMITH</td> <td></td> <td></td> </tr> </table>	NAME	SIGNATURE	DATE	D GADDU		09-05-2002	T WONG			A SMITH			<p>AMEY DATEL Project Offices 1st Floor, Platform 2/3 Eastleigh Station Southampton Road Eastleigh Hants SO50 9FL</p>	SITE/PROJECT SOUTH WEST TRAINS CIS PROJECT	
		NAME	SIGNATURE	DATE													
D GADDU		09-05-2002															
T WONG																	
A SMITH																	
FINISH			TITLE WALTON ON THAMES AS BUILT														
		CAD Ref:	<p>COPYRIGHT © AMEY Rail All rights reserved. Neither this drawing or any of the information it contains may be copied or communicated to third parties without the written permission of the copyright holder</p>	SCALE NTS	DRG No. SM803-75884	ISSUE C	SHEET 1 of 1										
		CONTRACTOR'S Ref:															