



WAN	
CIRCUIT ID	KXIP600419
IP ADDRESS	10.227.221.1

"PLATFORM 1 HP ISDN"
01-483-812133
"PLATFORM 2 HP ISDN"
01-483-812134

All Equipment tags to be prefixed with "WAN-"

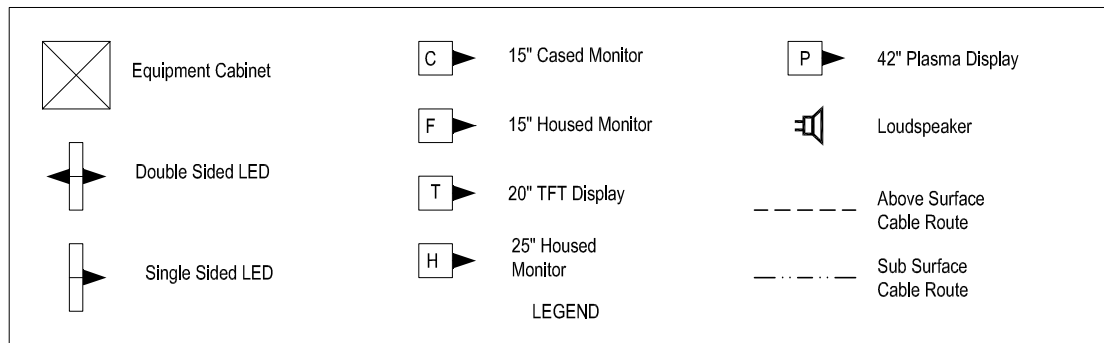


Equipment	Dist Board	
CIS RACK	CIS DB CCT1	20A
PT2-DSPI-001	DB2 CCT3	10A
PT1-DSPI-002	DB2 CCT4	10A

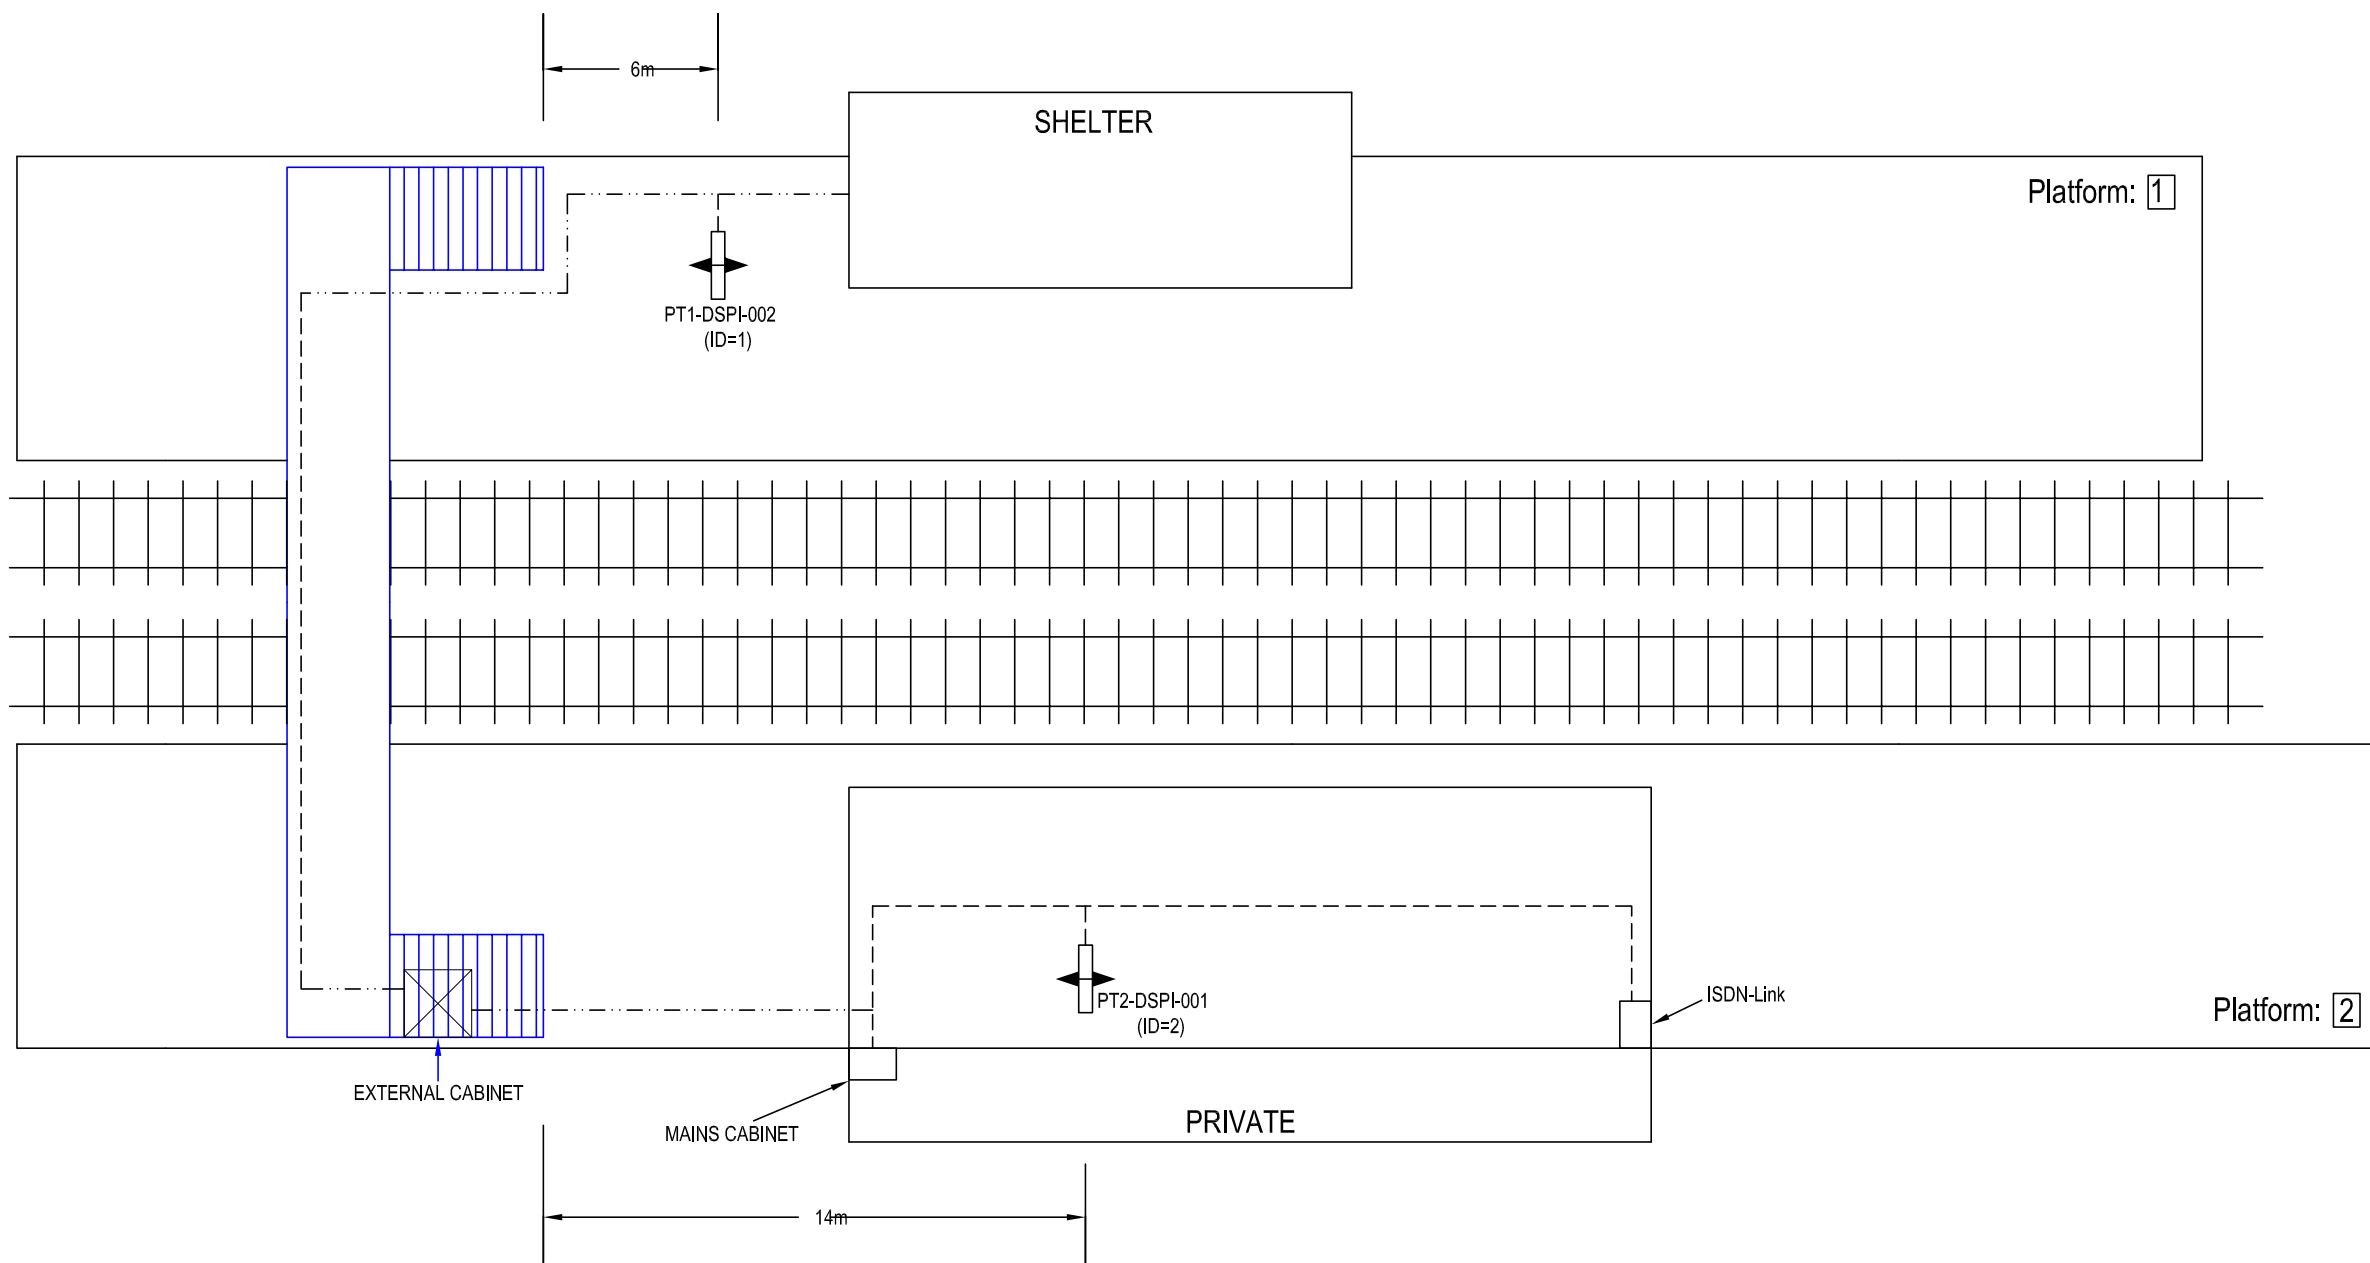

IF IN DOUBT ASK!

MATERIAL	CONSTRUCTION		NAME	SIGNATURE	DATE
FINISH			DRAWN BY	D GADDU	
			CHECKED BY	T WONG	
			APPD BY	A SMITH	
			CAD Ref:		
			CONTRACTOR'S Ref:		

AMEY DATEL Project  
Offices  
1st Floor, Platform  
2/3  
Eastleigh Station  
Southampton Road  
Eastleigh  
Hants  
SO50 9FL

COPYRIGHT © AMEY Rail  
All rights reserved. Neither this drawing or any of the information  
it contains may be copied or communicated to third parties  
without the written permission of the copyright holder

SITE/PROJECT		SOUTH WEST TRAINS CIS PROJECT	
TITLE		WANBOROUGH AS BUILT	
SCALE	DRG No.	ISSUE	SHEET
NTS	SM803-75639	B	1 of 1