



WAN	
CIRCUIT ID	KXIP600423
IP ADDRESS	10.227.223.1

"PLATFORM 1 HP ISDN"	01-932-355524
"PLATFORM 2 HP ISDN"	01-932-336031

All Equipment tags to be prefixed with "WBY-"

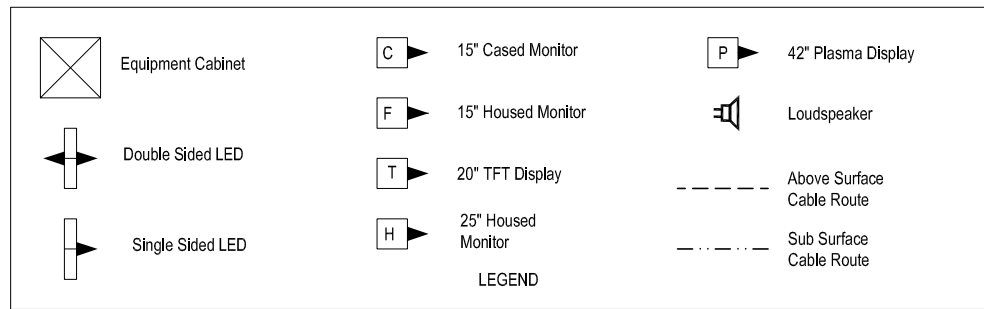

Equipment	Dist Board
EXISTING SUPPLIES USED	

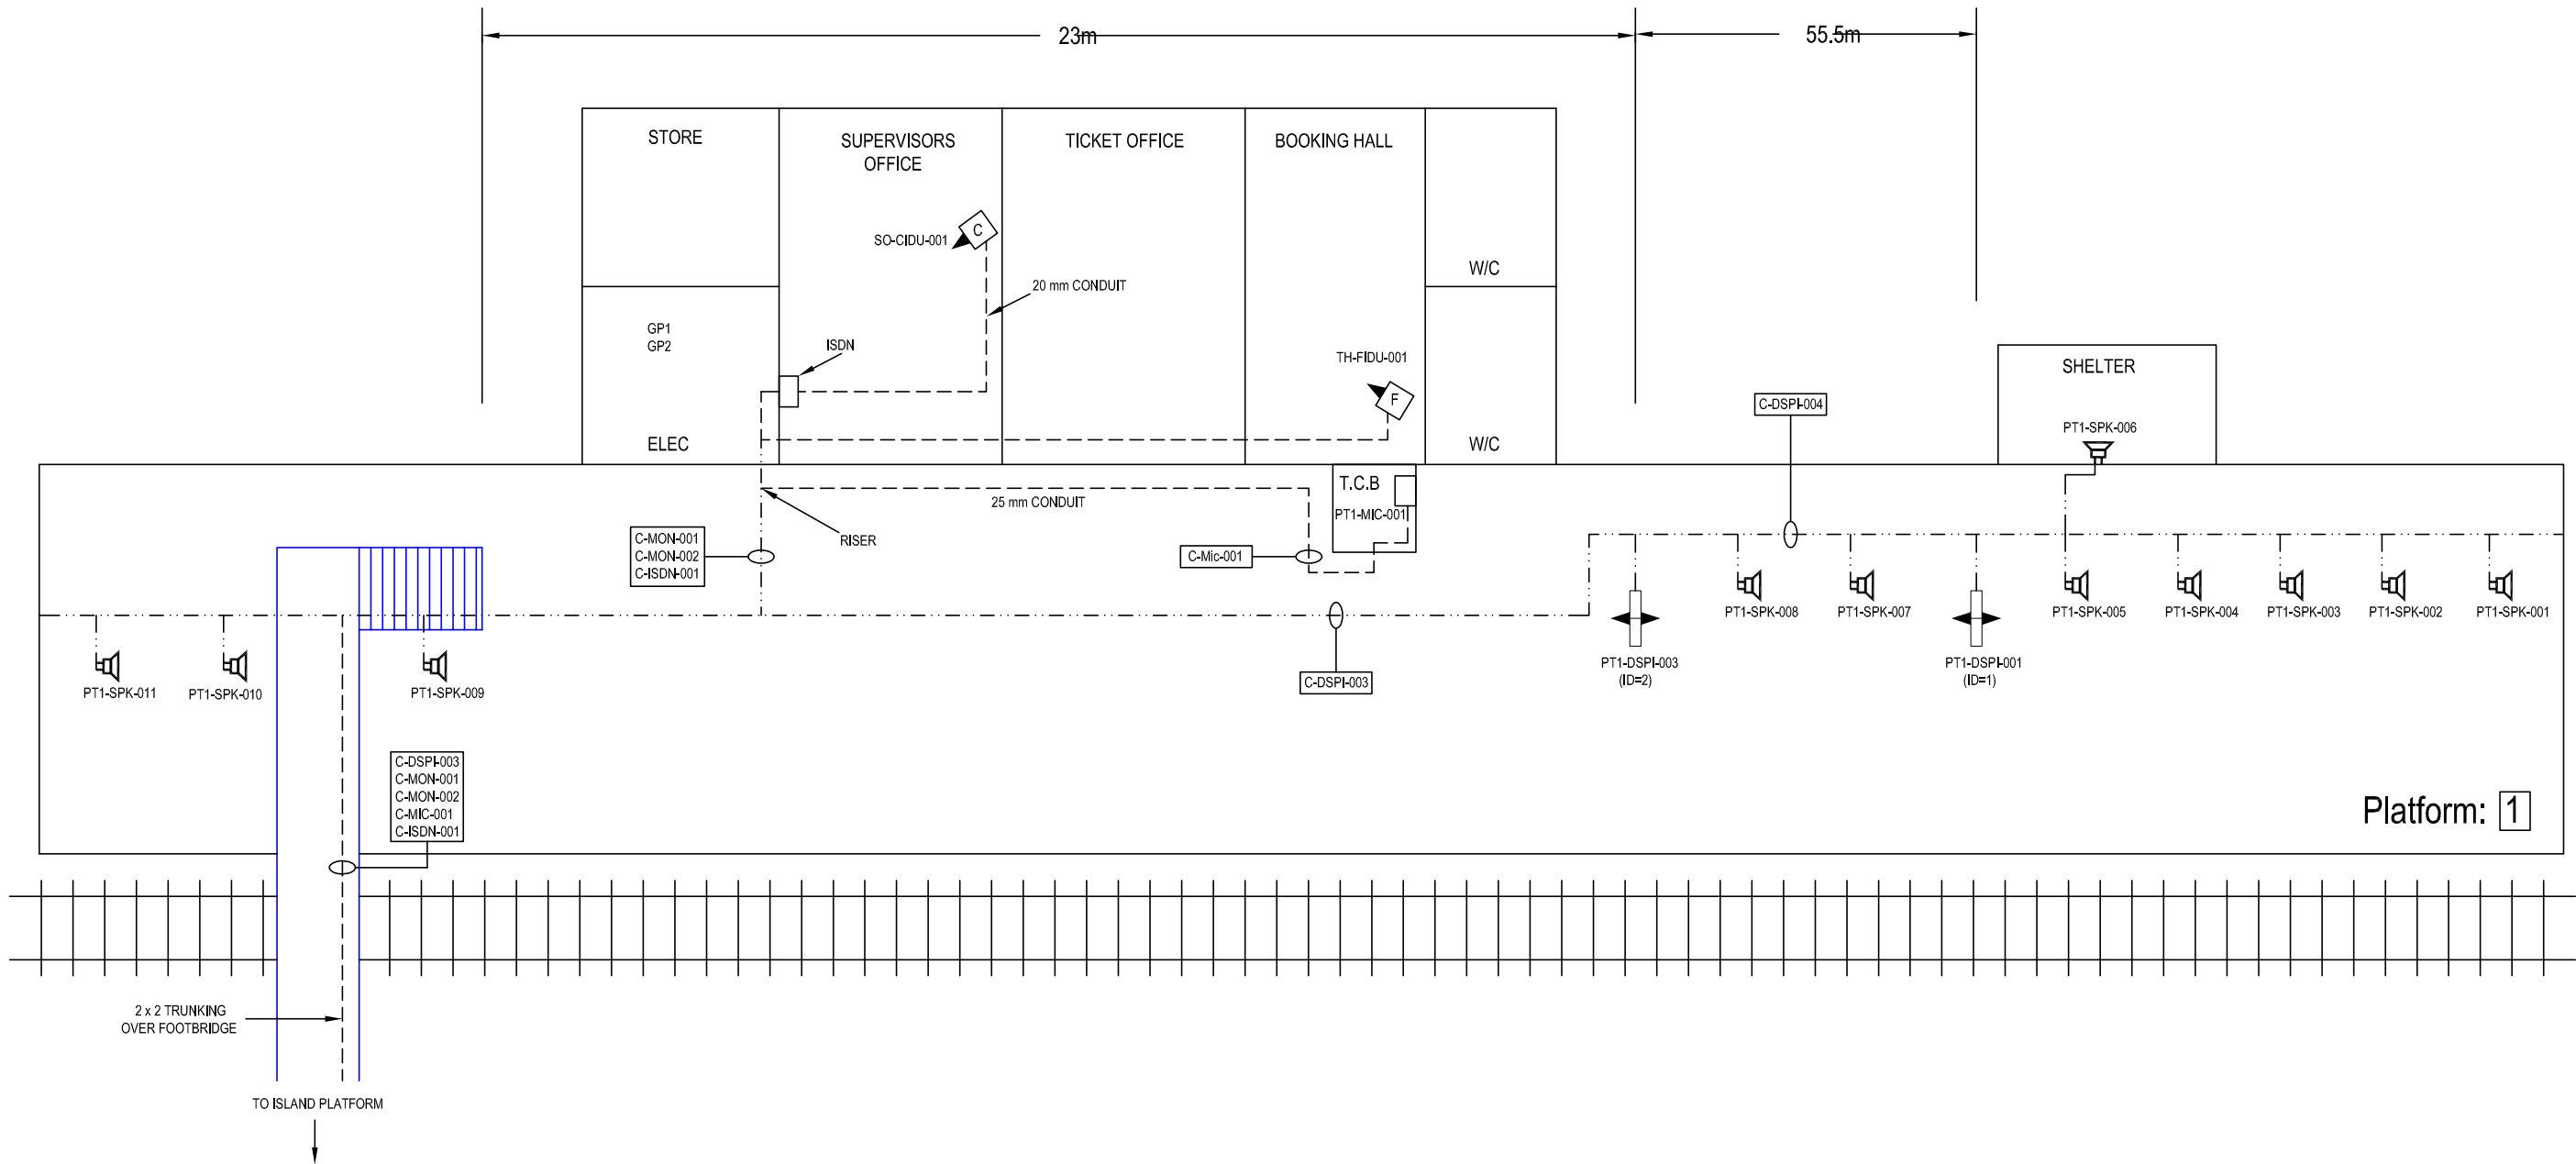


IF IN DOUBT ASK!

MATERIAL	CONSTRUCTION	DRAWN BY	D GADDU	SIGNATURE		AMEY DATEL Project Offices 1st Floor, Platform 2/3 Eastleigh Station Southampton Road Eastleigh Hants SO50 9FL	SITE/PROJECT		SOUTH WEST TRAINS CIS PROJECT	
		CHECKED BY	T WONG	DATE	28-05-2002		TITLE		WEST BYFLEET AS BUILT	
FINISH		APPD BY	A SMITH				SCALE	DRG No.	ISSUE	SHEET
		APPD BY					NTS	SM803-75684	B	1 of 2
		CAD Ref:				COPYRIGHT © AMEY Rail All rights reserved. Neither this drawing or any of the information it contains may be copied or communicated to third parties without the written permission of the copyright holder				
		CONTRACTOR'S Ref:								



WAN	
CIRCUIT ID	KXIP600423
IP ADDRESS	10.227.223.1

"PLATFORM 1 HP ISDN"
01-932-355524
"PLATFORM 2 HP ISDN"
01-932-336031

All Equipment tags to be prefixed with "WBY-"

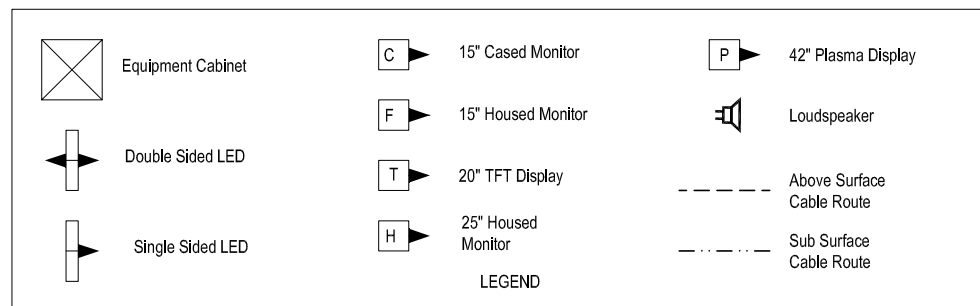

Equipment	Dist Board	
EXISTING SUPPLIES USED		

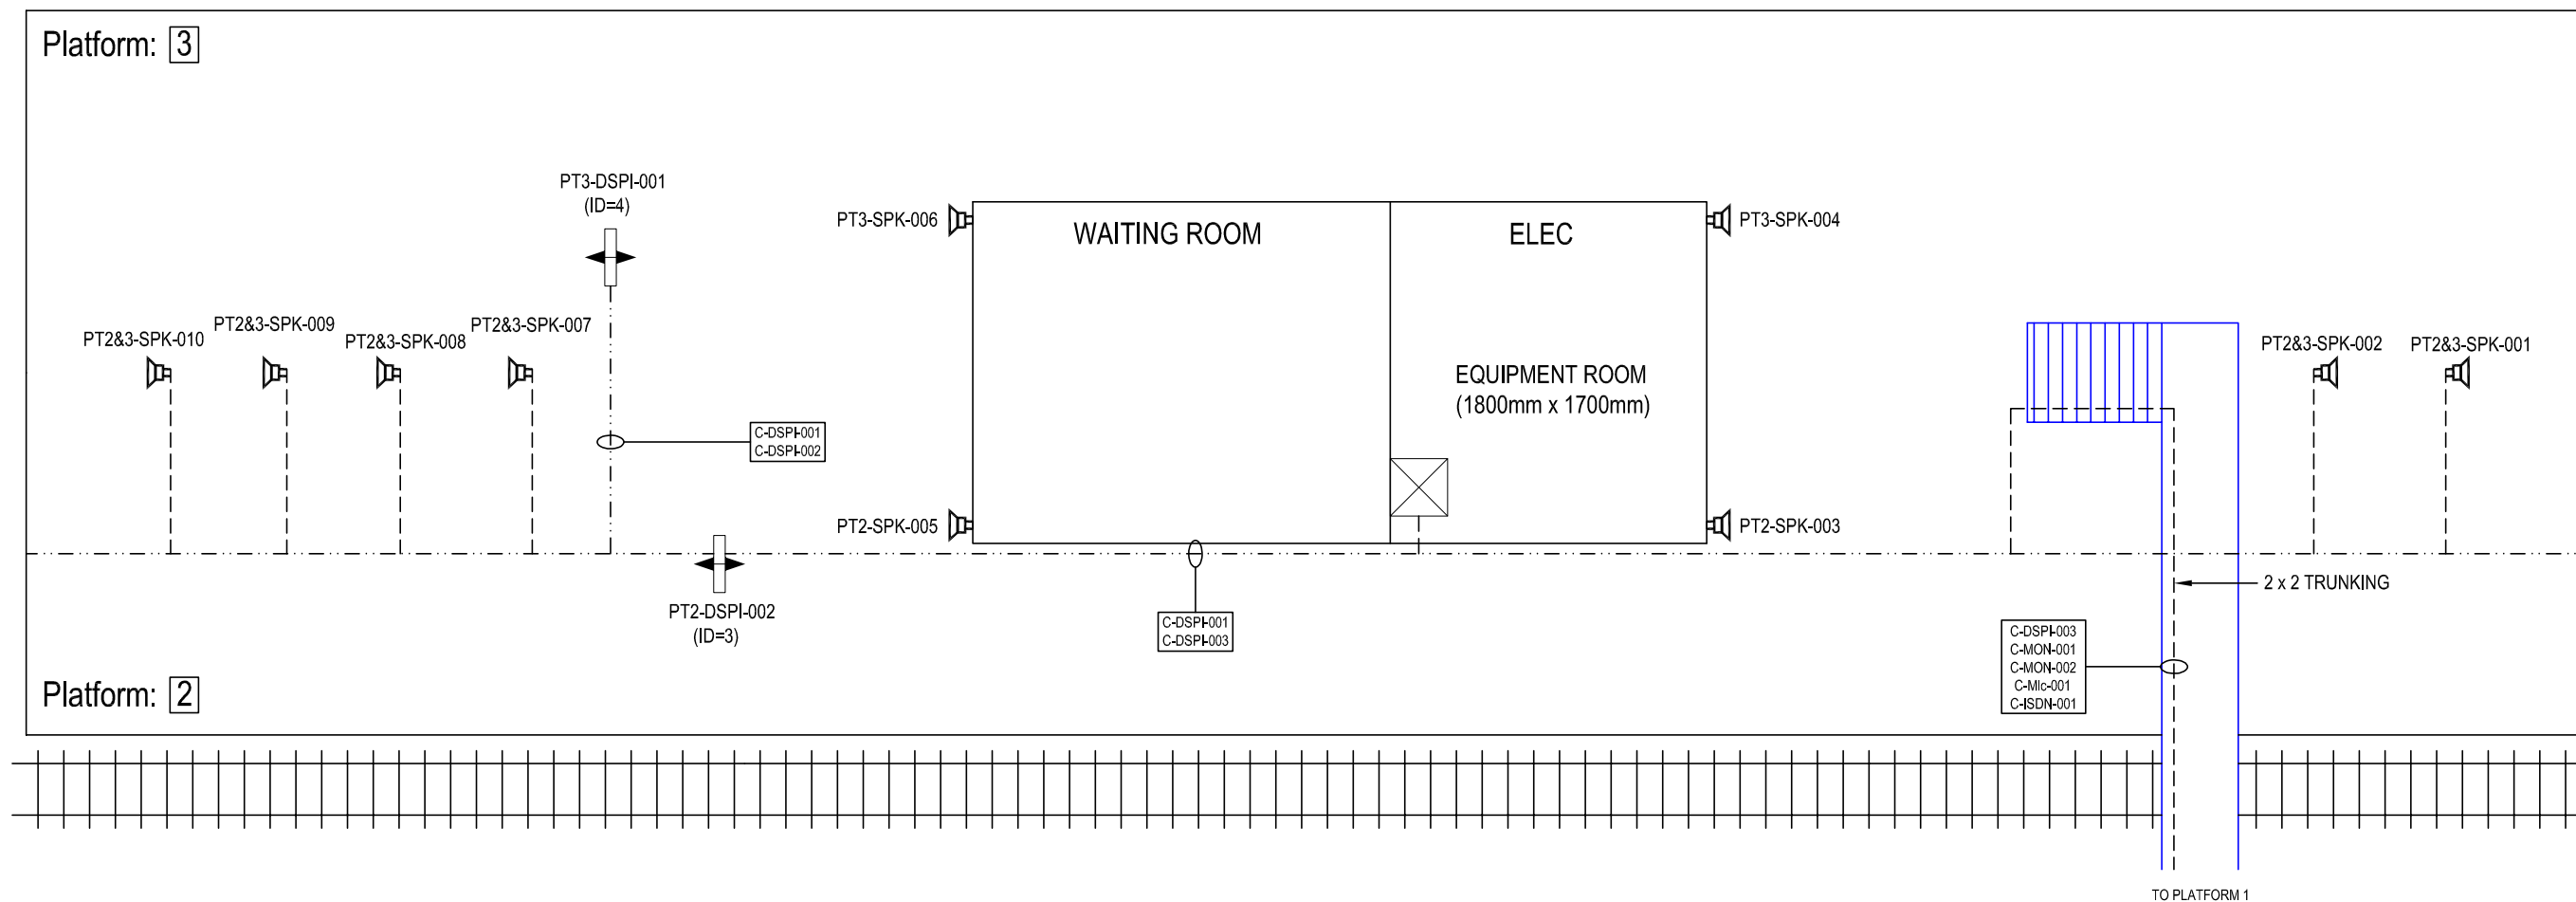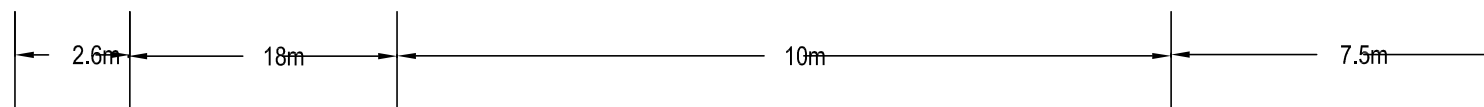

IF IN DOUBT ASK!

MATERIAL	CONSTRUCTION	<table border="1"> <tr> <th>NAME</th> <th>SIGNATURE</th> <th>DATE</th> </tr> <tr> <td>D GADDU</td> <td></td> <td>28-05-2002</td> </tr> <tr> <td>T WONG</td> <td></td> <td></td> </tr> <tr> <td>A SMITH</td> <td></td> <td></td> </tr> </table>	NAME	SIGNATURE	DATE	D GADDU		28-05-2002	T WONG			A SMITH			<p>AMEY DATEL Project Offices 1st Floor, Platform 2/3 Eastleigh Station Southampton Road Eastleigh Hants SO50 9FL</p>	SITE/PROJECT		SOUTH WEST TRAINS CIS PROJECT	
		NAME	SIGNATURE	DATE															
D GADDU		28-05-2002																	
T WONG																			
A SMITH																			
FINISH			TITLE		WEST BYFLEET AS BUILT														
		CAD Ref:	<p>COPYRIGHT © AMEY Rail All rights reserved. Neither this drawing or any of the information it contains may be copied or communicated to third parties without the written permission of the copyright holder</p>	SCALE	DRG No.	ISSUE	SHEET												
		CONTRACTOR'S Ref:		NTS	SM803-75684	B	2 of 2												